# 04-01747

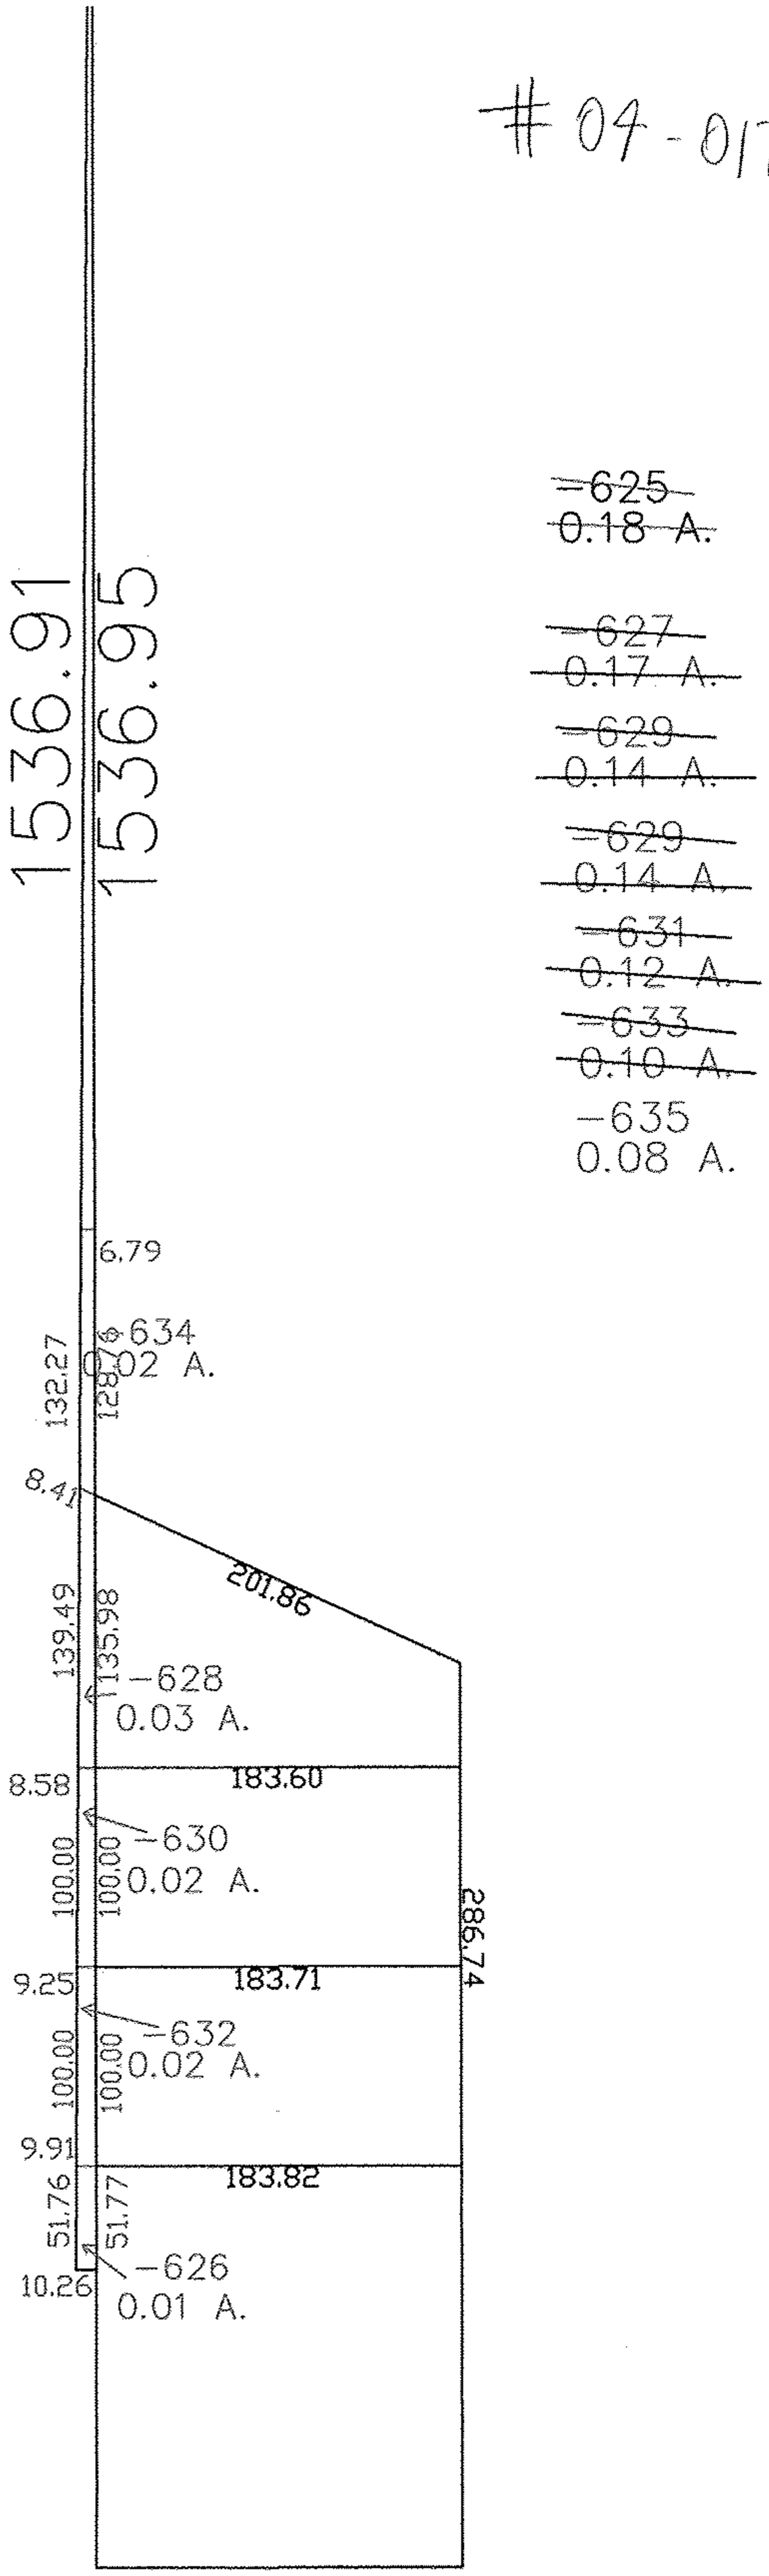
~~625~~
~~0.18 A.~~
~~627~~
~~0.17 A.~~
~~629~~
~~0.14 A.~~
~~629~~
~~0.14 A.~~
~~631~~
~~0.12 A.~~
~~633~~
~~0.10 A.~~
635
0.08 A.
1536.91
1536.95
6.79
132.27
128.76
634
0.02 A.
8.41
201.86
139.49
135.98
628
0.03 A.
8.58
183.60
630
0.02 A.
100.00
100.00
286.74
9.25
183.71
632
0.02 A.
100.00
100.00
9.91
183.82
51.76
51.77
626
0.01 A.
10.26