RASTER

PARENT PARCEL: 04-00-013-000-449,-450,-452,-454

CHILD PARCEL: 04-00-013-000-515 THRU -519

STARTING POINT: INTERSECTION OF C/L OF S.R.83 AND C/L OF SOUTH PARK DR.

NO. 01768

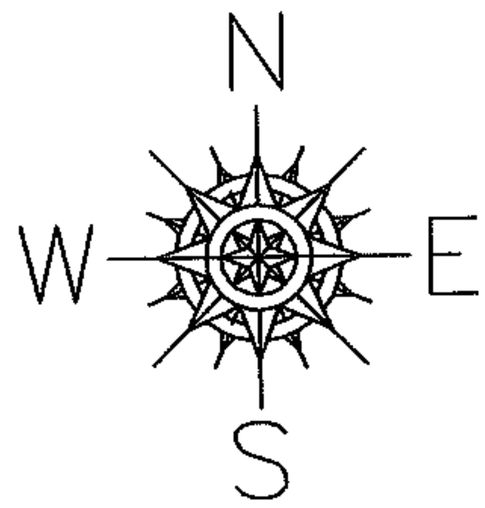

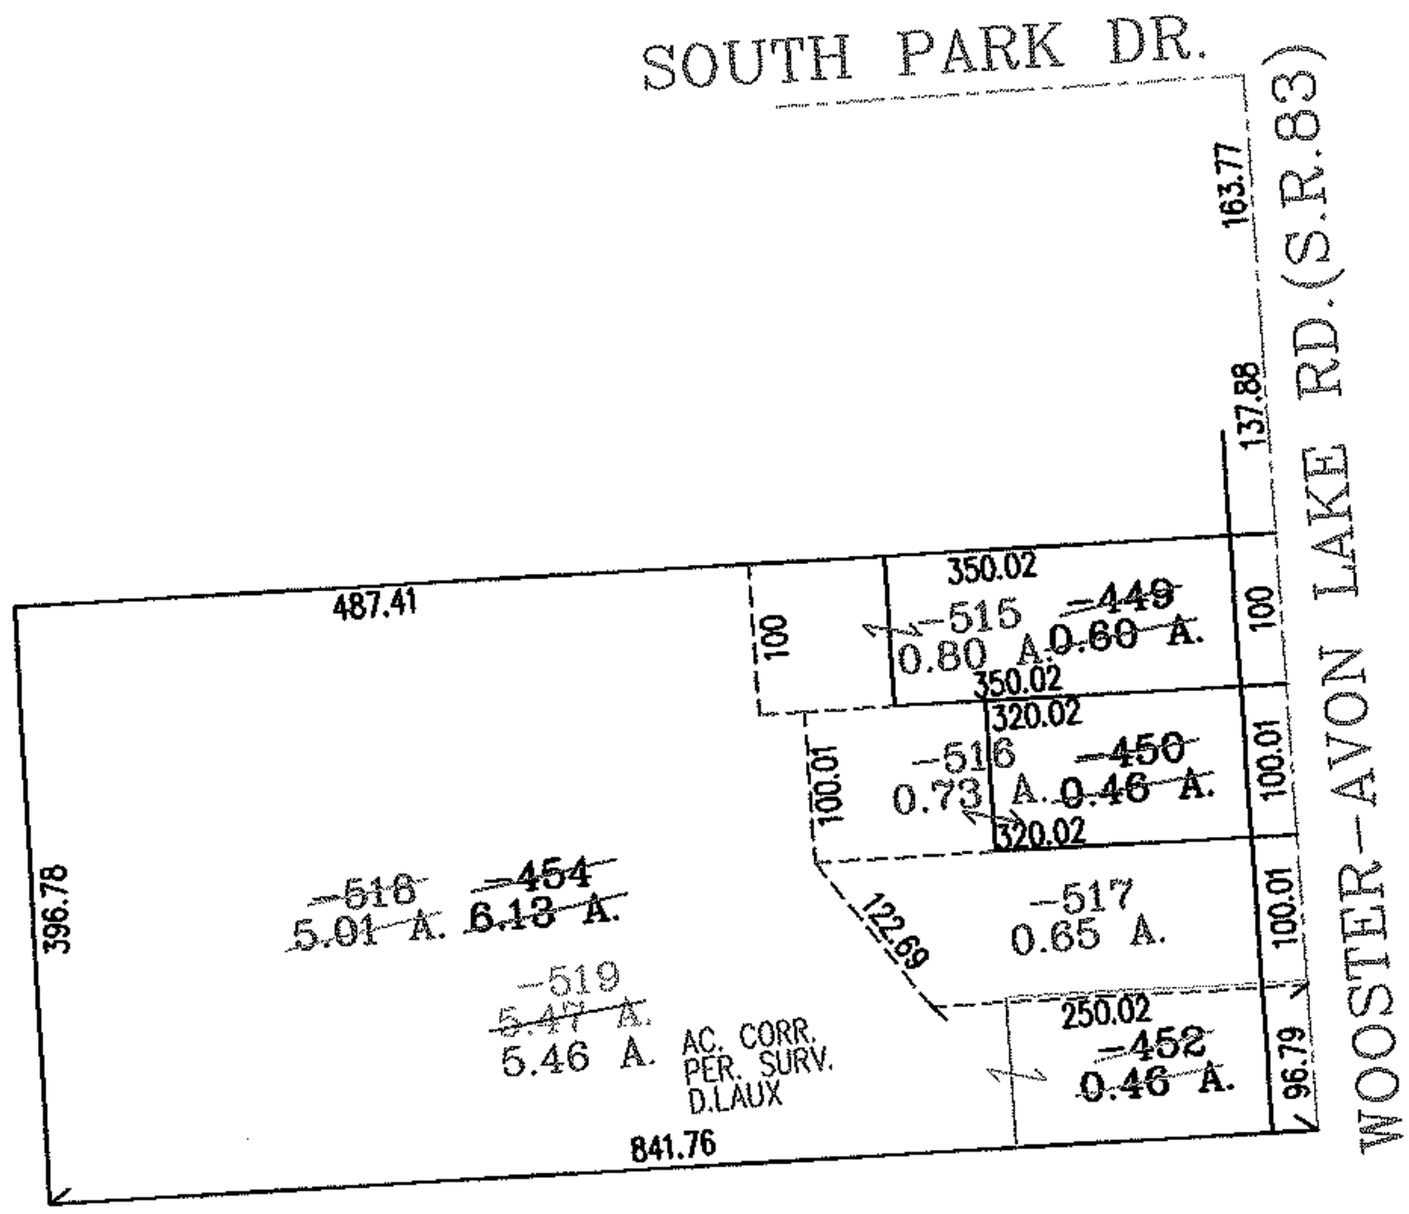

PRIOR INSTRUMENT: 20020814581 20020814583

SPLITS/DEEDS PROCESSED

LORAIN COUNTY TAX MAP DEPARTMENT
226 MIDDLE AVE. ELYRIA, OHIO

SURVEYED BY: DANIEL LAUX

CLOSURE: .01:10,000

MAP PAGE(S): 4-00-013-B

APPROVED BY: RRM DATE: 10-12-04

SCALE: 1"= 200 PRIOR INSTRUMENT: SEE ABOVE