RASTER

PARENT PARCEL: 12-00-080-000-003 THRU -005
CHILD PARCEL: 12-00-080-000-044 THRU -047
STARTING POINT: NORTHWEST CORNER OF O.L.80

NO. 01774

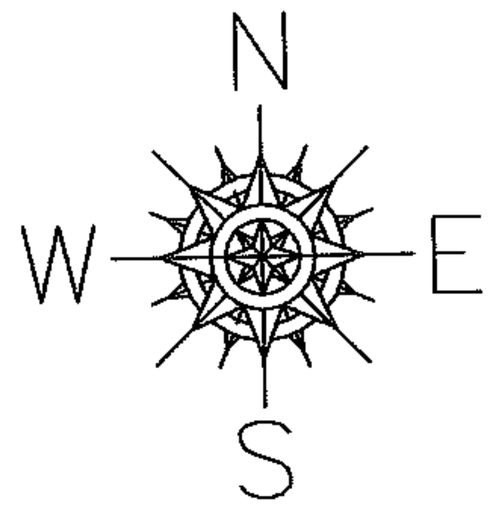

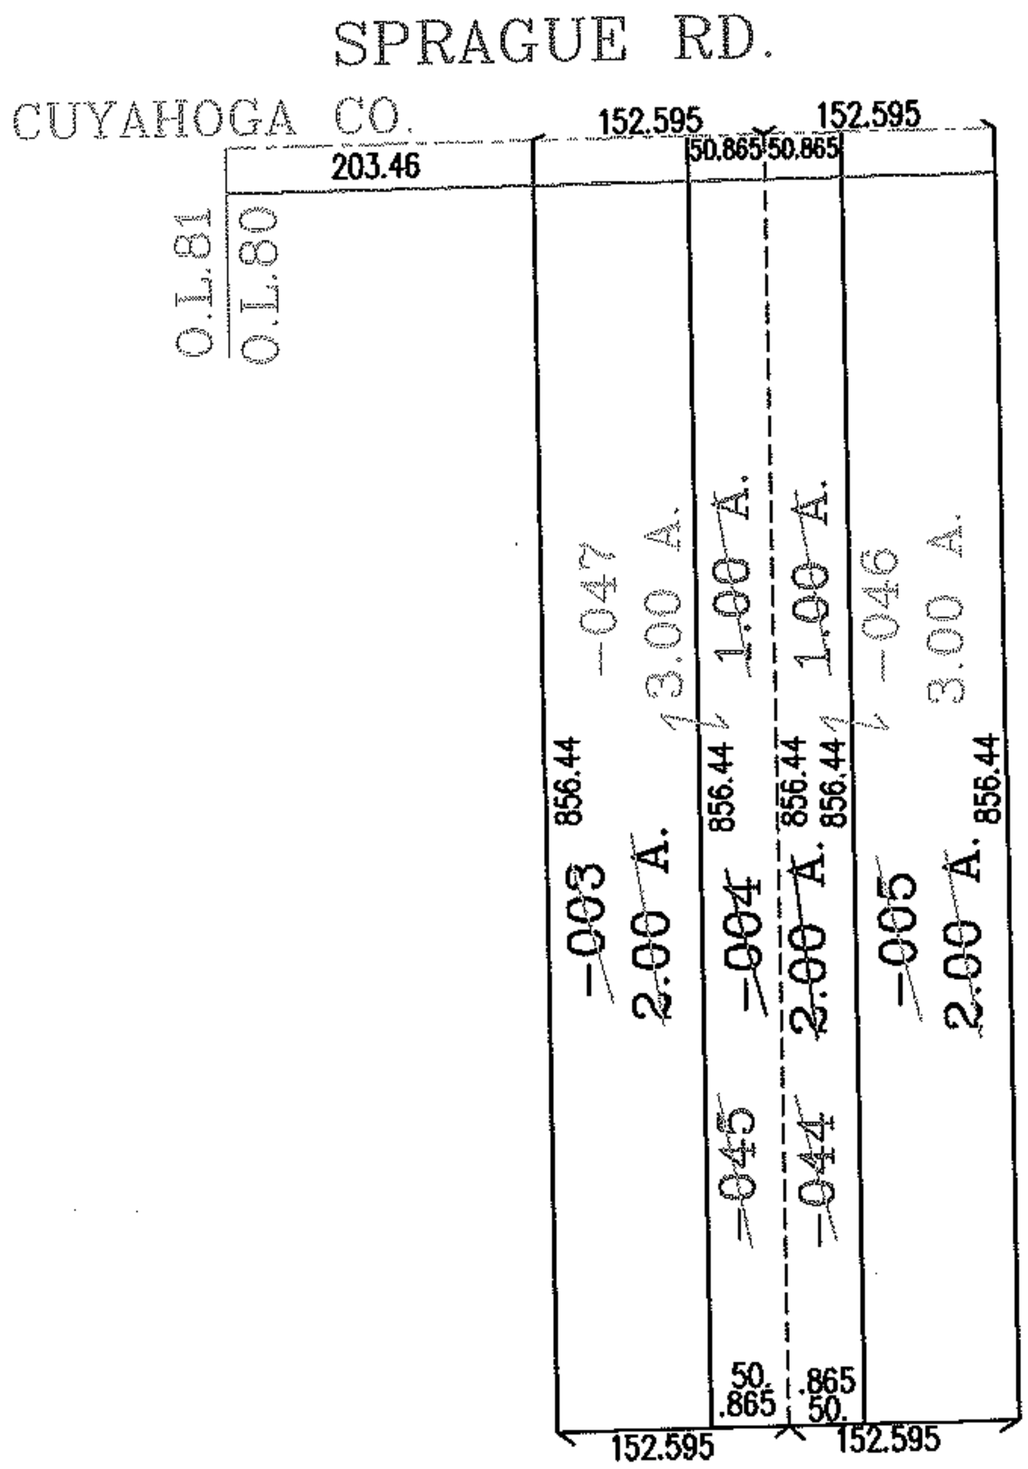

SPLITS/DEEDS PROCESSED
LORAIN COUNTY TAX MAP DEPARTMENT
226 MIDDLE AVE. ELYRIA, OHIO

SURVEYED BY: JAMES B. ROOT
CLOSURE: .00:10.000
MAP PAGE(S): 12-00-080-A
APPROVED BY: RRM DATE: 10-12-04
SCALE: 1"= 200 PRIOR INSTRUMENT: DV 918/419