PARENT PARCEL: 04-00-015-101-129, -130

CHILD PARCEL: 04-00-015-101-131 THRU -134

STARTING POINT: CENTERLINE OF GARDEN DR. & DETROIT RD.

NO. 01790

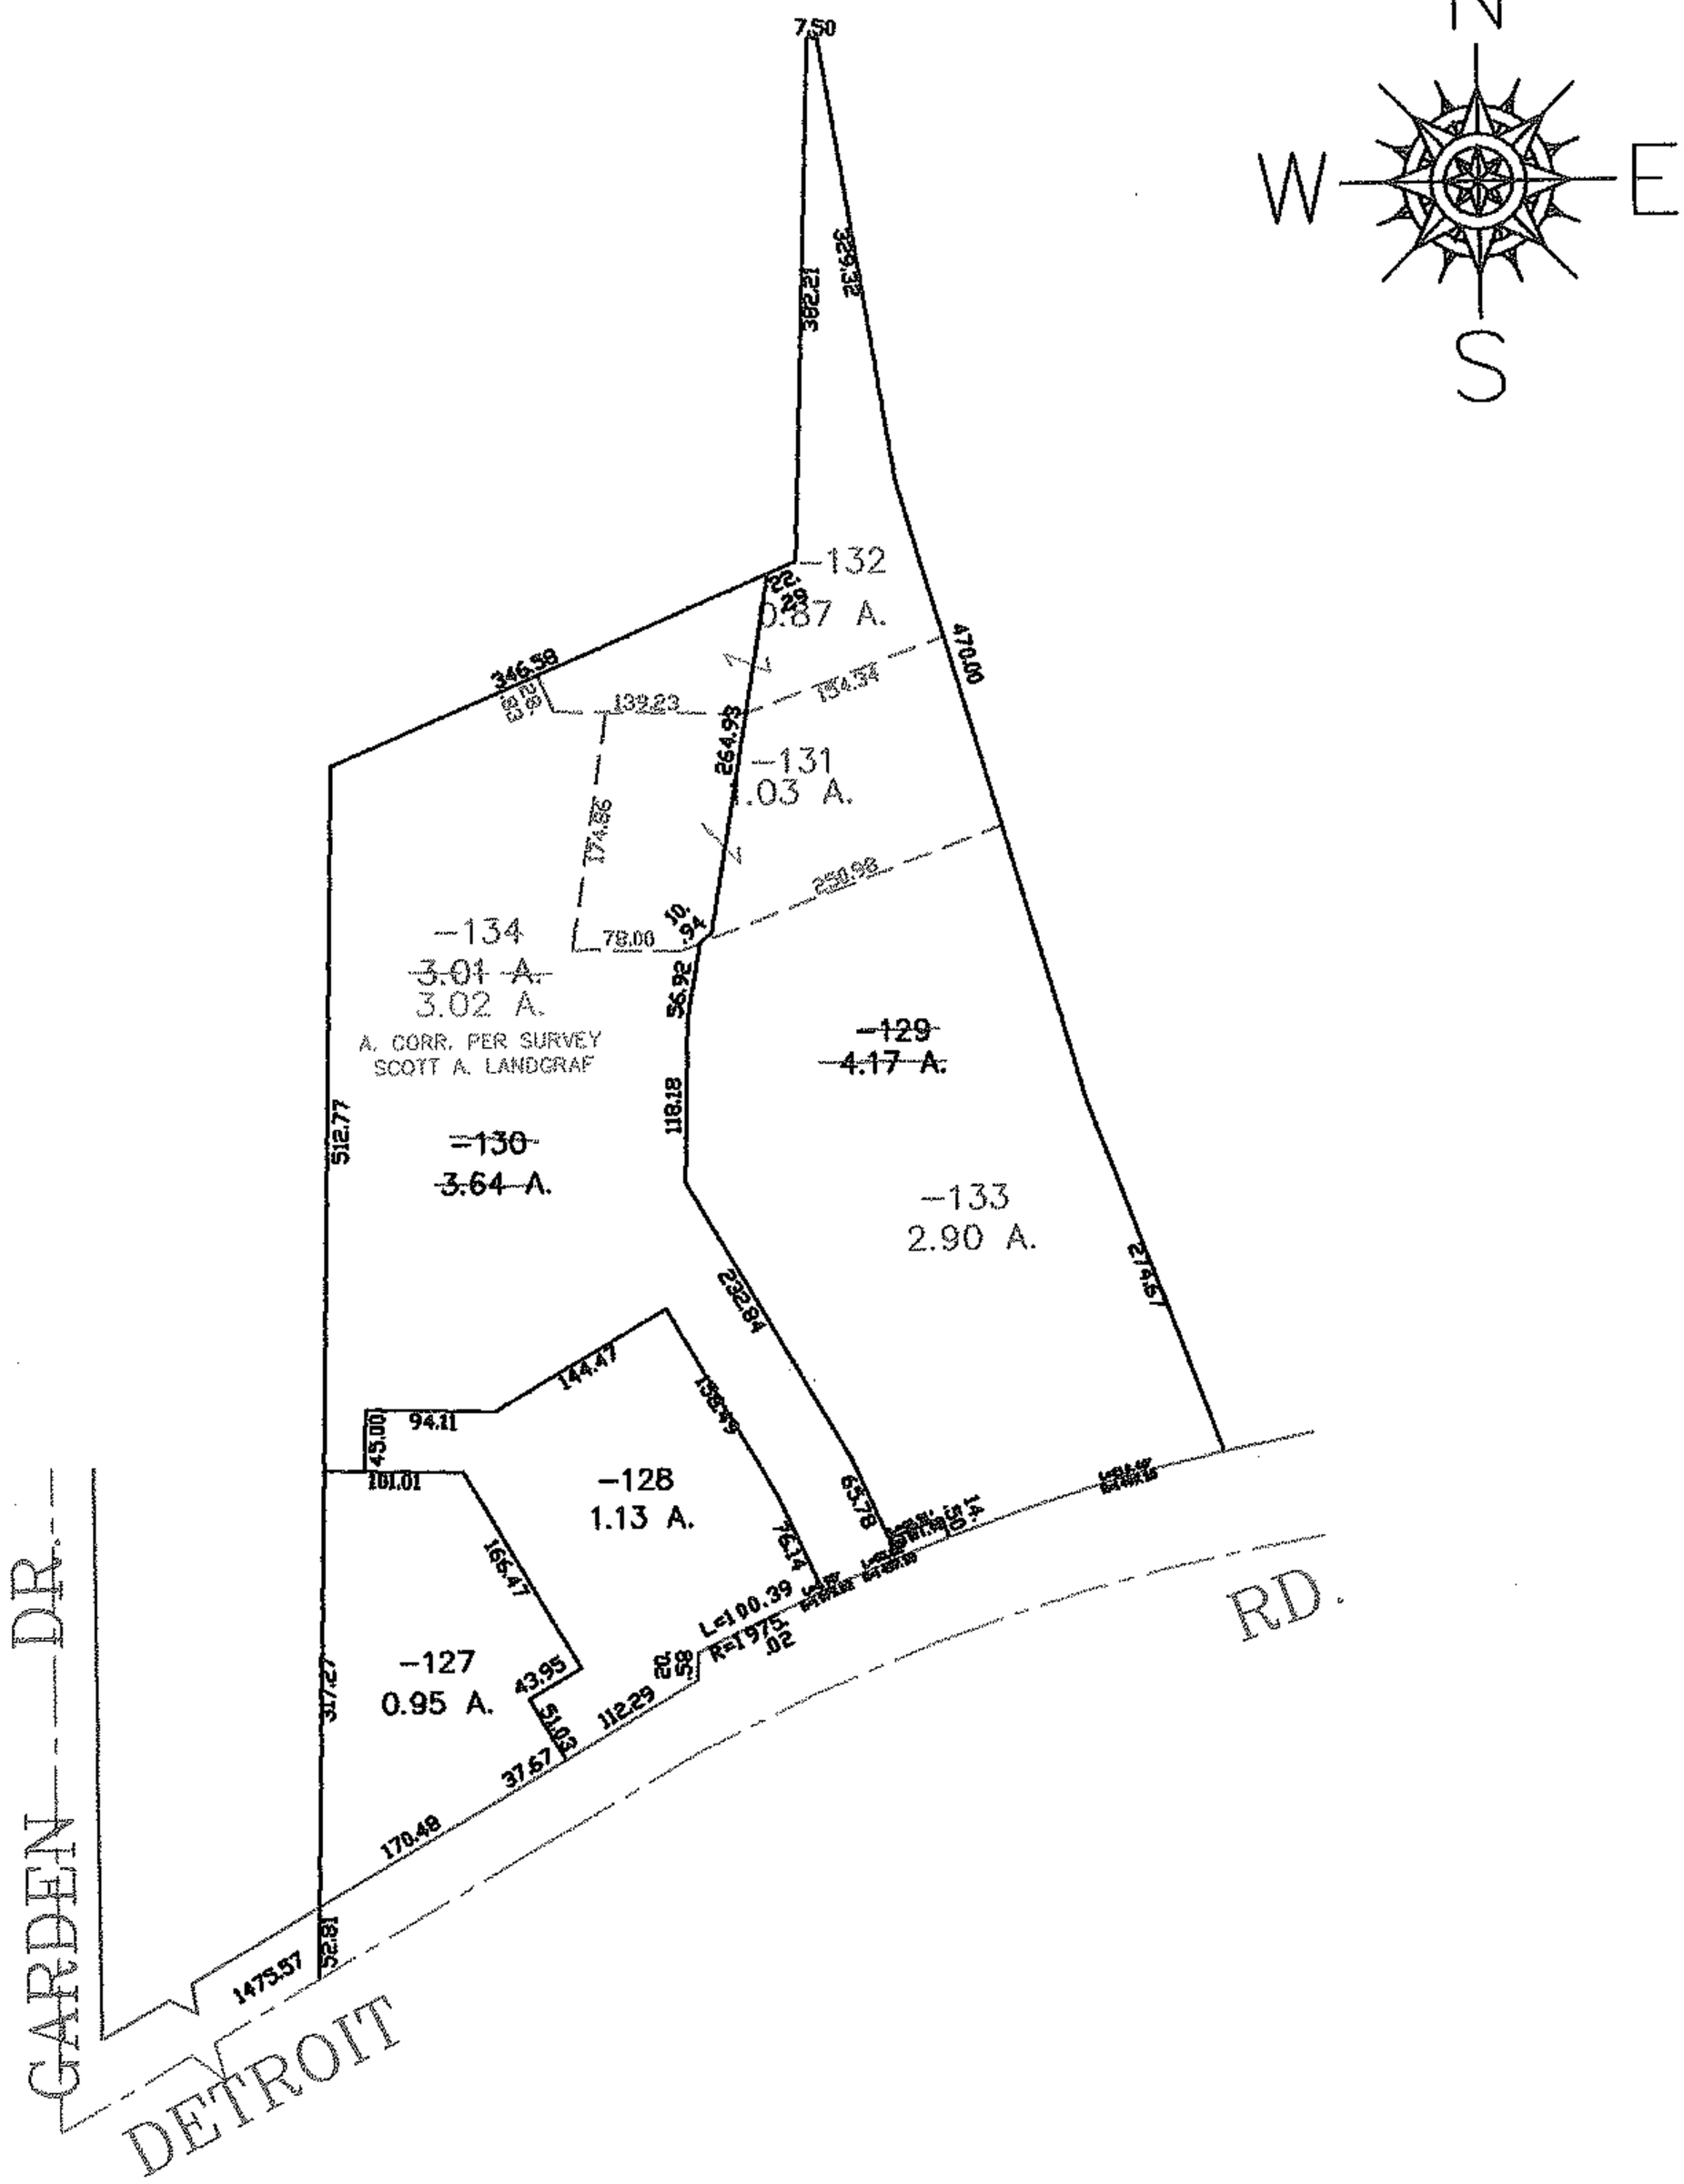

SPLITS/DEEDS PROCESSED

LORAIN COUNTY TAX MAP DEPARTMENT
226 MIDDLE AVE. ELYRIA, OHIO

SURVEYED BY: SCOTT A. LANDGRAF

CLOSURE: 0.00 : 10,000

MAP PAGE(S): 04-00-015-B

APPROVED BY: JAH DATE: 11-15-04

SCALE: 1"= 200 PRIOR INSTRUMENT: 20030945516