PARENT PARCEL: 10-00-025-101-004

CHILD PARCEL:

STARTING POINT: ON C/L OF INDIAN HOLLOW RD. AT SOUTHEAST CORNER OF S/L 11 IN HOLLOW RUN SUB.

18-04001-A

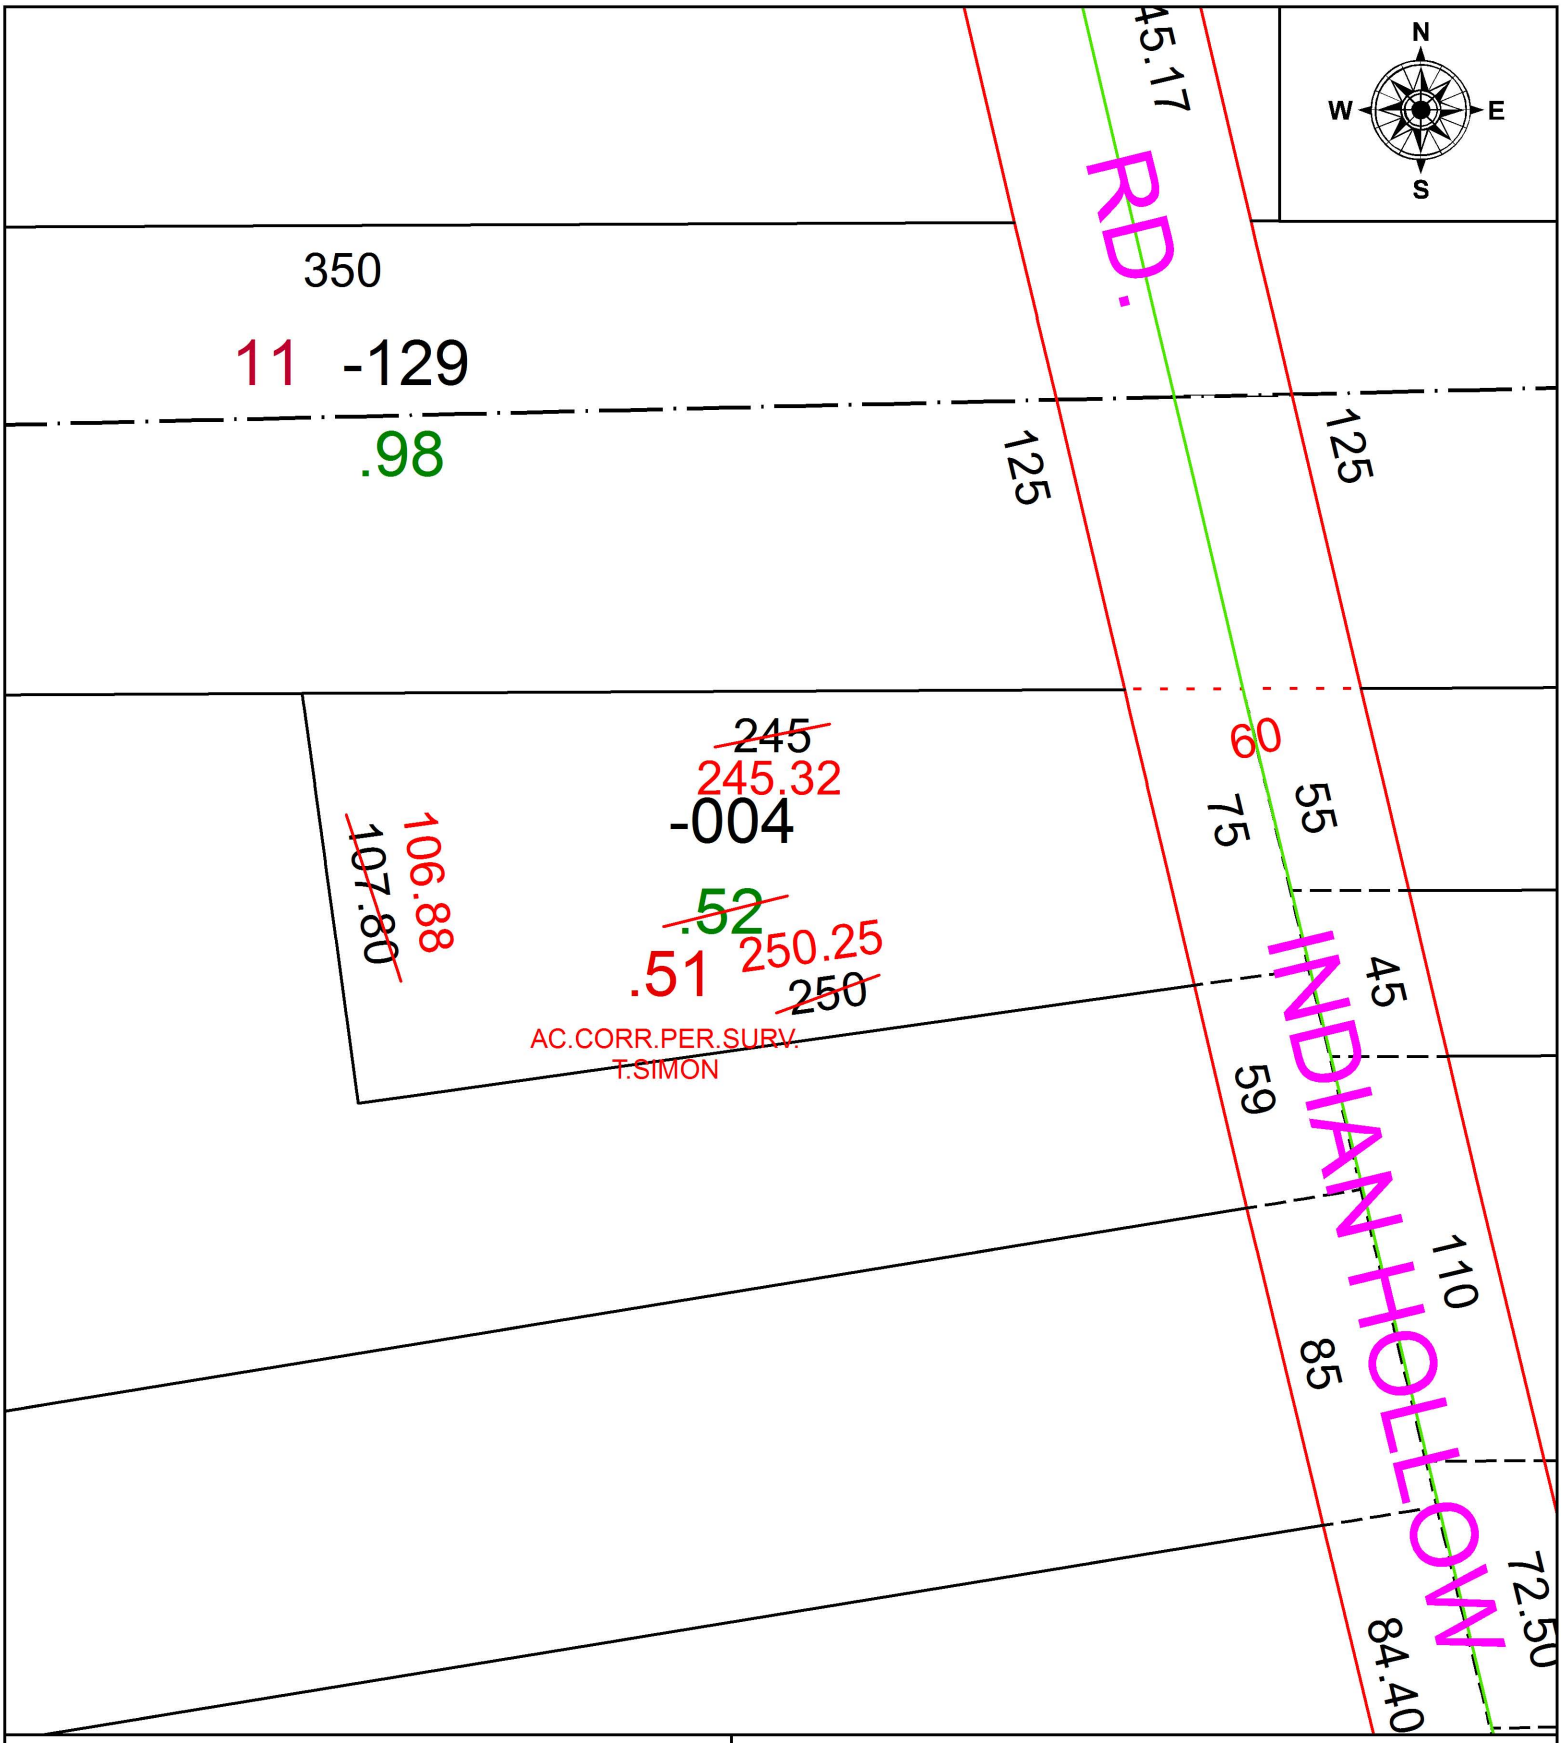

SPLITS/DEEDS PROCESSED

LORAIN COUNTY TAX MAP DEPARTMENT
226 MIDDLE AVE. ELYRIA, OH

SURVEYED BY: THOMAS A. SIMON
CLOSURE: 1: 102,903
MAP PAGE(S): 10-00-025
APPOVED BY: RRM **DATE:** 12-19-18
SCALE: 1" = 50 **PRIOR INSTRUMENT:** 20070223604