PARENT PARCEL: 11-00-070-000-154

CHILD PARCEL: 11-00-070-000-166, -167

STARTING POINT: INTERSECTION OF C/L OF CHESTNUT RIDGE RD. AND C/L OF ARCHER RD.

19-04001

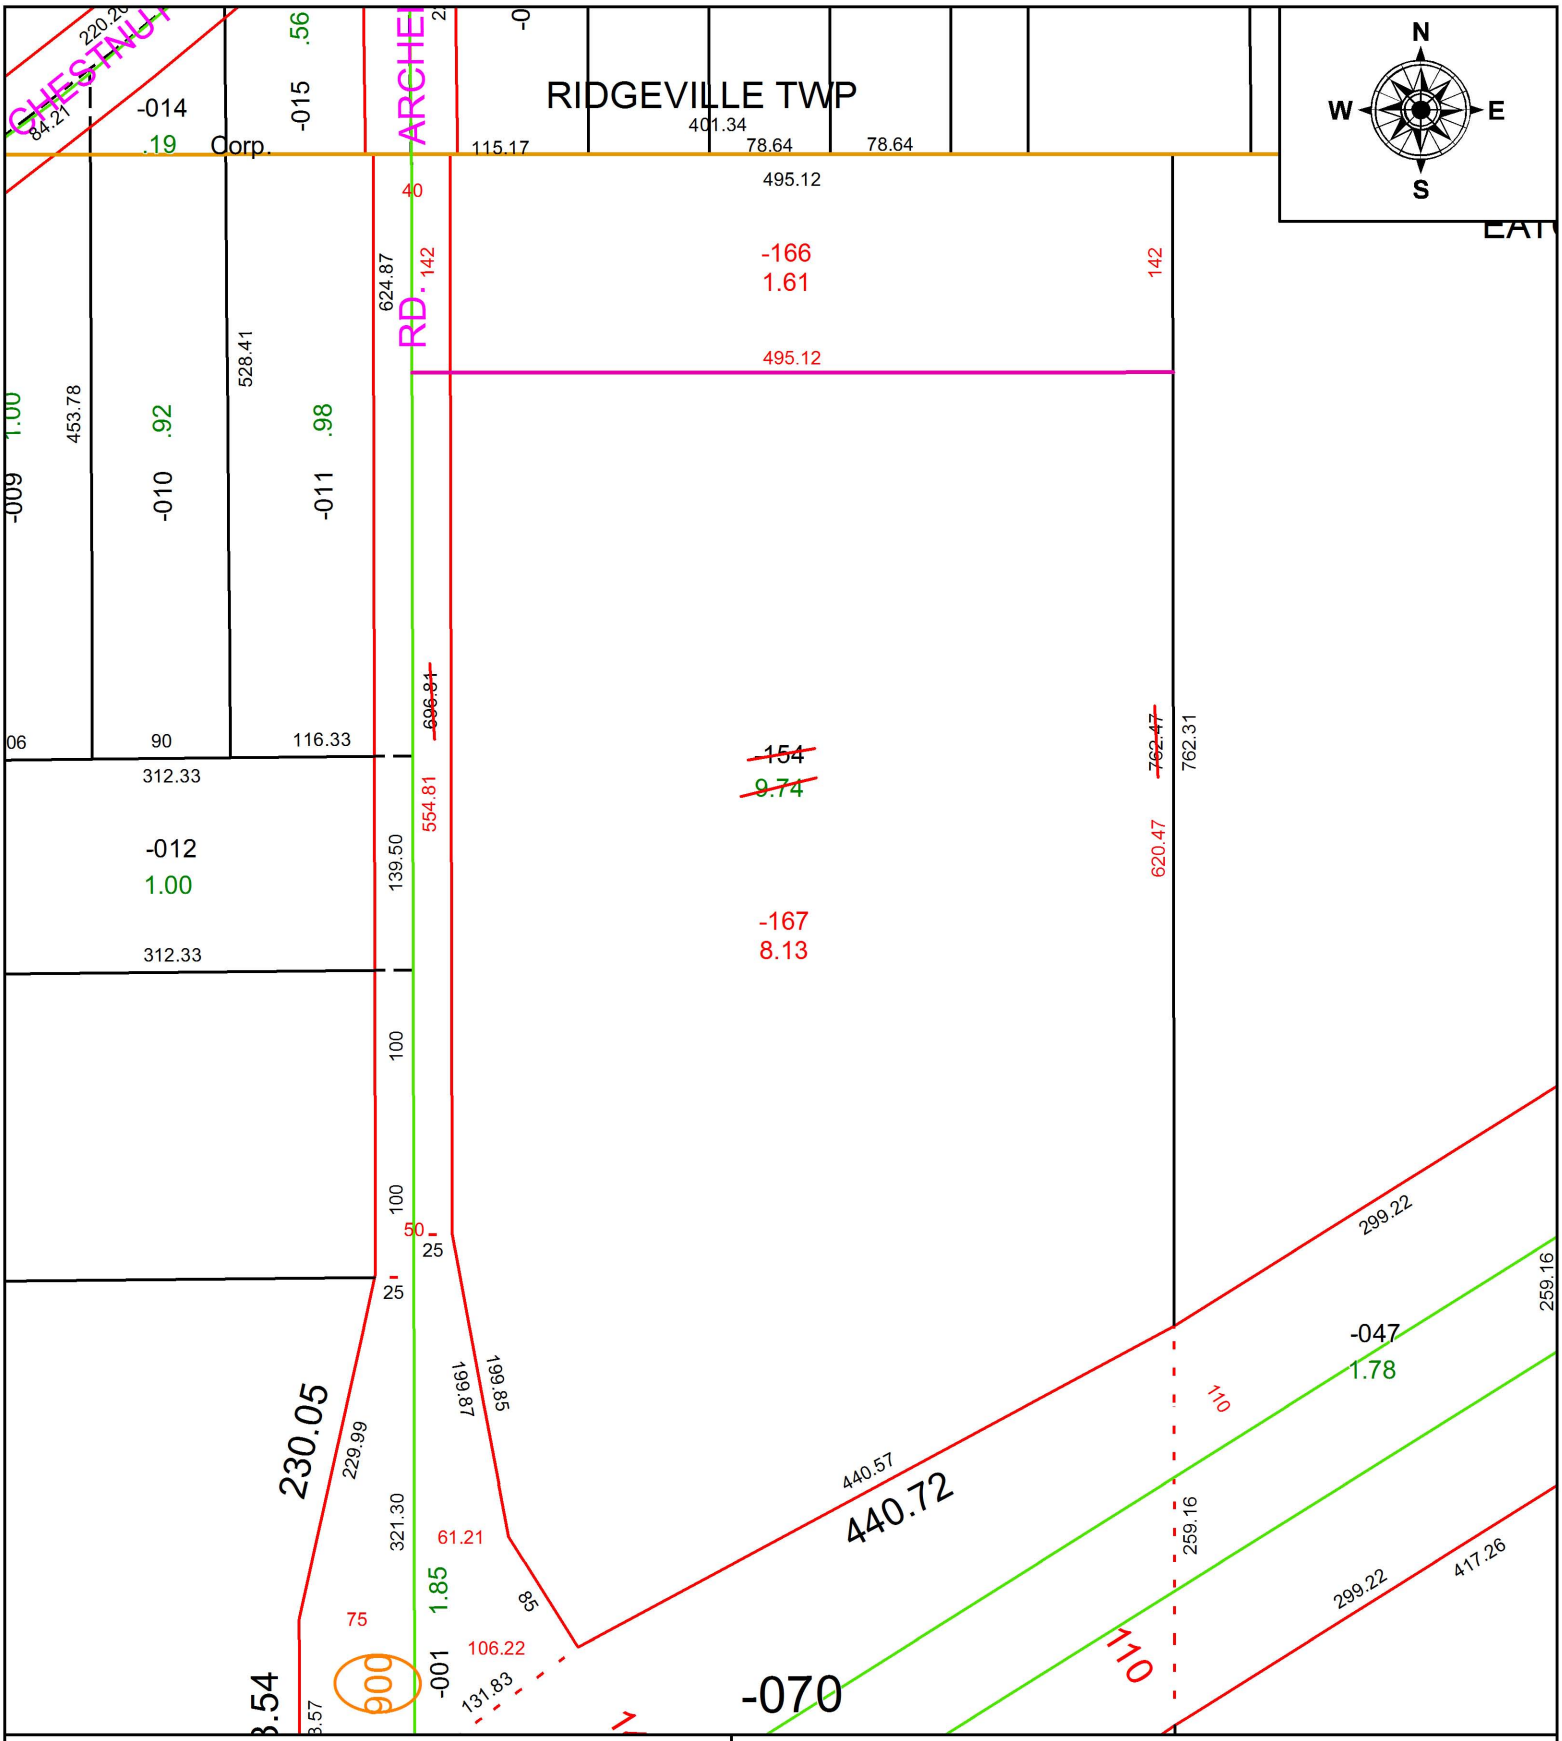

SPLITS/DEEDS PROCESSED

LORAIN COUNTY TAX MAP DEPARTMENT
226 MIDDLE AVE. ELYRIA, OH

SURVEYED BY: THOMAS M. SNEZEK

CLOSURE: 1:2147483648

MAP PAGE(S): 11-00-070

APPOVED BY: RRM **DATE:** 8-5-19

SCALE: 1" = 125 **PRIOR INSTRUMENT:** 20120421593