**PARENT PARCEL:** 10-00-006-118-011, -029

**CHILD PARCEL:** 10-00-006-118-030

**STARTING POINT:** INTERSECTION OF C/L OF BUTTERNUT RIDGE RD. AND WEST LINE OF VILLAGE OF LAPORTE SUB.

**19-04002**

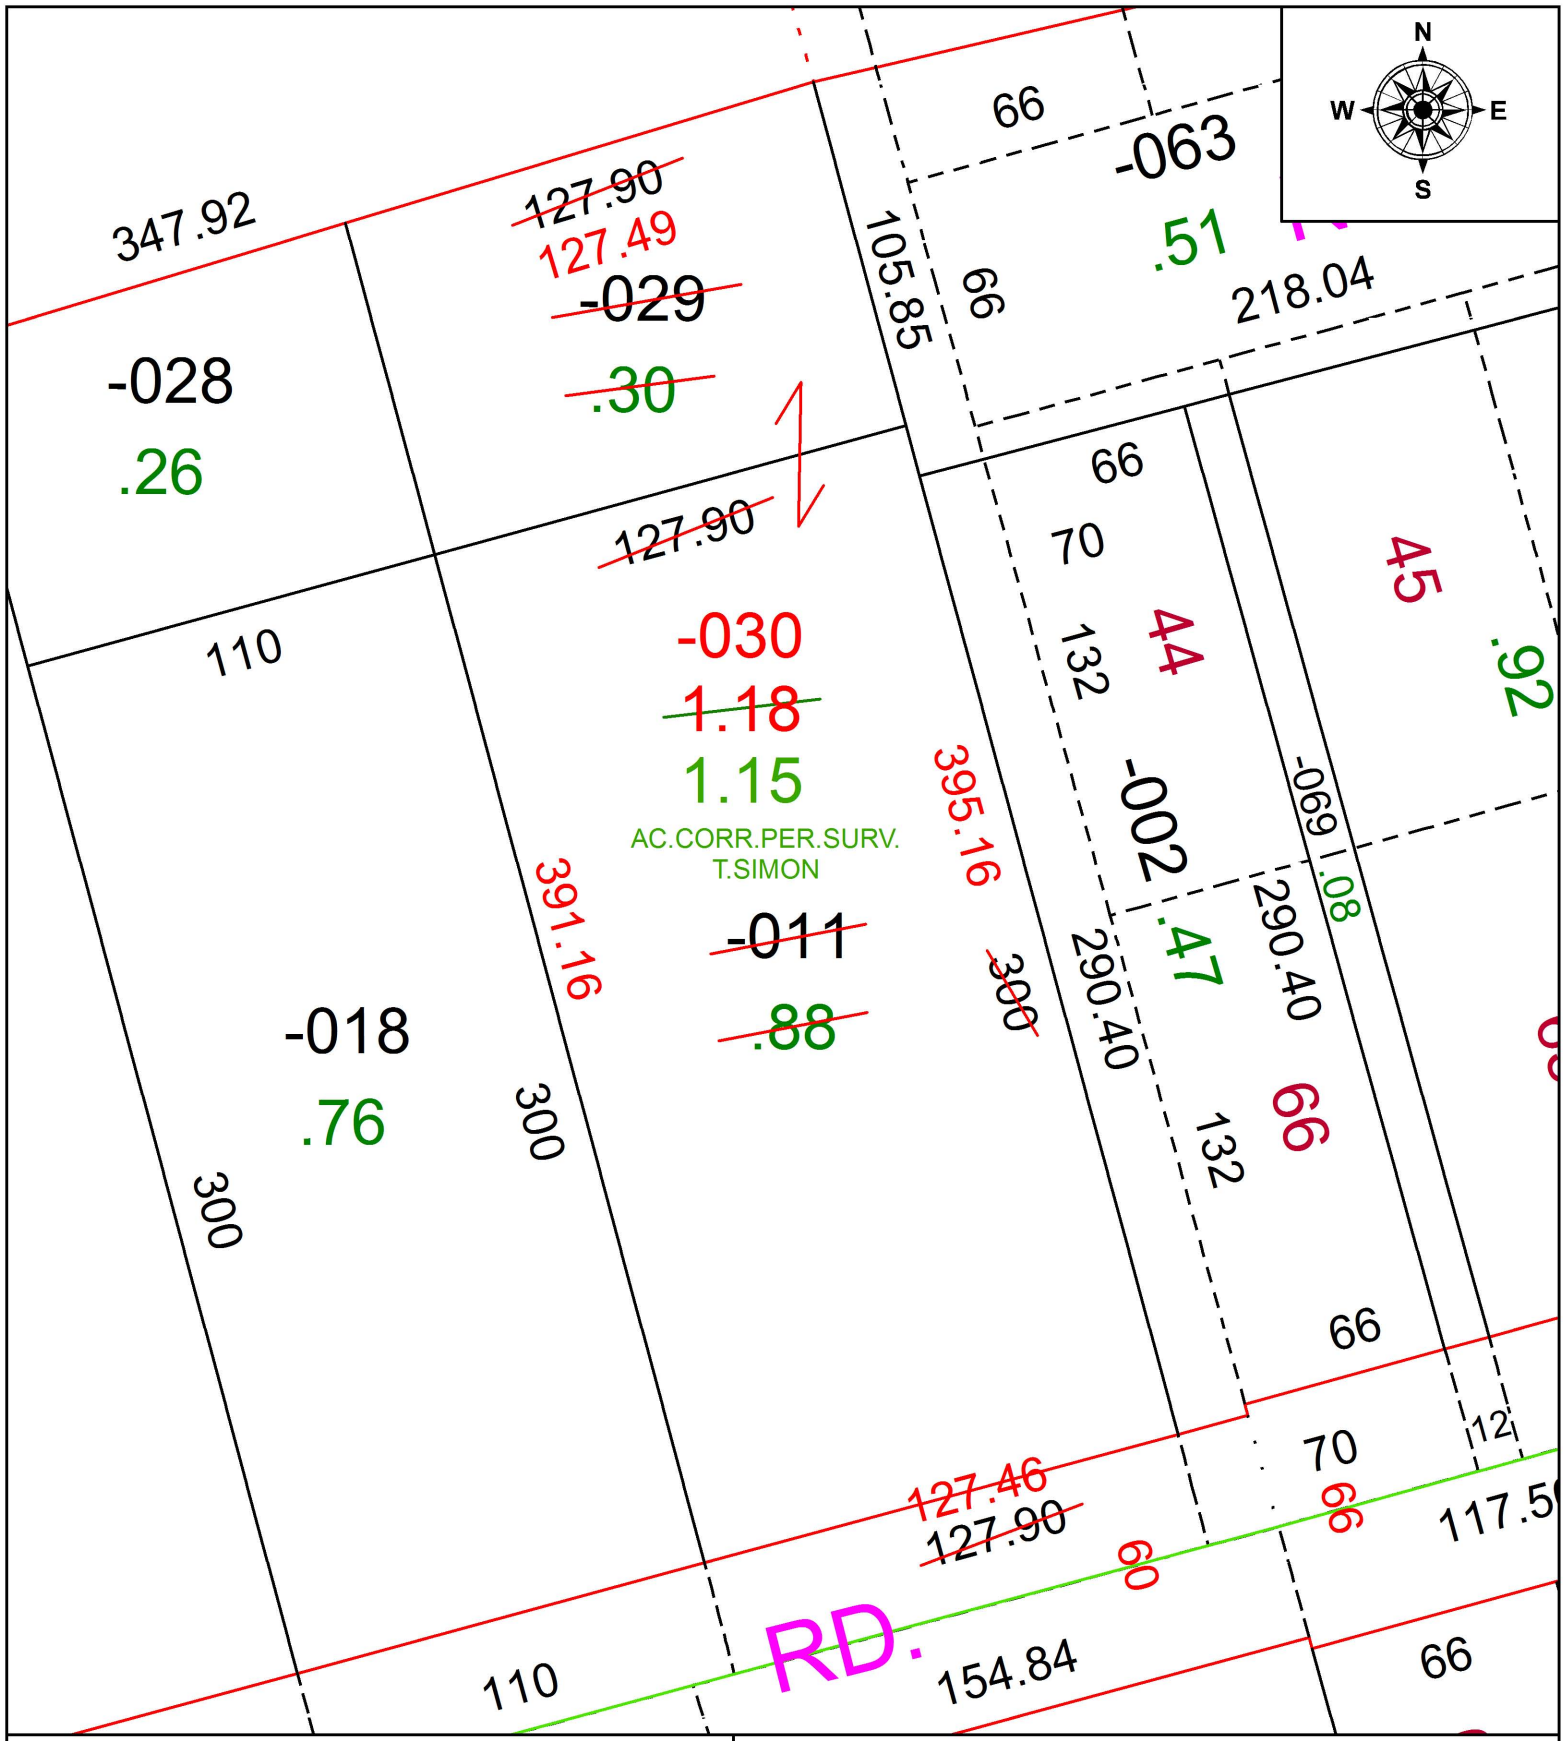


**SPLITS/DEEDS PROCESSED**

LORAIN COUNTY TAX MAP DEPARTMENT
226 MIDDLE AVE. ELYRIA, OH

**SURVEYED BY:** THOMAS A. SIMON
**CLOSURE:** 1:276,223
**MAP PAGE(S):** 10-00-006
**APPOVED BY:** RRM **DATE:** 8-6-19
**SCALE:** 1" = 50 **PRIOR INSTRUMENT:** 20190711573