PARENT PARCEL: 05-00-024-107-001 THRU -004

CHILD PARCEL: 05-00-024-107-011

STARTING POINT: NORTHWEST CORNER OF S/L 154 IN JOSIAH HARRIS HEIRS SUB.

19-04003

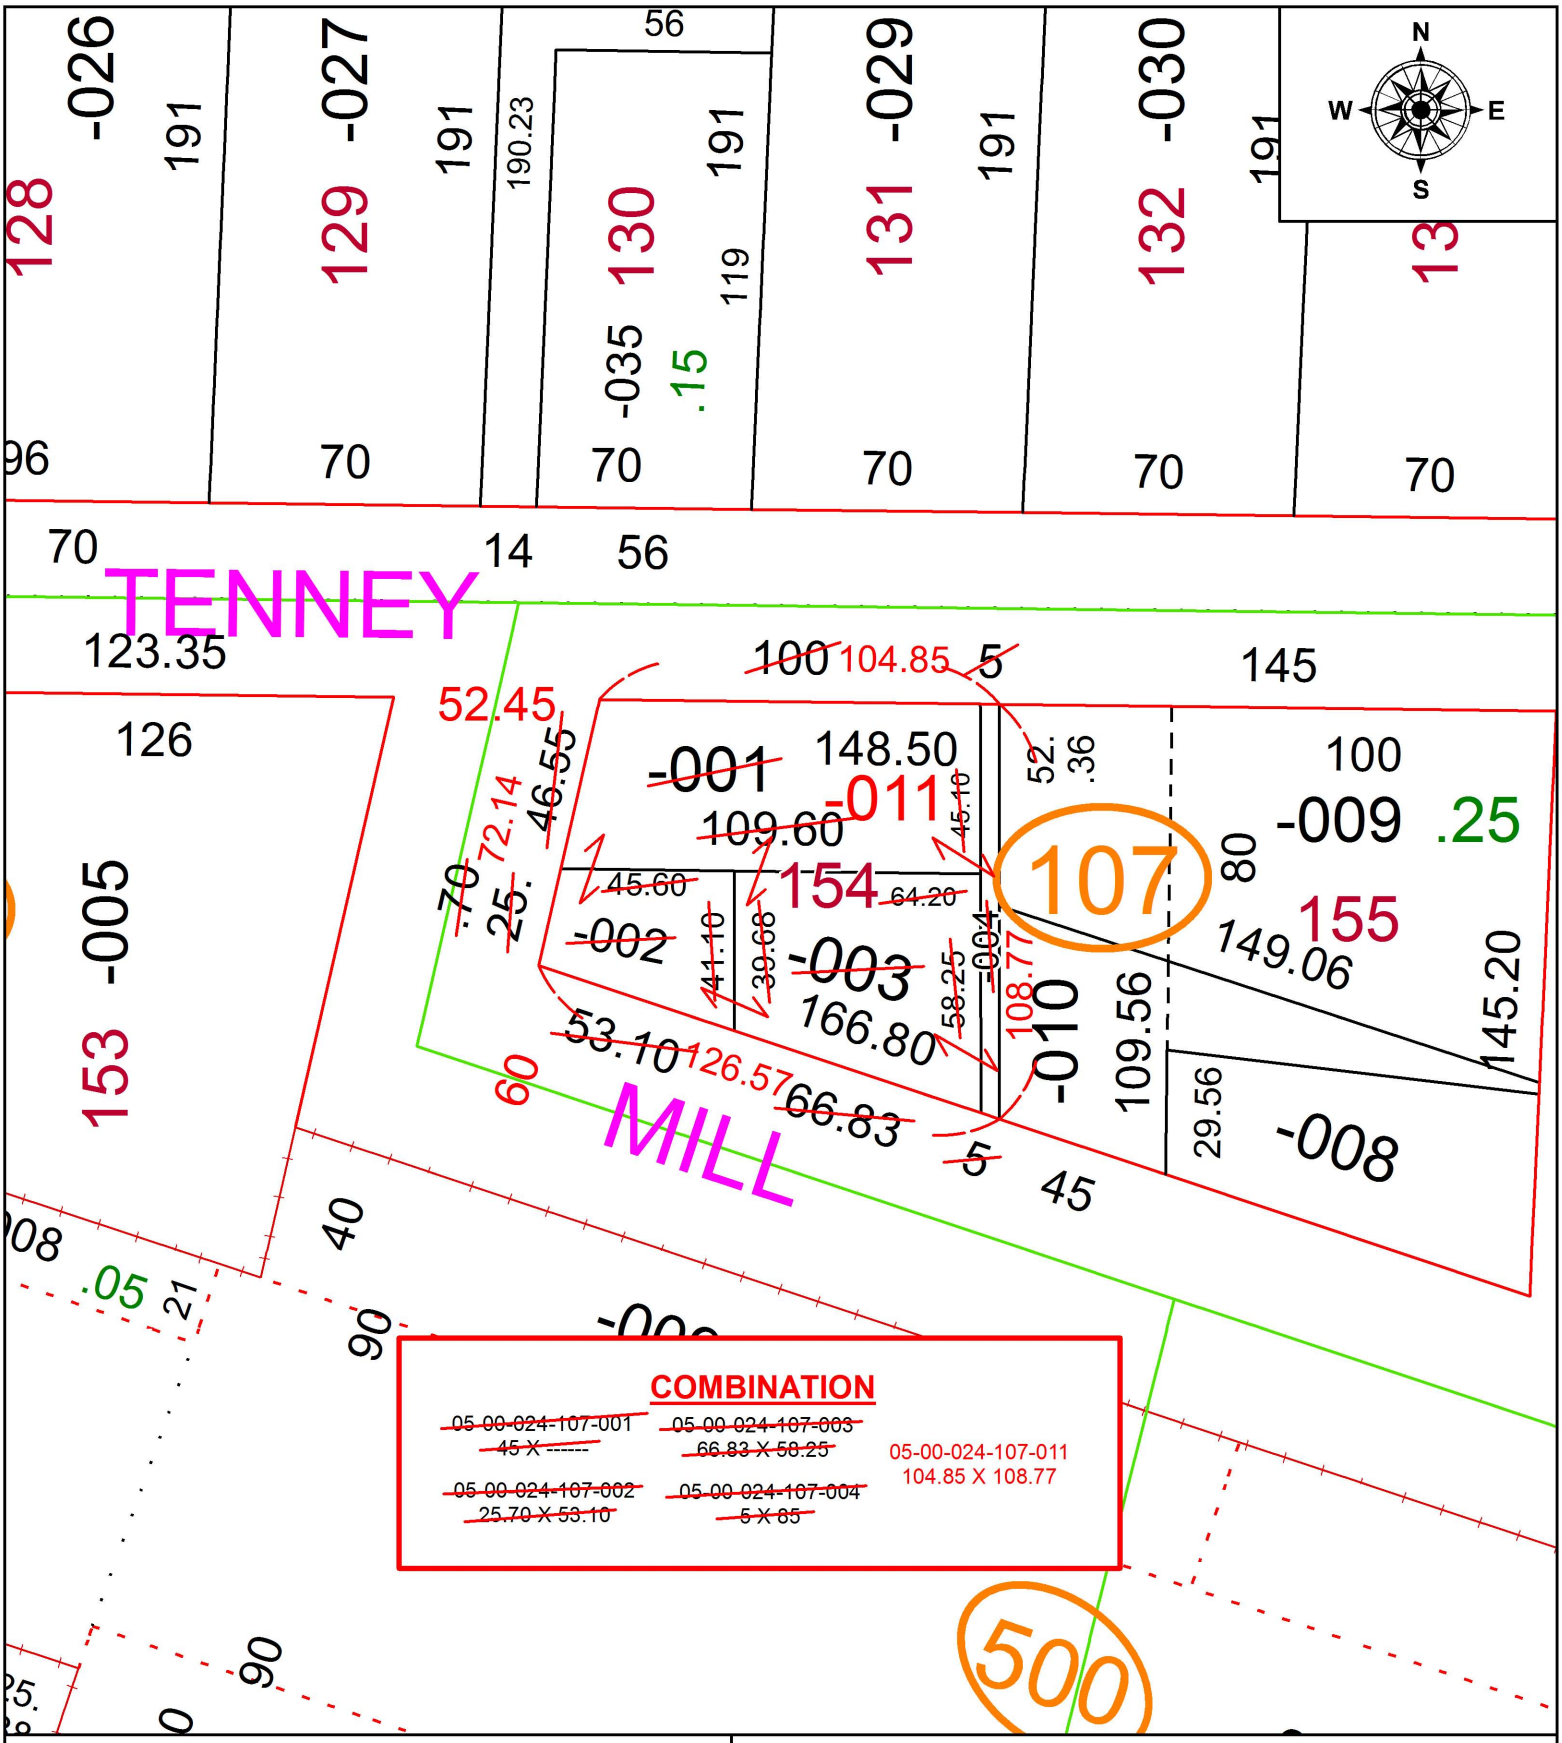

COMBINATION

~~05-00-024-107-001~~
~~45 X ------~~

~~05-00-024-107-003~~
~~66.83 X 58.25~~

~~05-00-024-107-002~~
~~25.70 X 53.10~~

~~05-00-024-107-004~~
~~5 X 85~~

05-00-024-107-011
104.85 X 108.77

SPLITS/DEEDS PROCESSED

LORAIN COUNTY TAX MAP DEPARTMENT
226 MIDDLE AVE. ELYRIA, OH

SURVEYED BY: TIMOTHY D. HOZALSKI
CLOSURE: 1:68,867
MAP PAGE(S): 5-00-024
APPOVED BY: RRM **DATE:** 8-6-19
SCALE: 1" = 50 **PRIOR INSTRUMENT:** 20190707960