PARENT PARCEL: 18-00-021-101-013

CHILD PARCEL: Ac. corr. per T. Hozalski

STARTING POINT: INTERSECTION OF C/L OF MAPLE ST & C/L OF N. MAIN ST.

18-04005-C

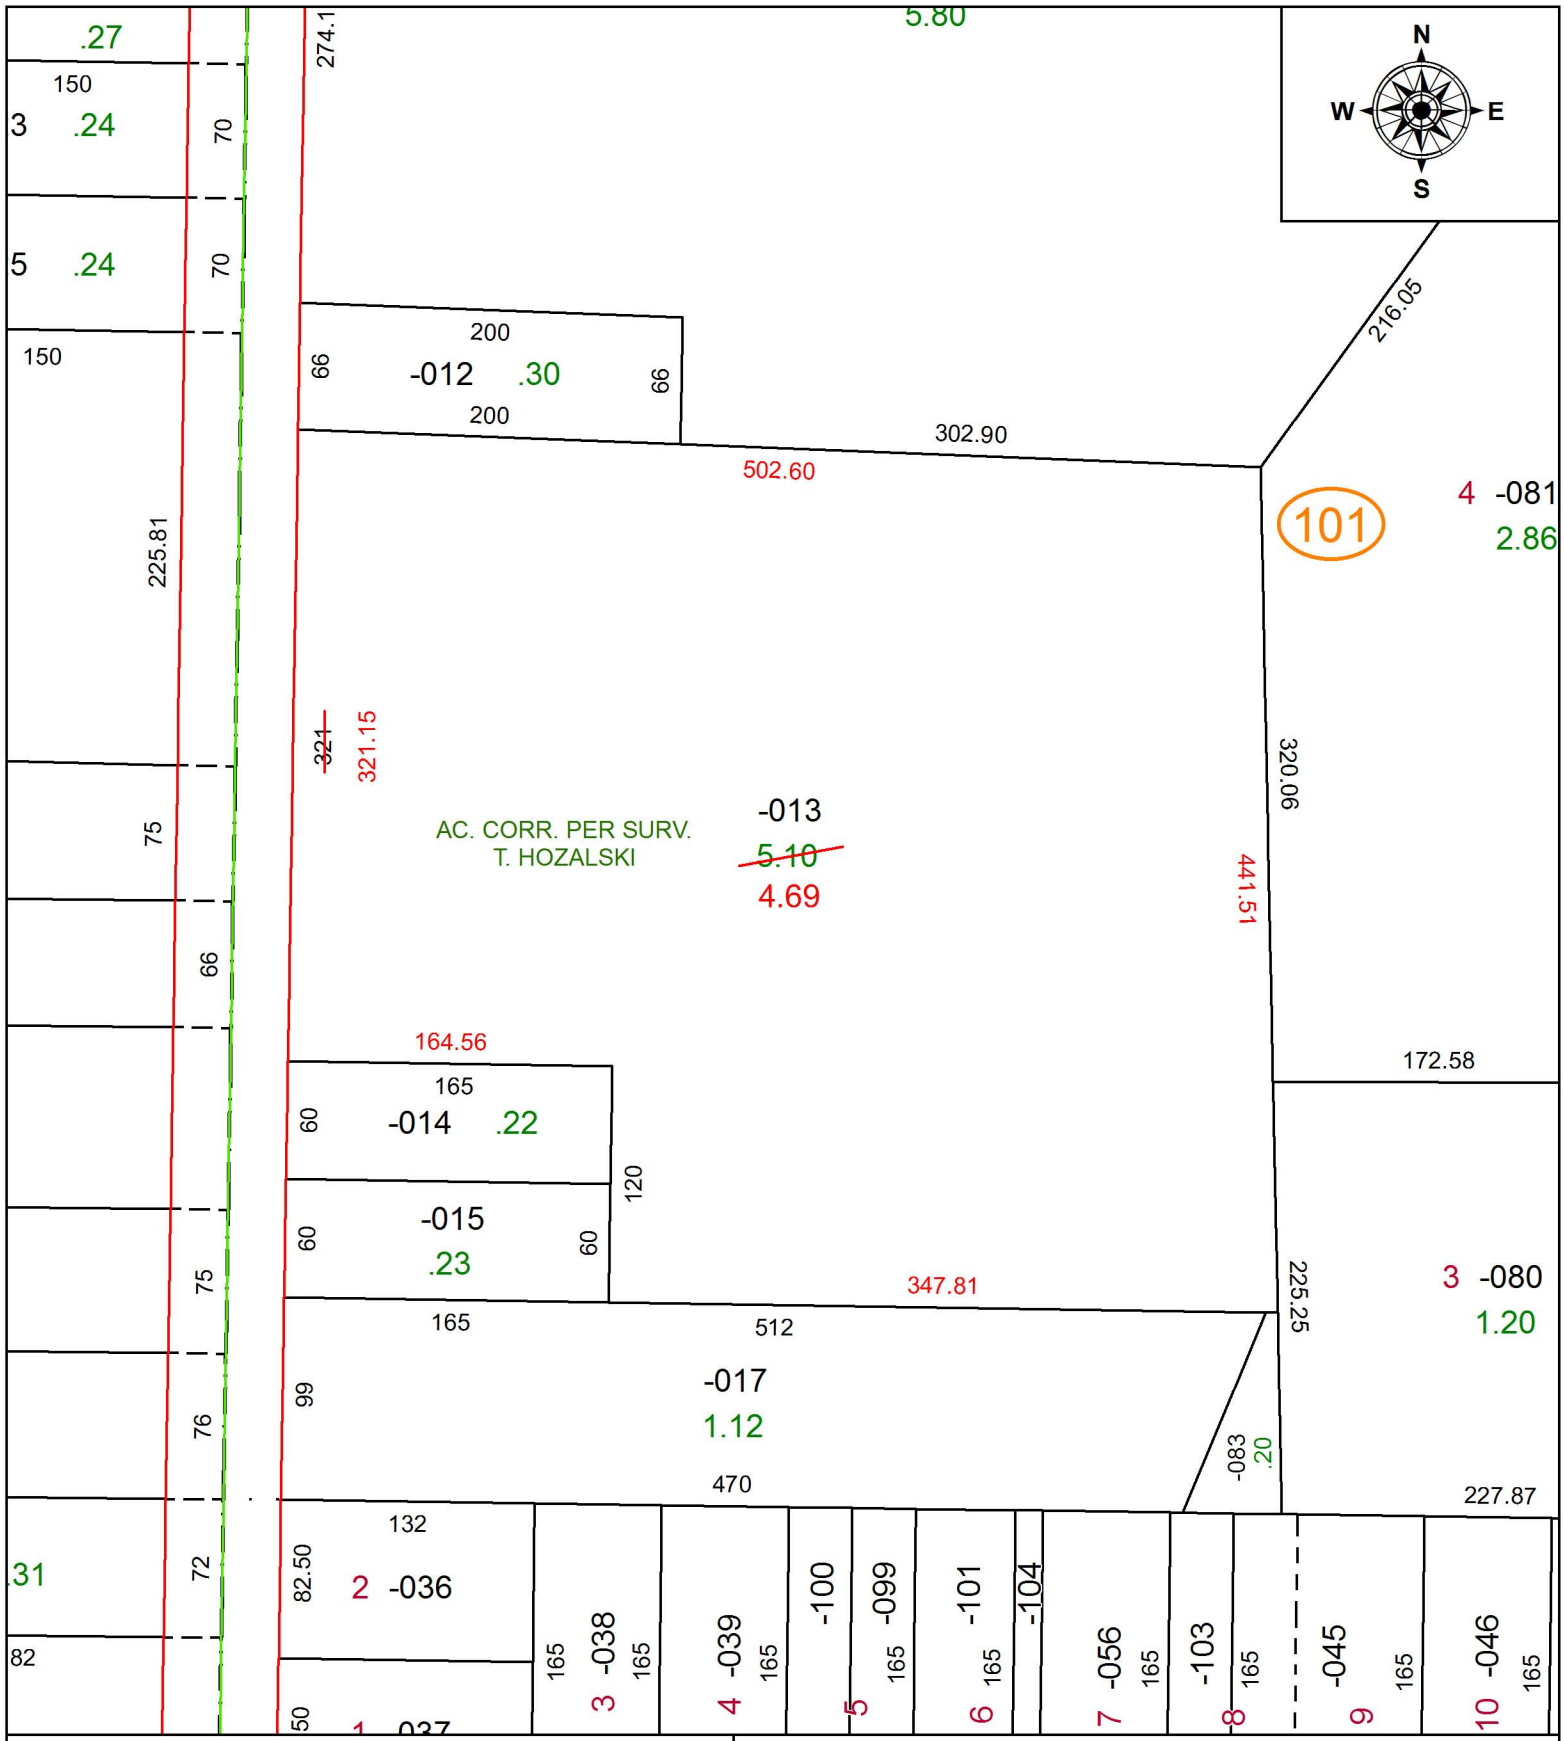

SPLITS/DEEDS PROCESSED

LORAIN COUNTY TAX MAP DEPARTMENT
226 MIDDLE AVE. ELYRIA, OH

SURVEYED BY: TIMOTHY D. HOZALSKI
CLOSURE: 1: 240,375
MAP PAGE(S): 18-00-021-A
APPOVED BY: SS **DATE:** 12/28/2018
SCALE: 1" = 100 **PRIOR INSTRUMENT:** 2017-0656386