PARENT PARCEL: 11-00-081-102-064

CHILD PARCEL:

STARTING POINT: INTERSECTION OF C/L OF NOVAK RD. AND C/L OF DURKEE RD.

19-04010-A

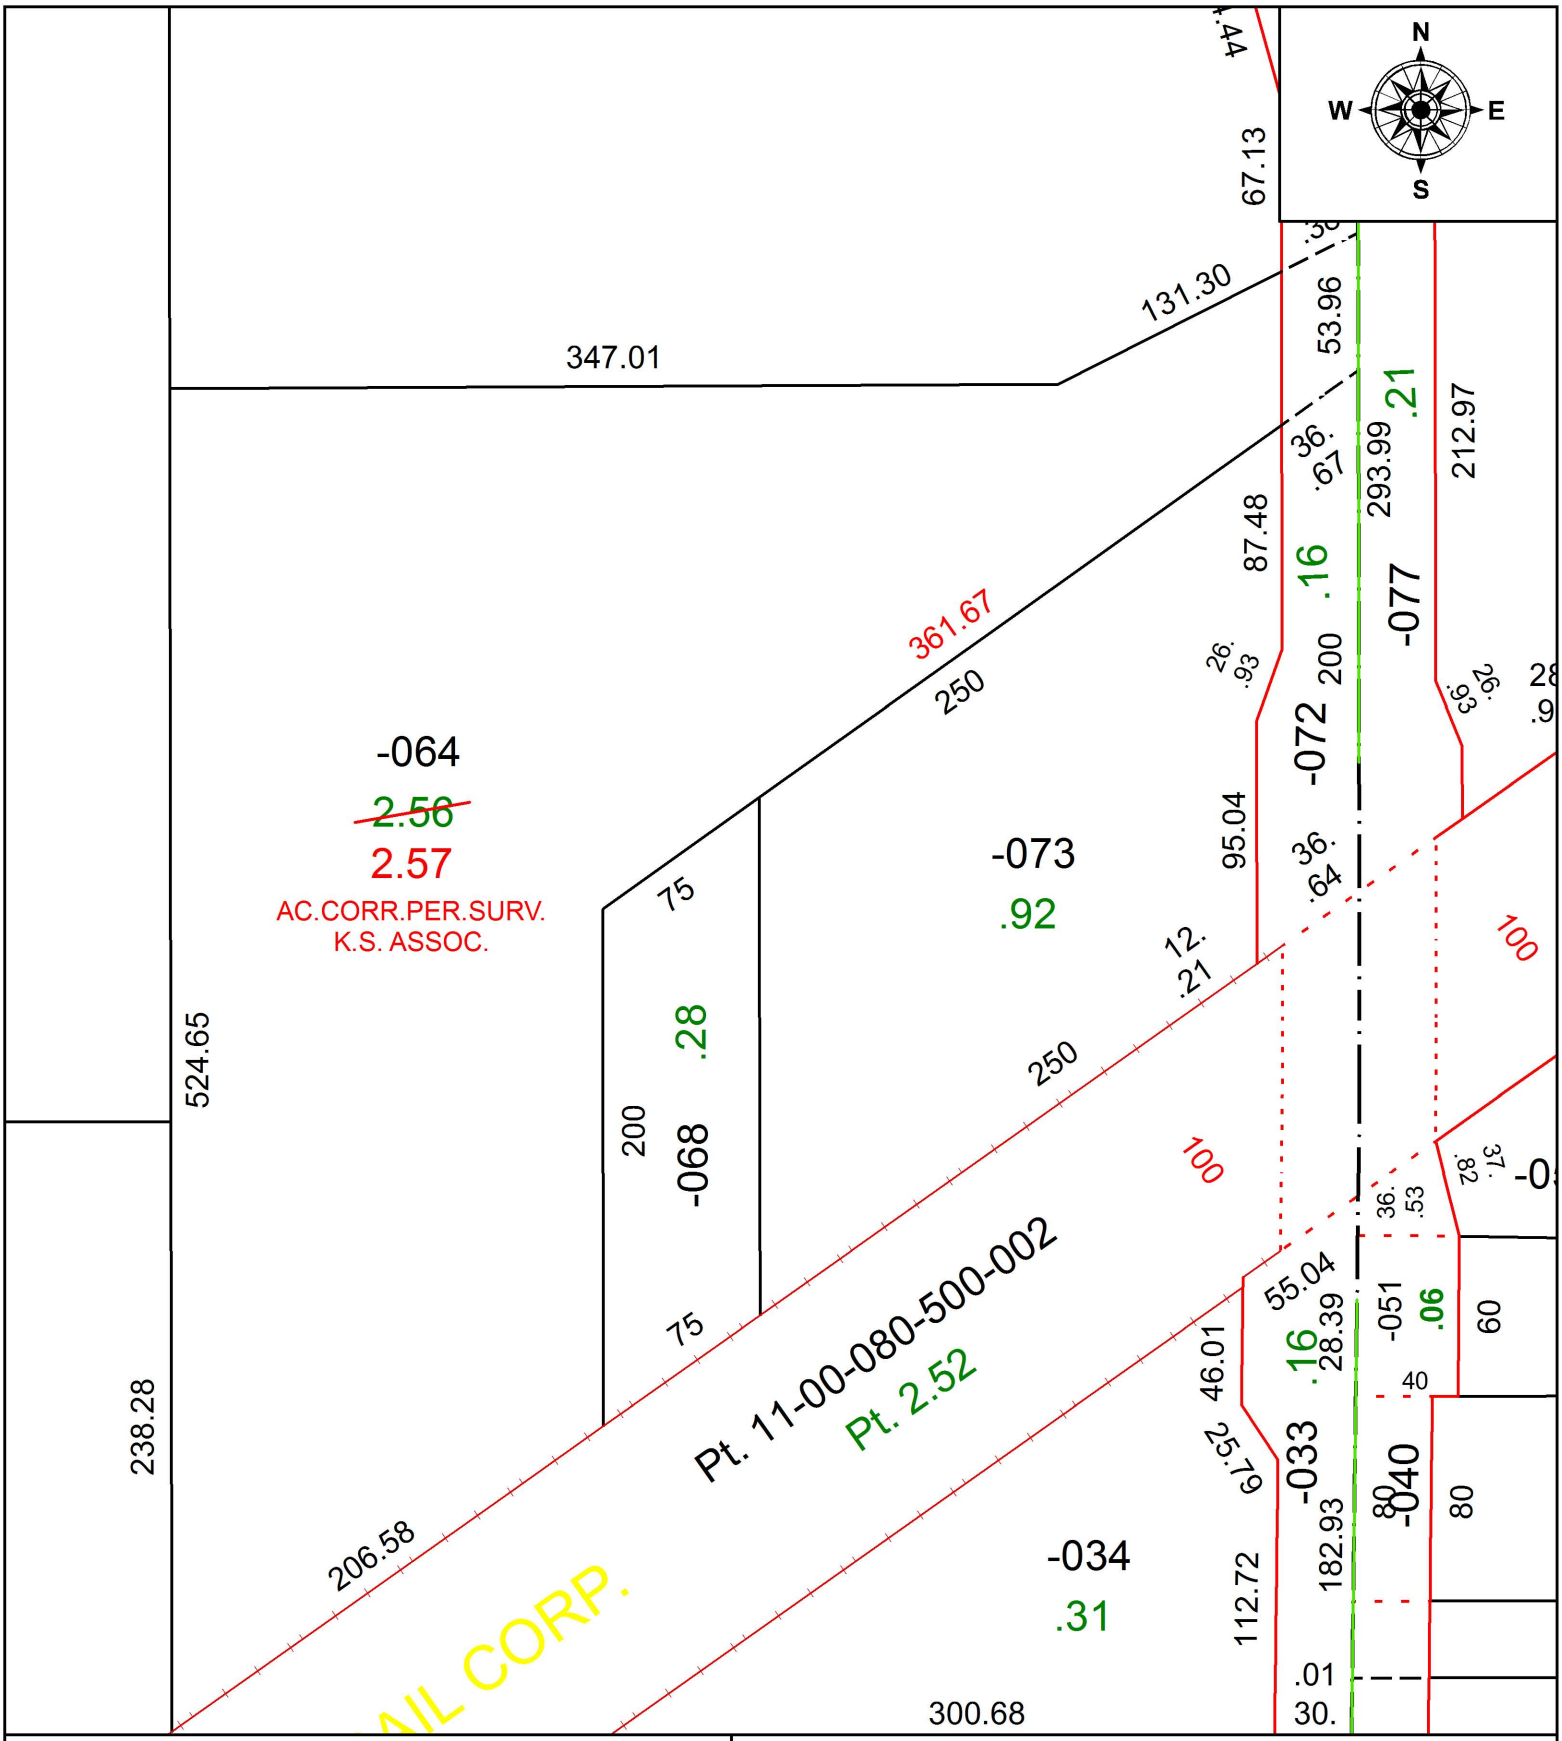

SPLITS/DEEDS PROCESSED

LORAIN COUNTY TAX MAP DEPARTMENT
226 MIDDLE AVE. ELYRIA, OH

SURVEYED BY: K.S. ASSOC.
CLOSURE: 1: 47,733
MAP PAGE(S): 11-00-081
APPOVED BY: RRM **DATE:** 1-4-19
SCALE: 1" = 75 **PRIOR INSTRUMENT:** 20180699608