PARENT PARCEL: 02-01-004-107-018

CHILD PARCEL:

STARTING POINT: NORTHEAST CORNER OF EDGAR G, YECKLEY (DV 153/559)

19-04011-C

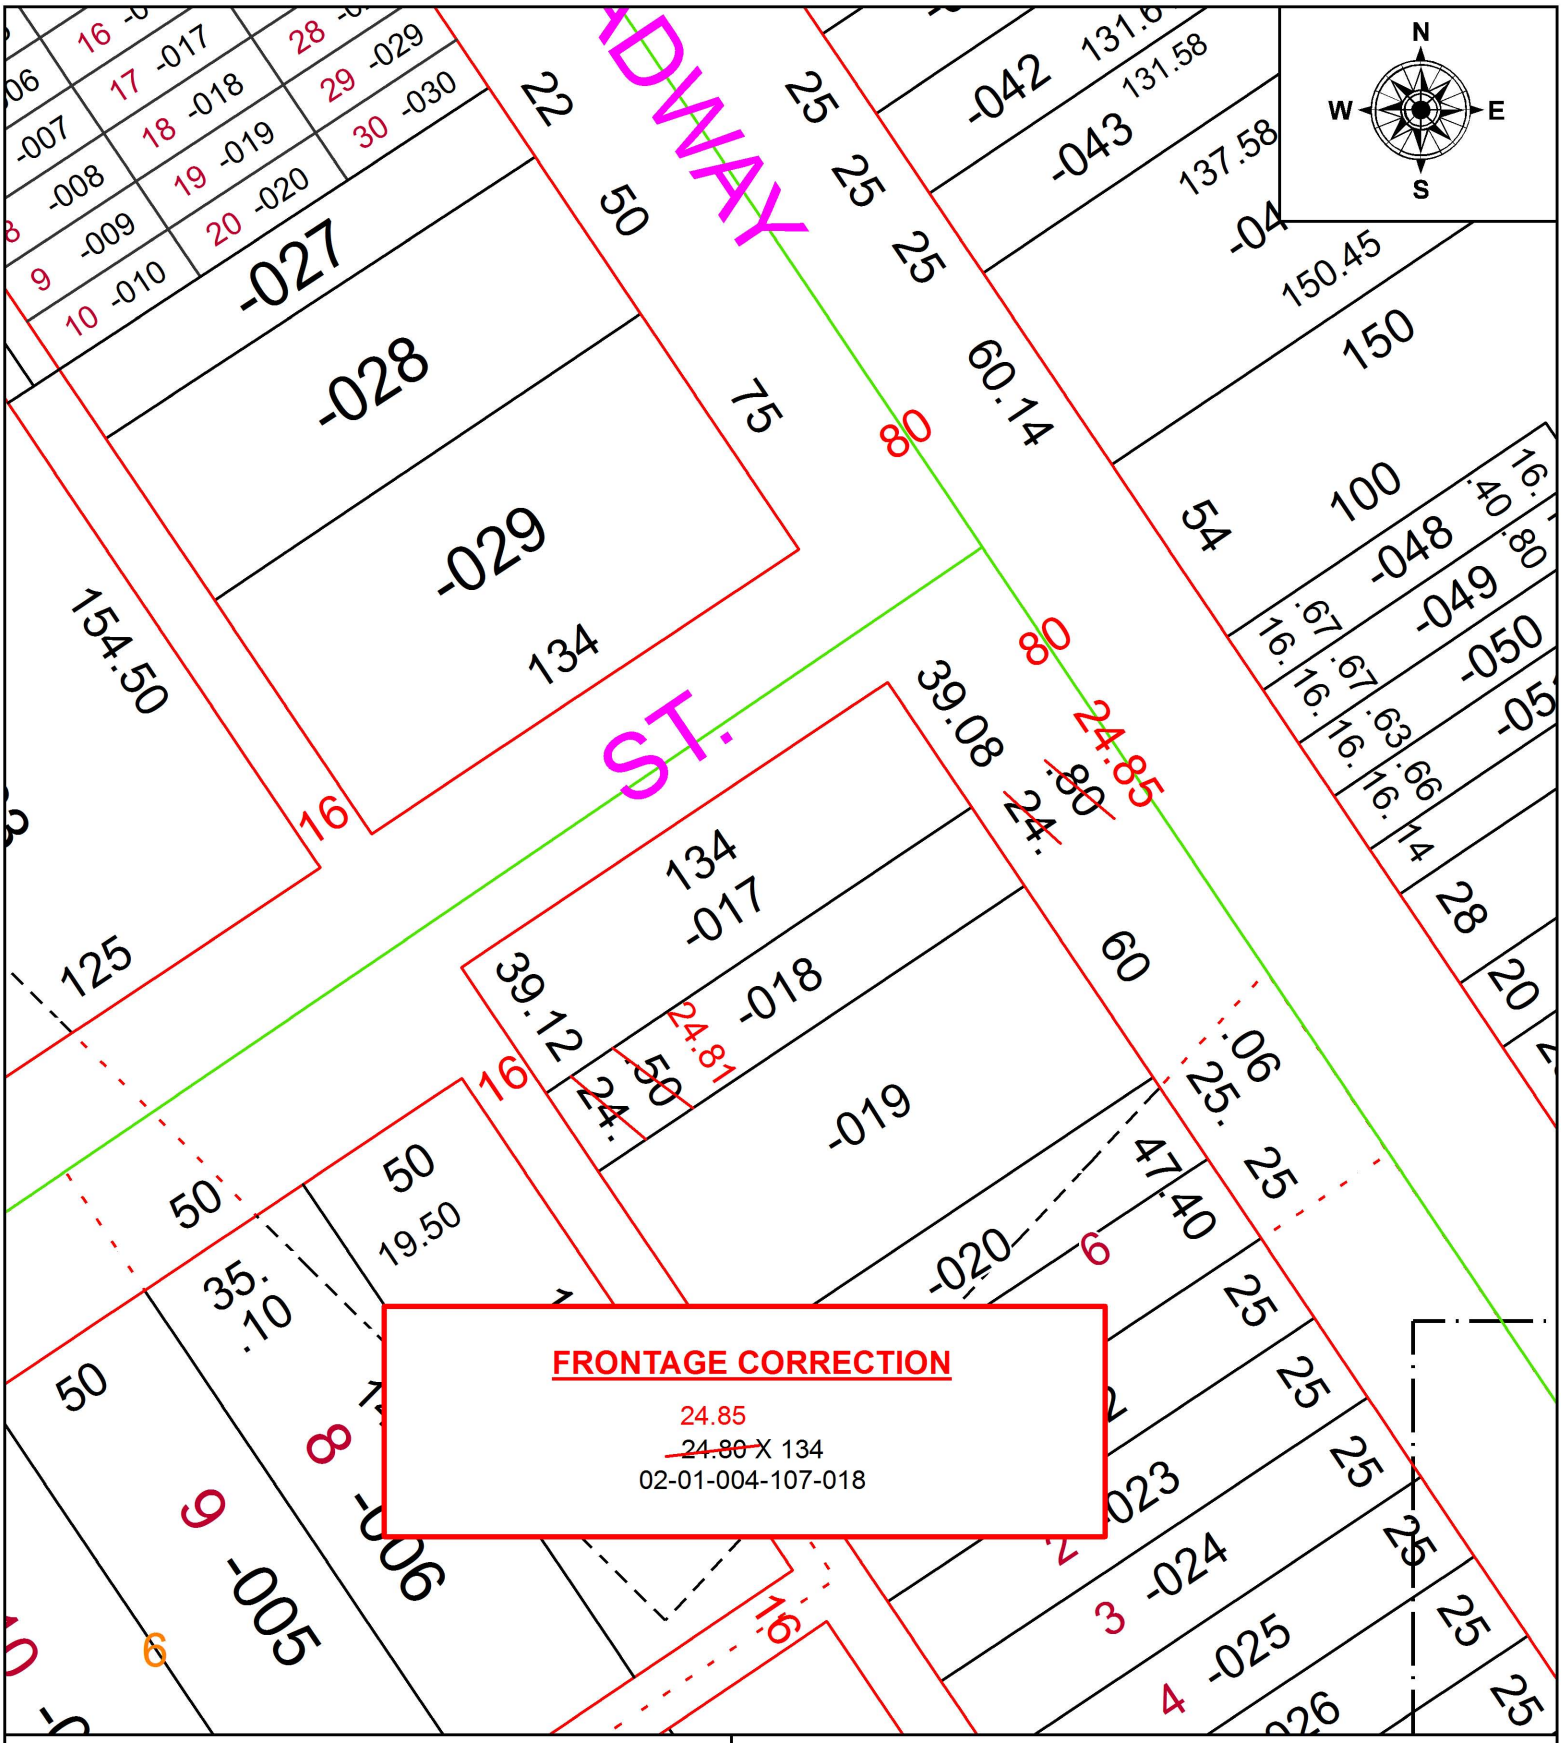

SPLITS/DEEDS PROCESSED

LORAIN COUNTY TAX MAP DEPARTMENT
226 MIDDLE AVE. ELYRIA, OH

SURVEYED BY: N/A
CLOSURE: N/A
MAP PAGE(S): 2-01-004
APPOVED BY: RRM **DATE:** 1-4-19
SCALE: 1" = 50 **PRIOR INSTRUMENT:** 20180697867