PARENT PARCEL: 04-00-027-102-018

CHILD PARCEL:

STARTING POINT: INTERSECTION OF C/L OF NORTH RIDGE RD. AND EAST LINE OF LORAIN COUNTY

19-04013-A

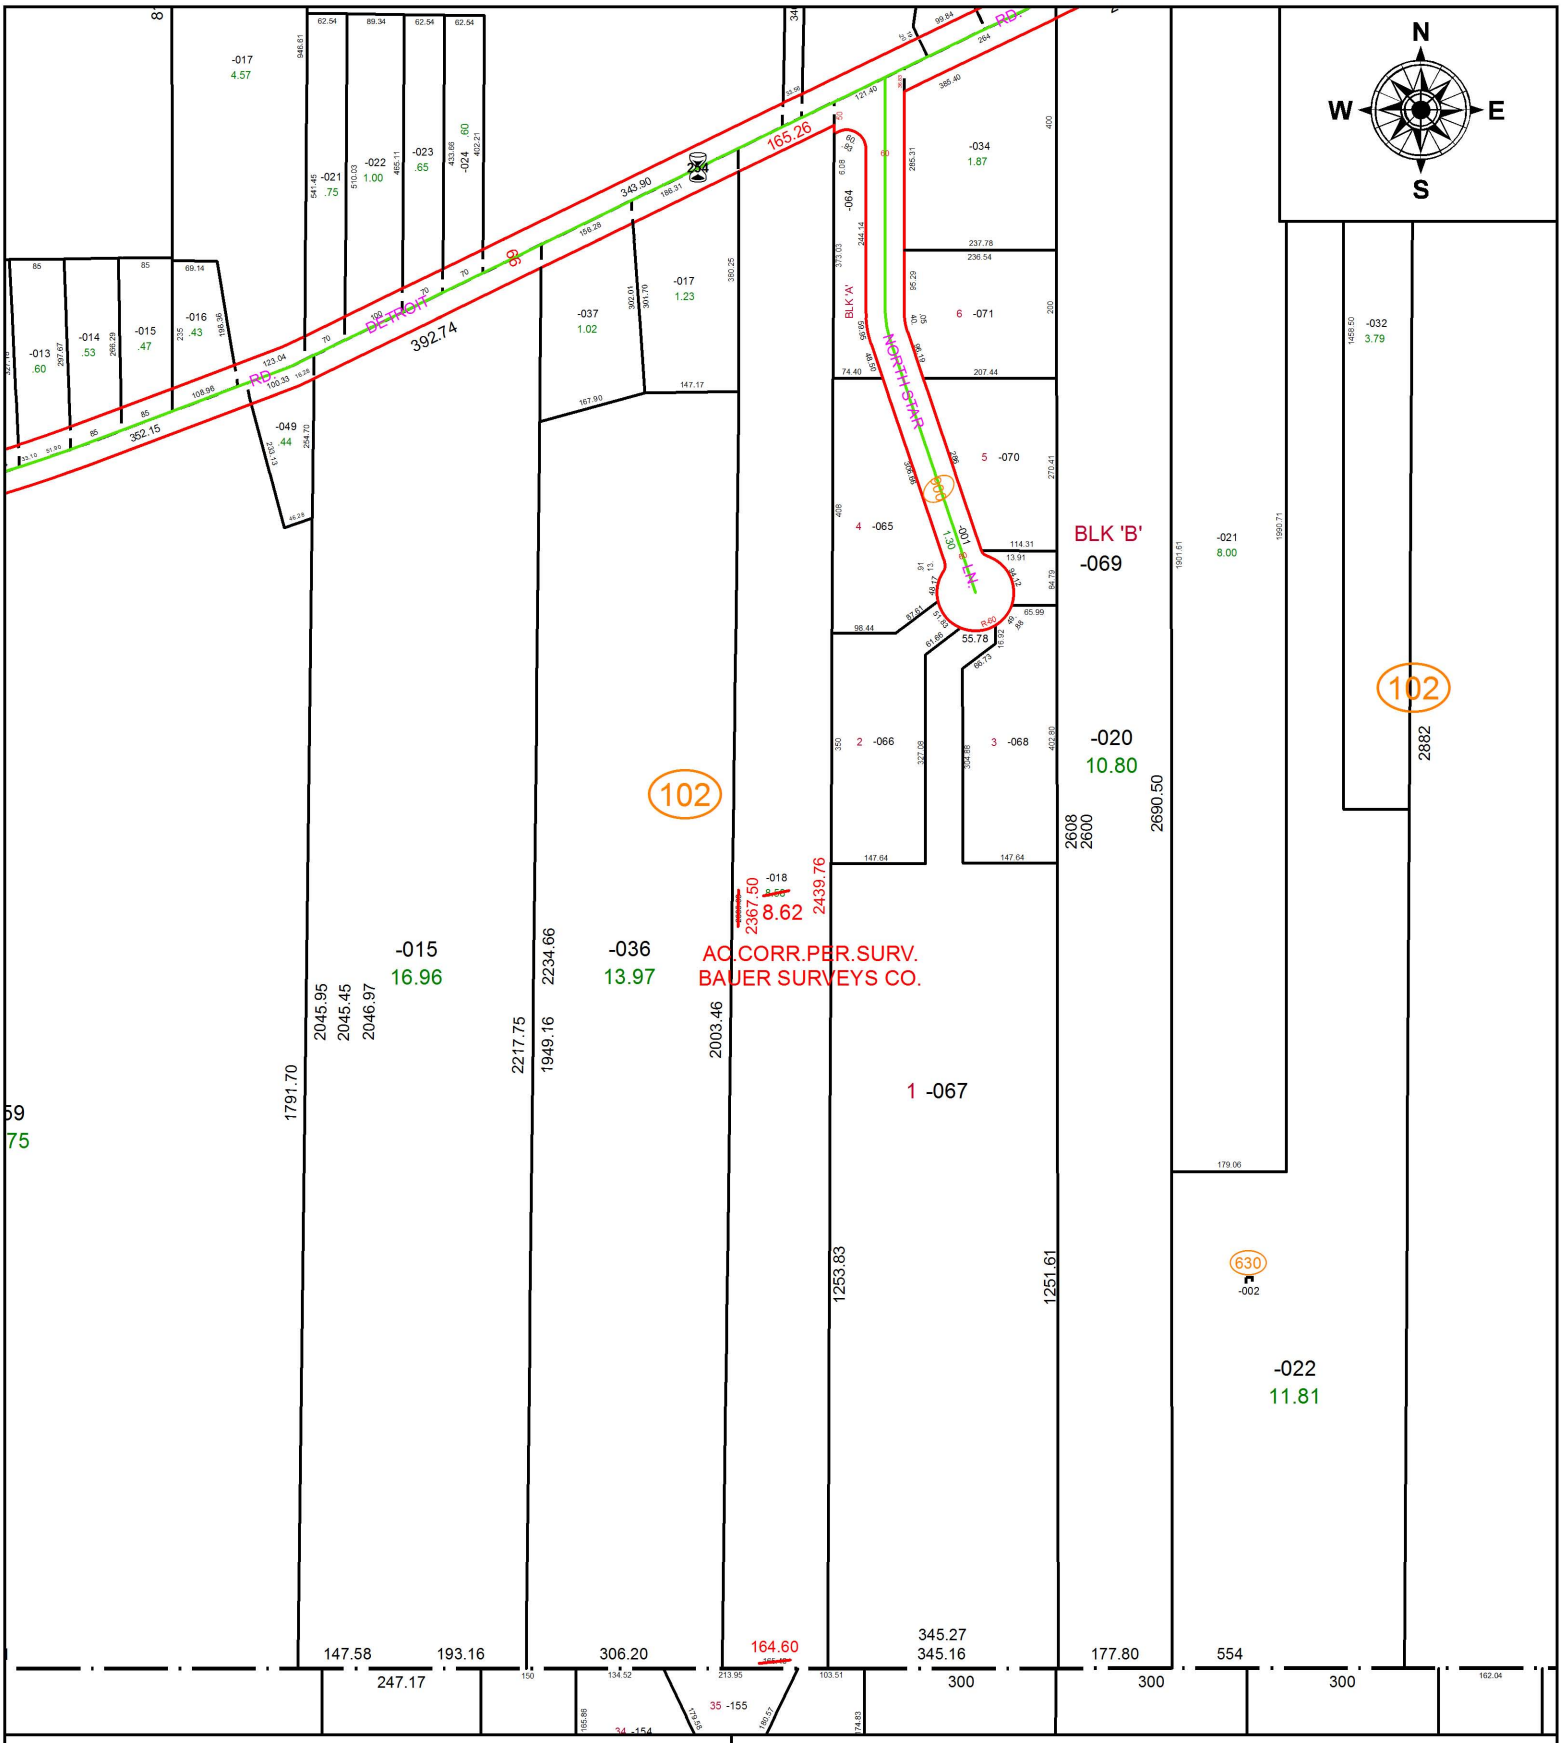

SPLITS/DEEDS PROCESSED

LORAIN COUNTY TAX MAP DEPARTMENT
226 MIDDLE AVE. ELYRIA, OH

SURVEYED BY: BAUER SURVEYS CO.
CLOSURE: N/A
MAP PAGE(S): 4-00-027
APPOVED BY: RRM **DATE:** 1-4-19
SCALE: 1" = 300 **PRIOR INSTRUMENT:** OR 74/770