PARENT PARCEL: 08-12-006-000-015
CHILD PARCEL:
STARTING POINT:

19-04018-A

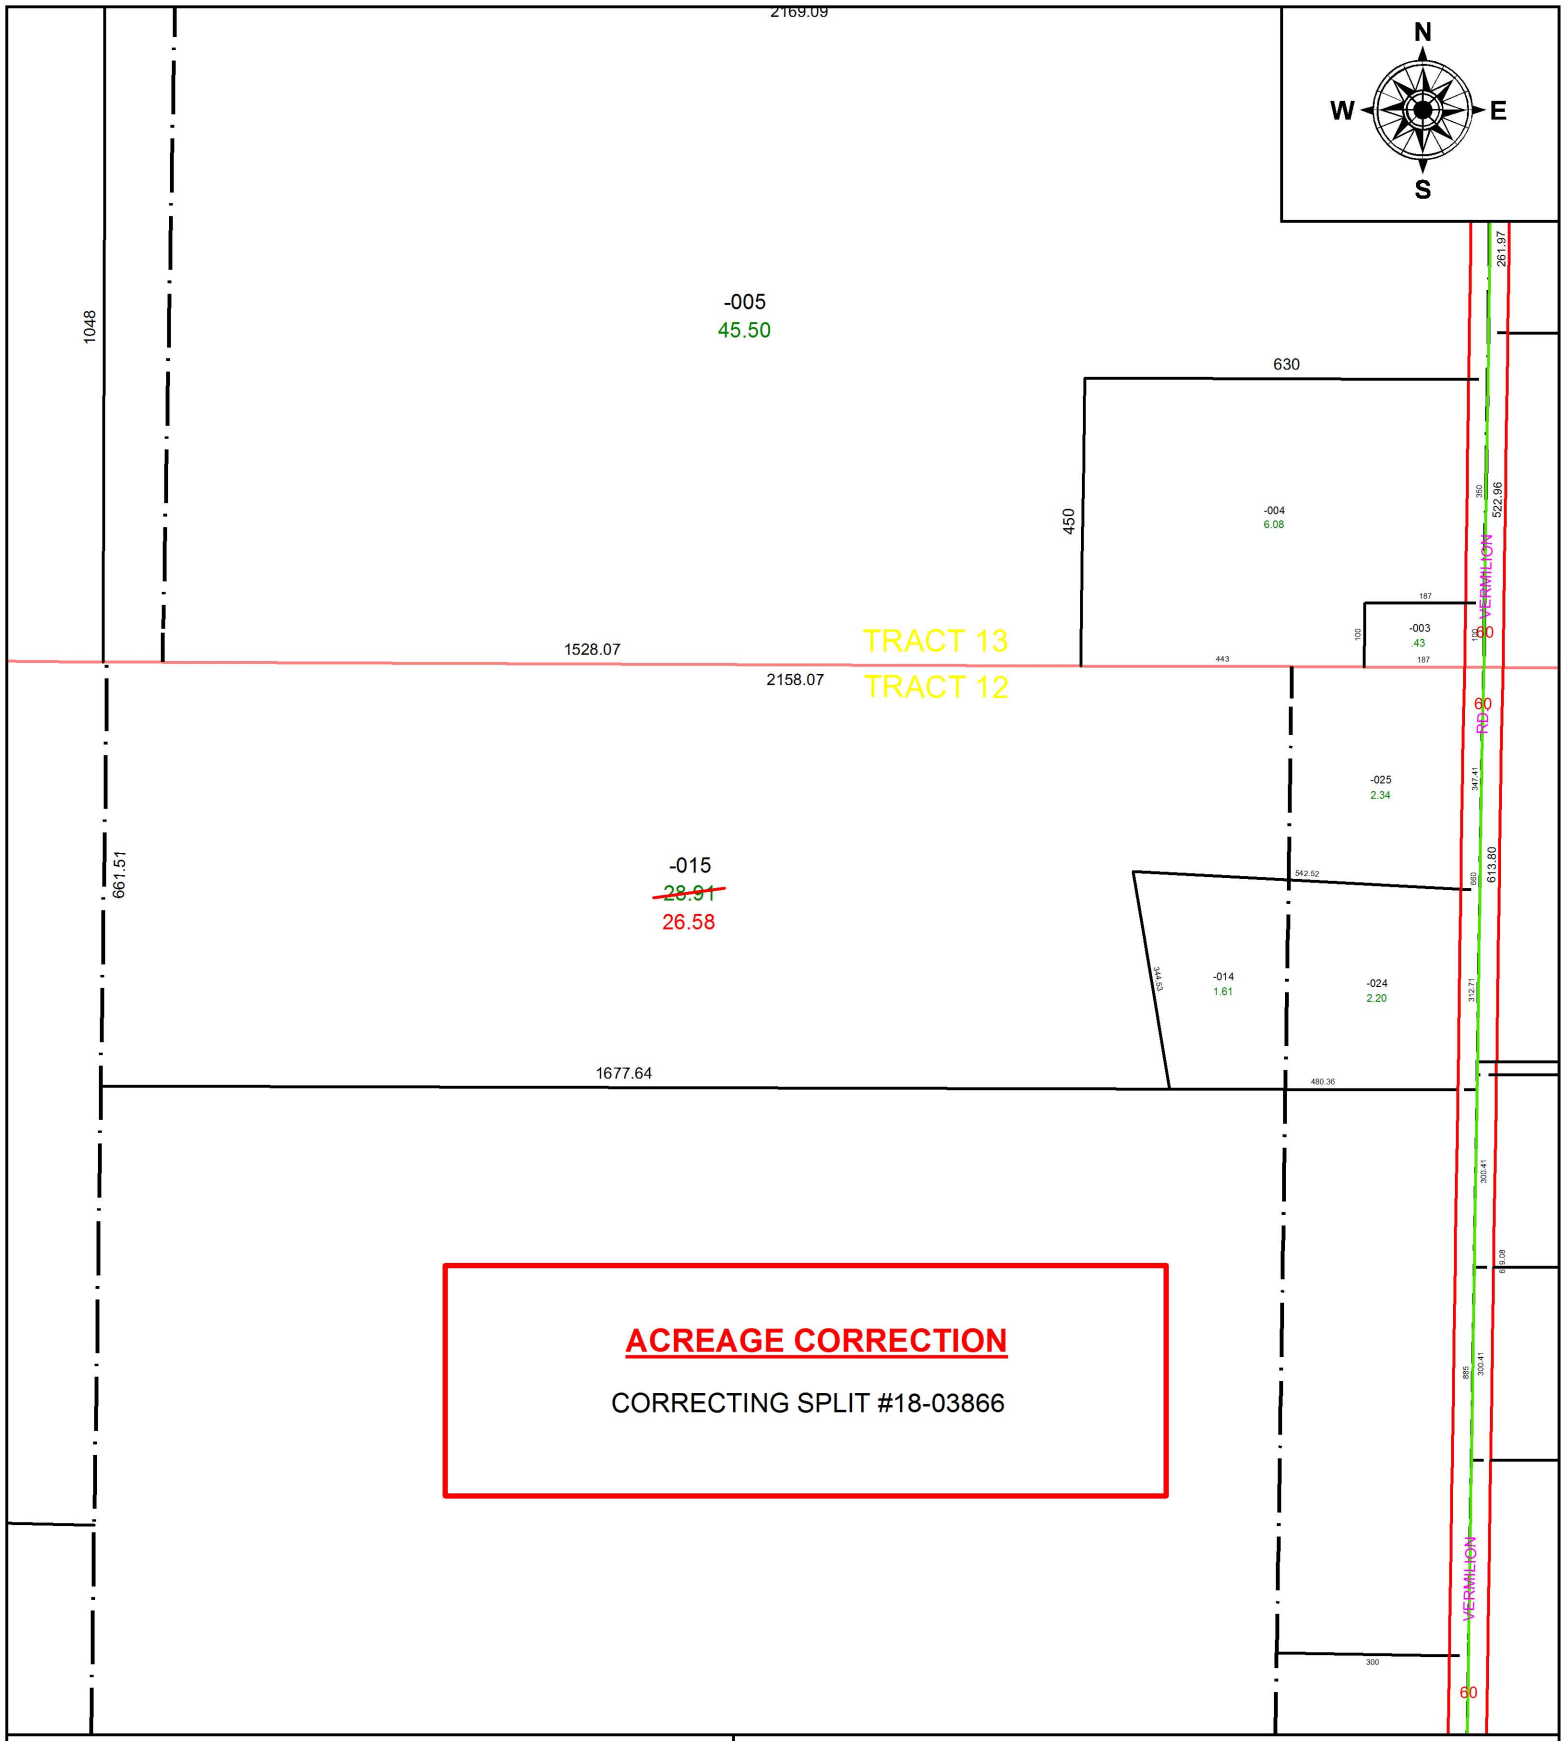

SPLITS/DEEDS PROCESSED

LORAIN COUNTY TAX MAP DEPARTMENT
226 MIDDLE AVE. ELYRIA, OH

SURVEYED BY: THOMAS A. SIMON
CLOSURE: 1: 861,673
MAP PAGE(S): 8-F
APPOVED BY: RRM **DATE:** 1-10-19
SCALE: 1" = 300 **PRIOR INSTRUMENT:** 20180685873