PARENT PARCEL: 02-03-006-102-011

CHILD PARCEL:

STARTING POINT: INTERSECTION OF C/L OF LONGBROOK RD. AND C/L OF YORKTOWN RD.

19-04021-D

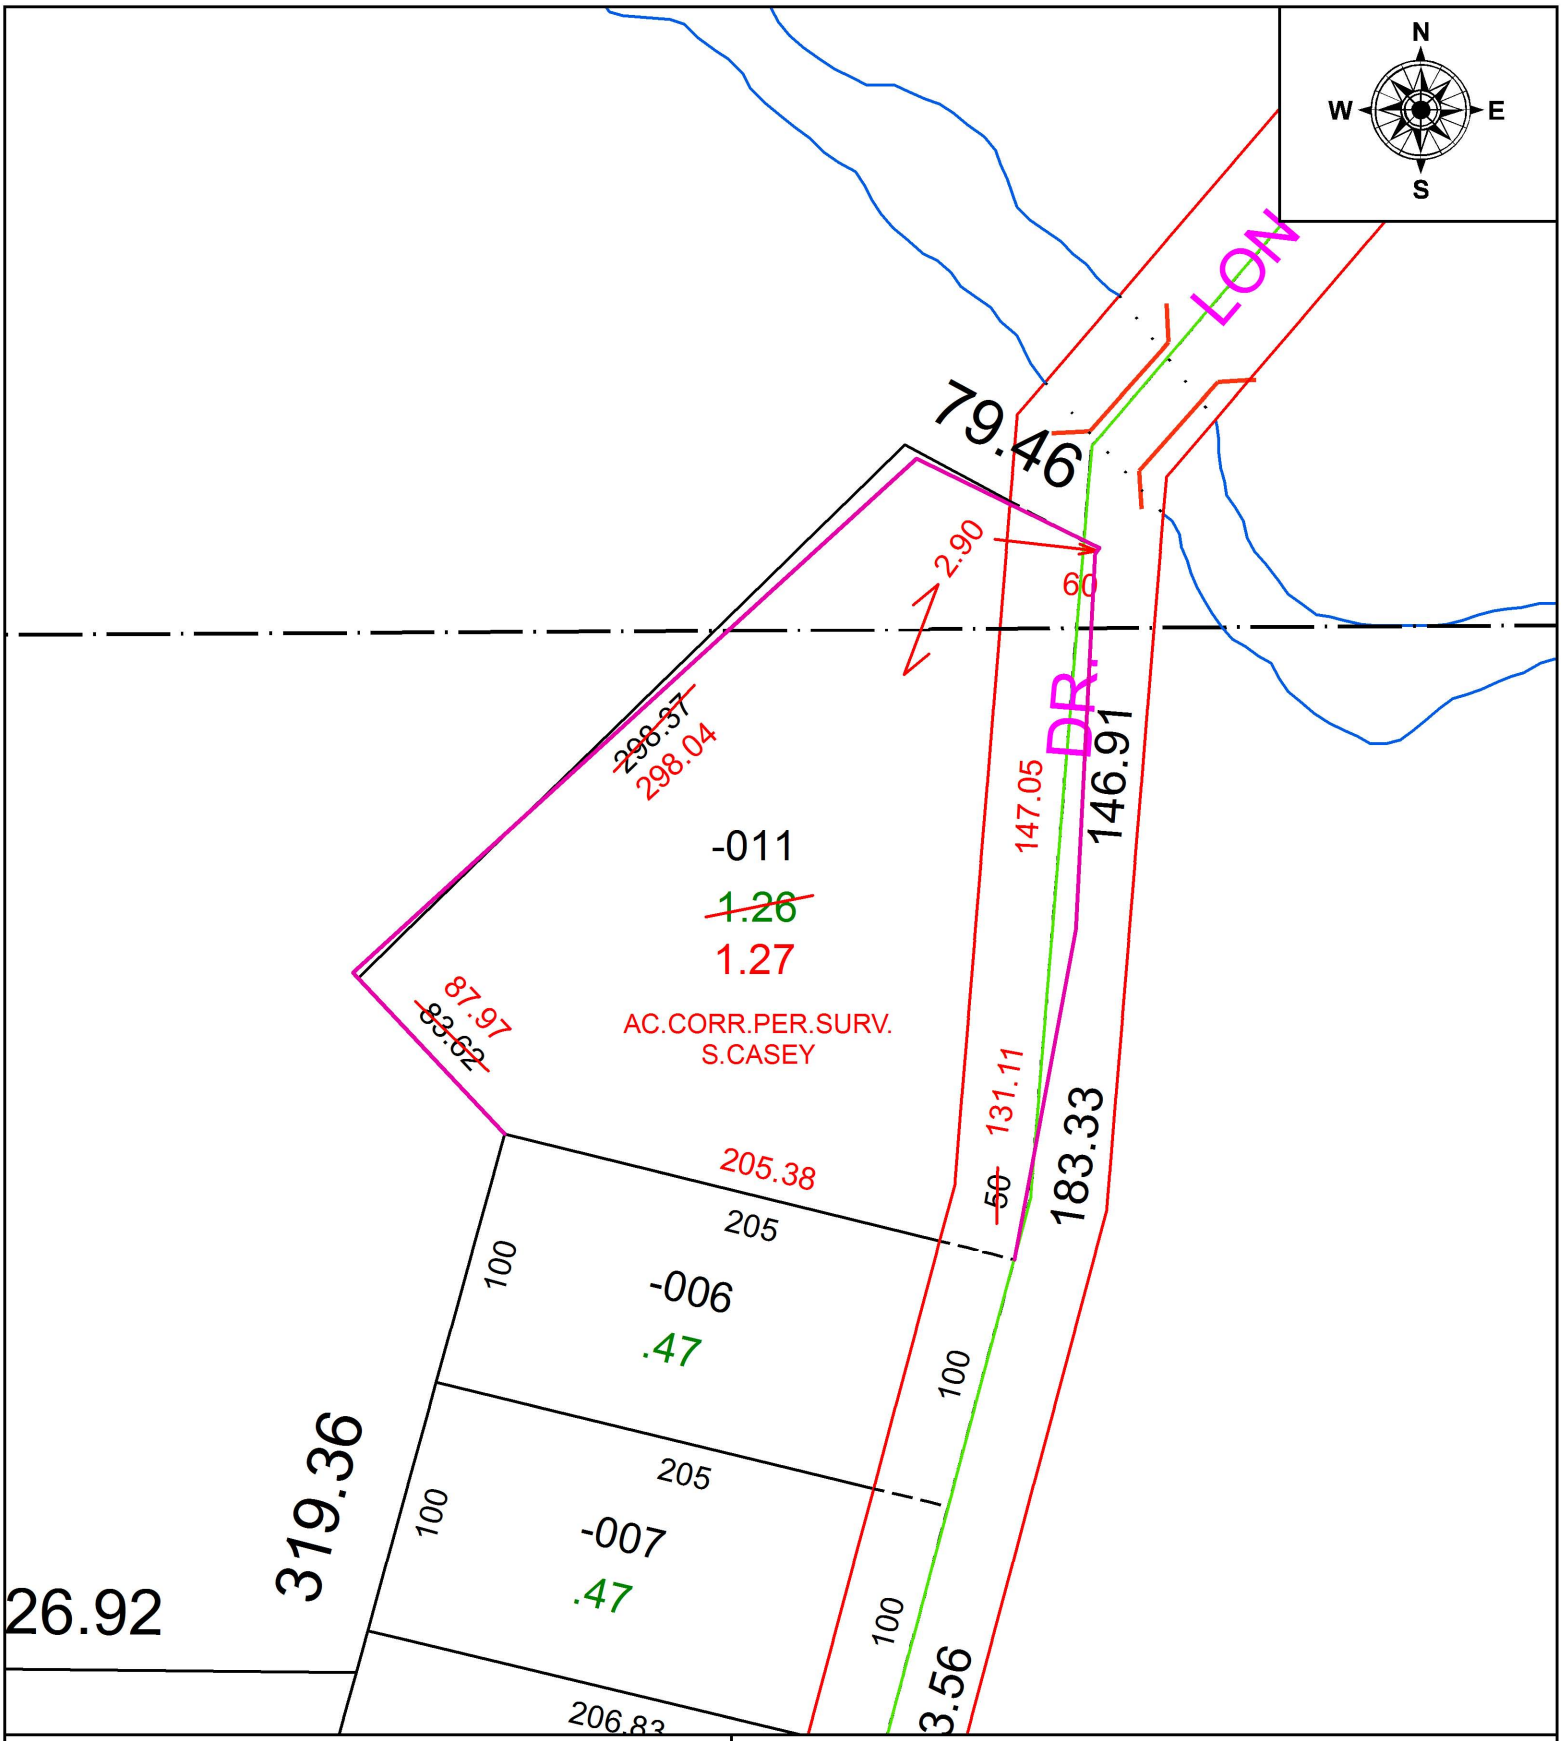

SPLITS/DEEDS PROCESSED

LORAIN COUNTY TAX MAP DEPARTMENT
226 MIDDLE AVE. ELYRIA, OH

SURVEYED BY: SCOTT J. CASEY
CLOSURE: 1: 250,159
MAP PAGE(S): 2-03-006
APPOVED BY: RRM **DATE:** 1-11-19
SCALE: 1" = 75 **PRIOR INSTRUMENT:** 20180669593