PARENT PARCEL: 03-00-076-112-001

CHILD PARCEL: 03-00-075-112-030, 03-00-076-112-012, -013

STARTING POINT: NORTHEAST CORNER OF S/L 516 IN LIBERTY SUBDIVISION

19-04021

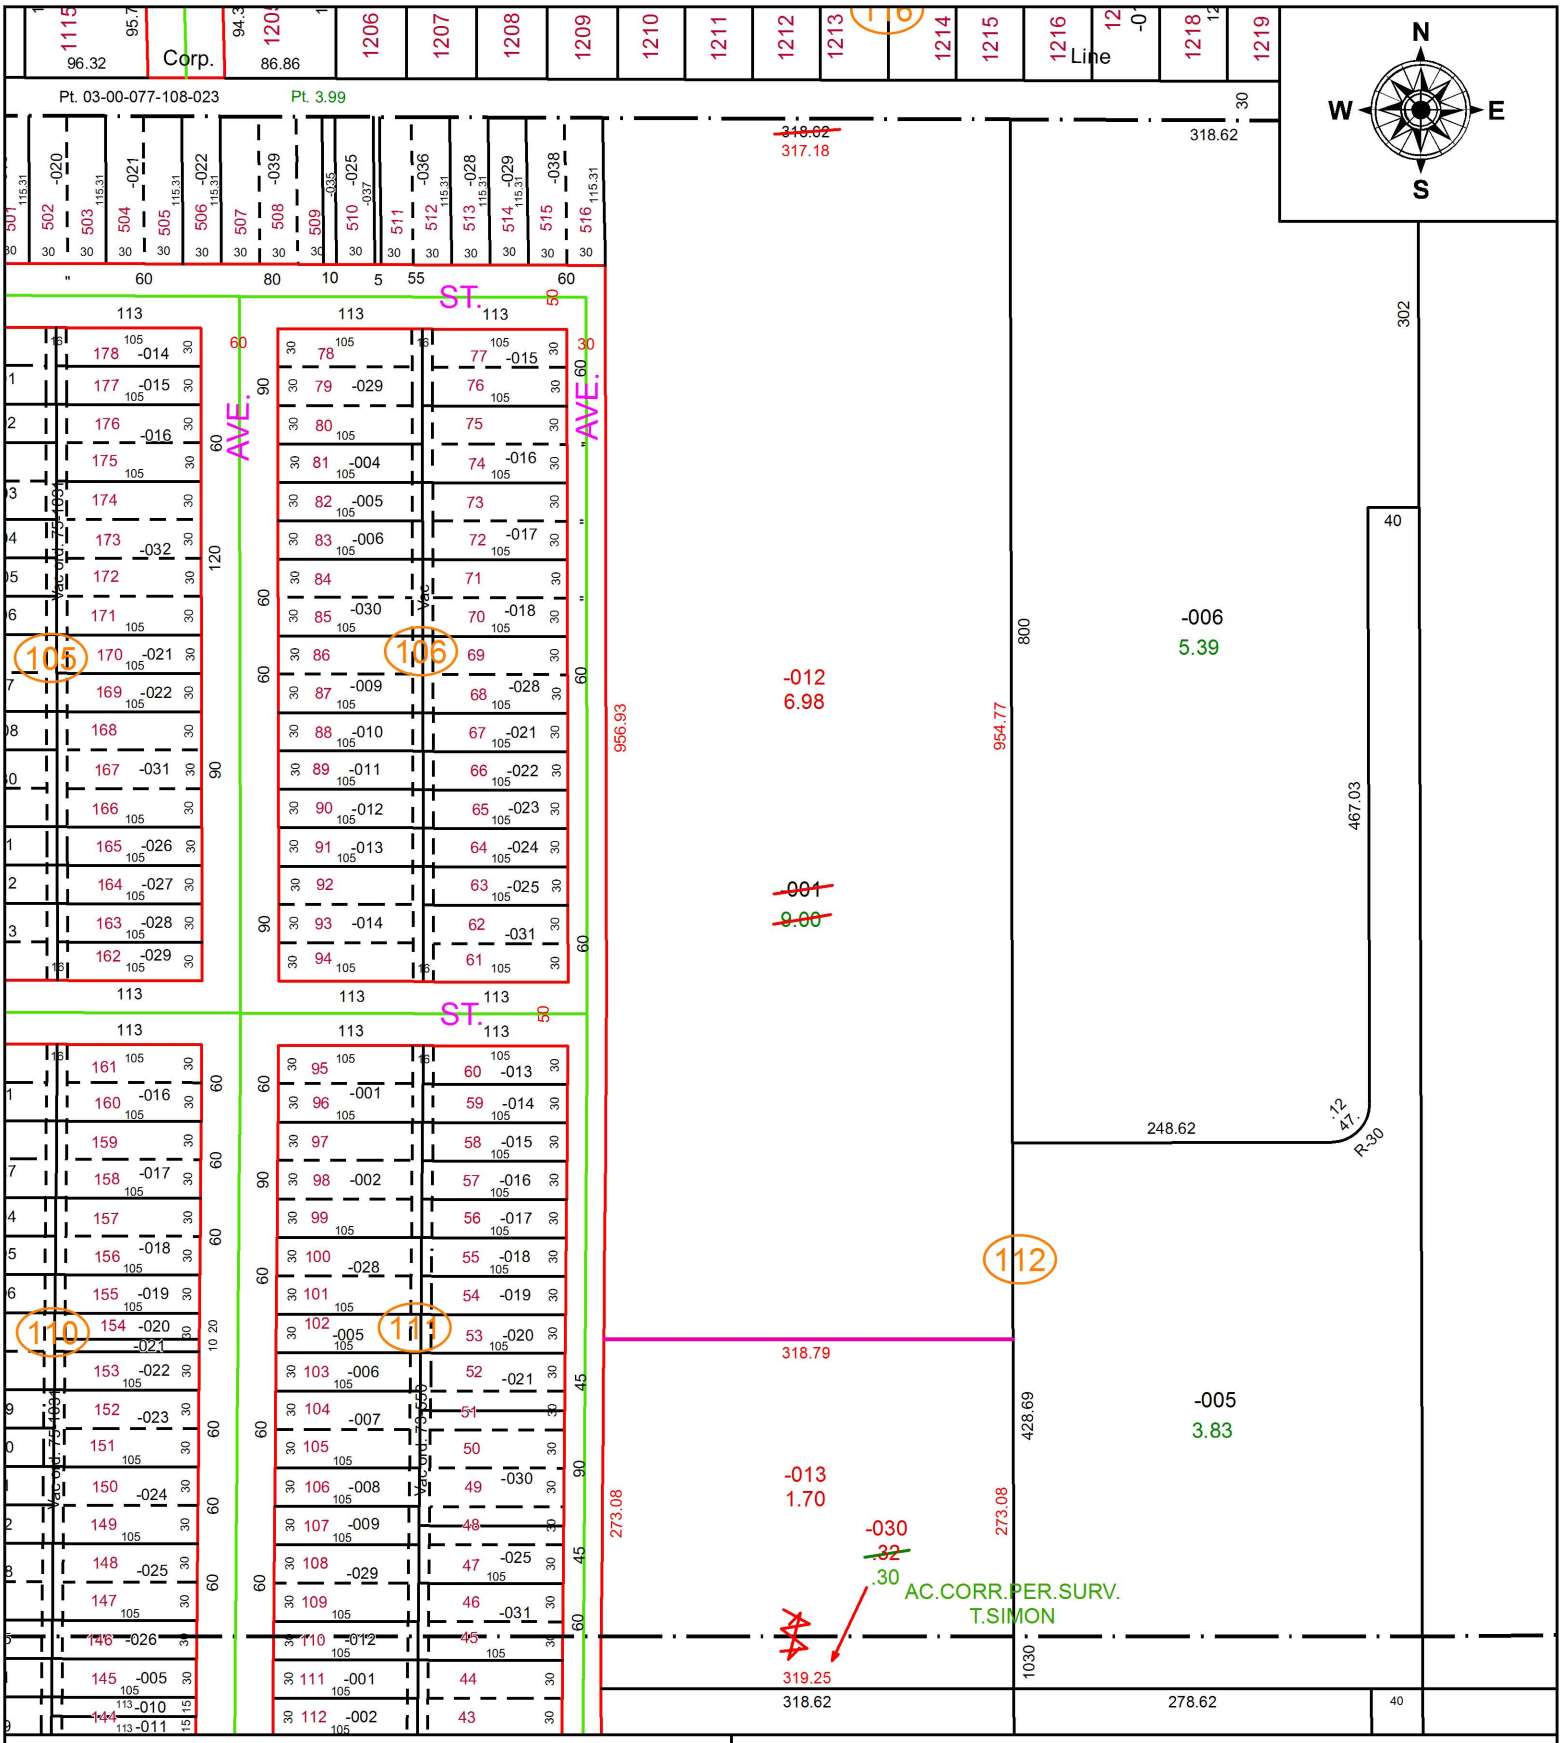

SPLITS/DEEDS PROCESSED

LORAIN COUNTY TAX MAP DEPARTMENT
226 MIDDLE AVE. ELYRIA, OH

SURVEYED BY: THOMAS A. SIMON
CLOSURE: 1: 1,857,947
MAP PAGE(S): 3-00-076
APPOVED BY: RRM **DATE:** 9-16-19
SCALE: 1" = 150 **PRIOR INSTRUMENT:** DV 1273/148