PARENT PARCEL: 07-00-005-106-084

CHILD PARCEL:

STARTING POINT: NORTHWEST CORNER OF LAND CONVEYED TO INA CAPELL (DV 126/82)

19-04024-A

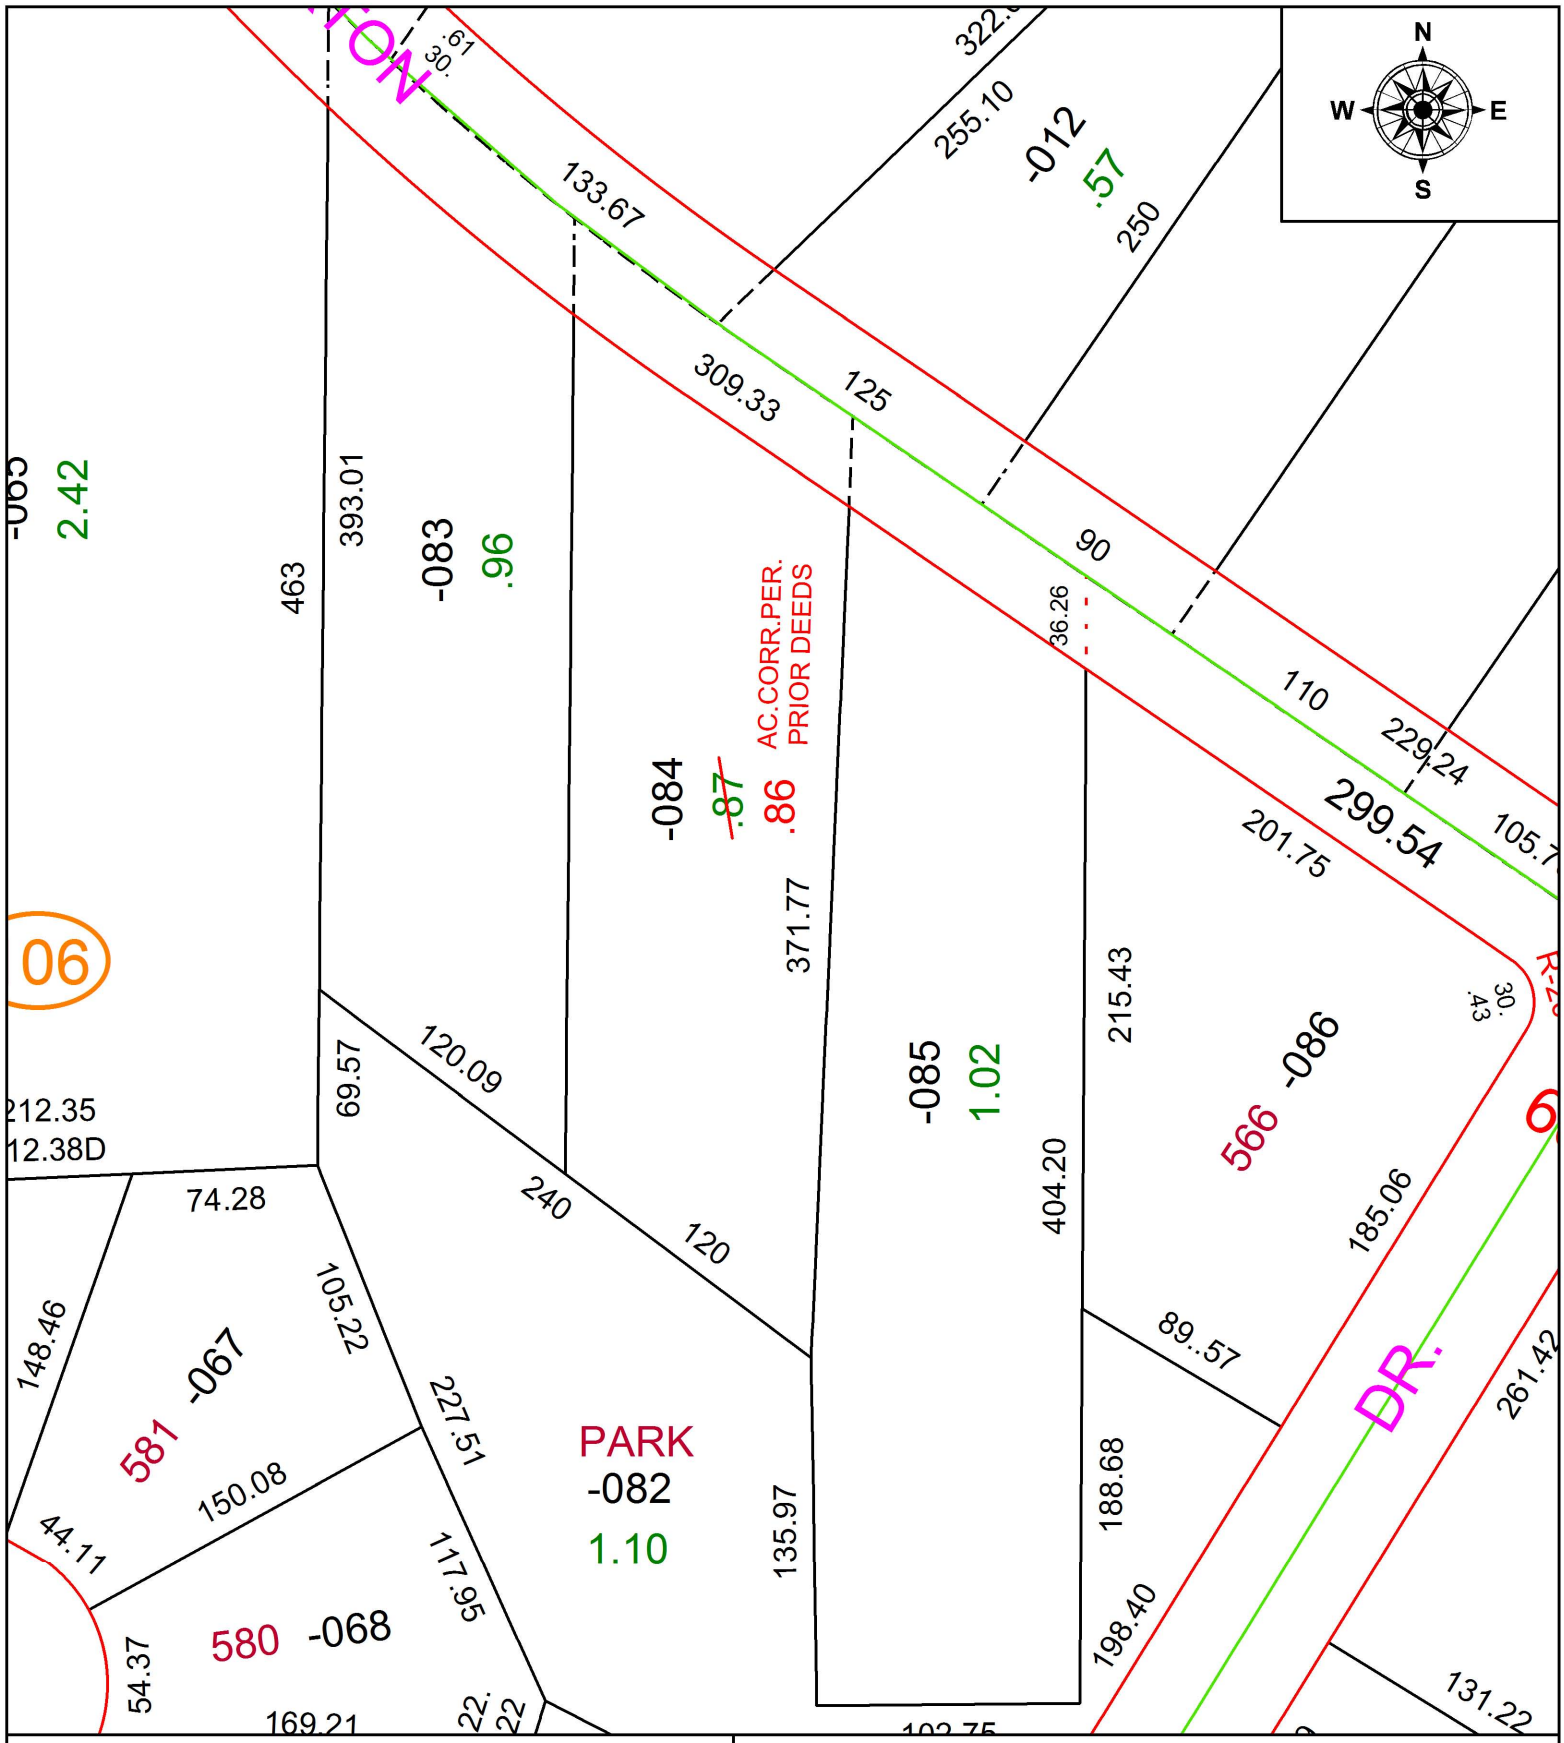

SPLITS/DEEDS PROCESSED

LORAIN COUNTY TAX MAP DEPARTMENT
226 MIDDLE AVE. ELYRIA, OH

SURVEYED BY: N/A
CLOSURE: N/A
MAP PAGE(S): 7-00-005
APPOVED BY: RRM **DATE:** 1-14-19
SCALE: 1" = 75 **PRIOR INSTRUMENT:** 20180659941