PARENT PARCEL: 03-00-041-113-051
CHILD PARCEL: 03-00-041-113-062, -063
STARTING POINT: S/L 120 & PART OF 121 IN COMMUNITY BEACH SUB. (PV 11/1)

19-04026-U

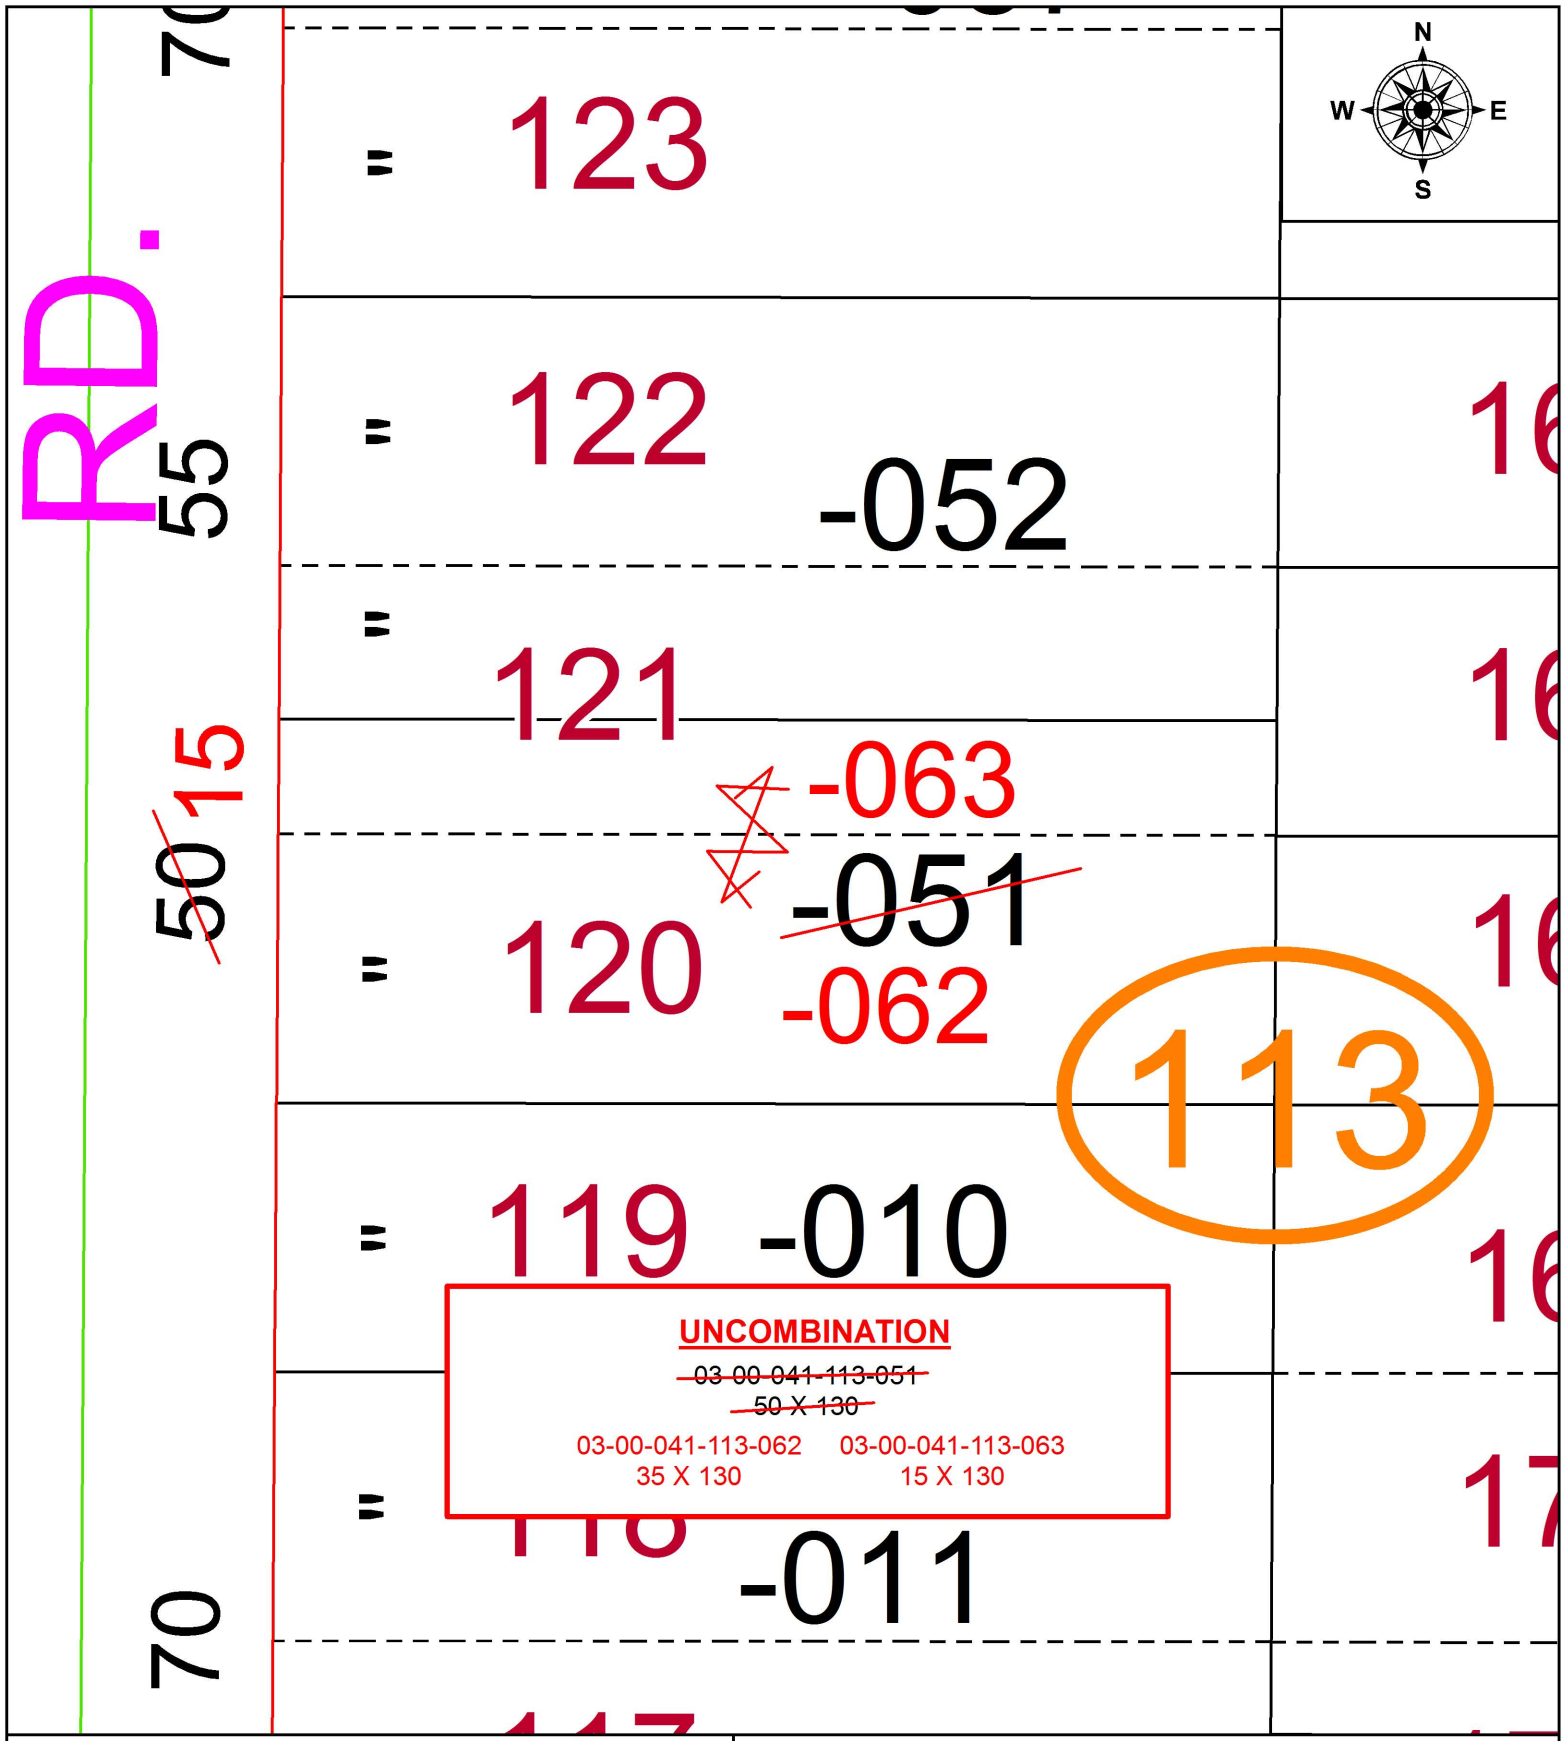

UNCOMBINATION

~~03-00-041-113-051~~
~~50 X 130~~

03-00-041-113-062 35 X 130
03-00-041-113-063 15 X 130

SPLITS/DEEDS PROCESSED
LORAIN COUNTY TAX MAP DEPARTMENT
226 MIDDLE AVE. ELYRIA, OH

SURVEYED BY: N/A
CLOSURE: N/A
MAP PAGE(S): 3-00-041
APPOVED BY: RRM **DATE:** 1-15-19
SCALE: 1" = 25 **PRIOR INSTRUMENT:** 20160596907