PARENT PARCEL: 08-12-018-000-010, -011

CHILD PARCEL: 08-12-018-000-027 THRU -029

STARTING POINT: SOUTHWEST CORNER OF O.L.18

19-04027

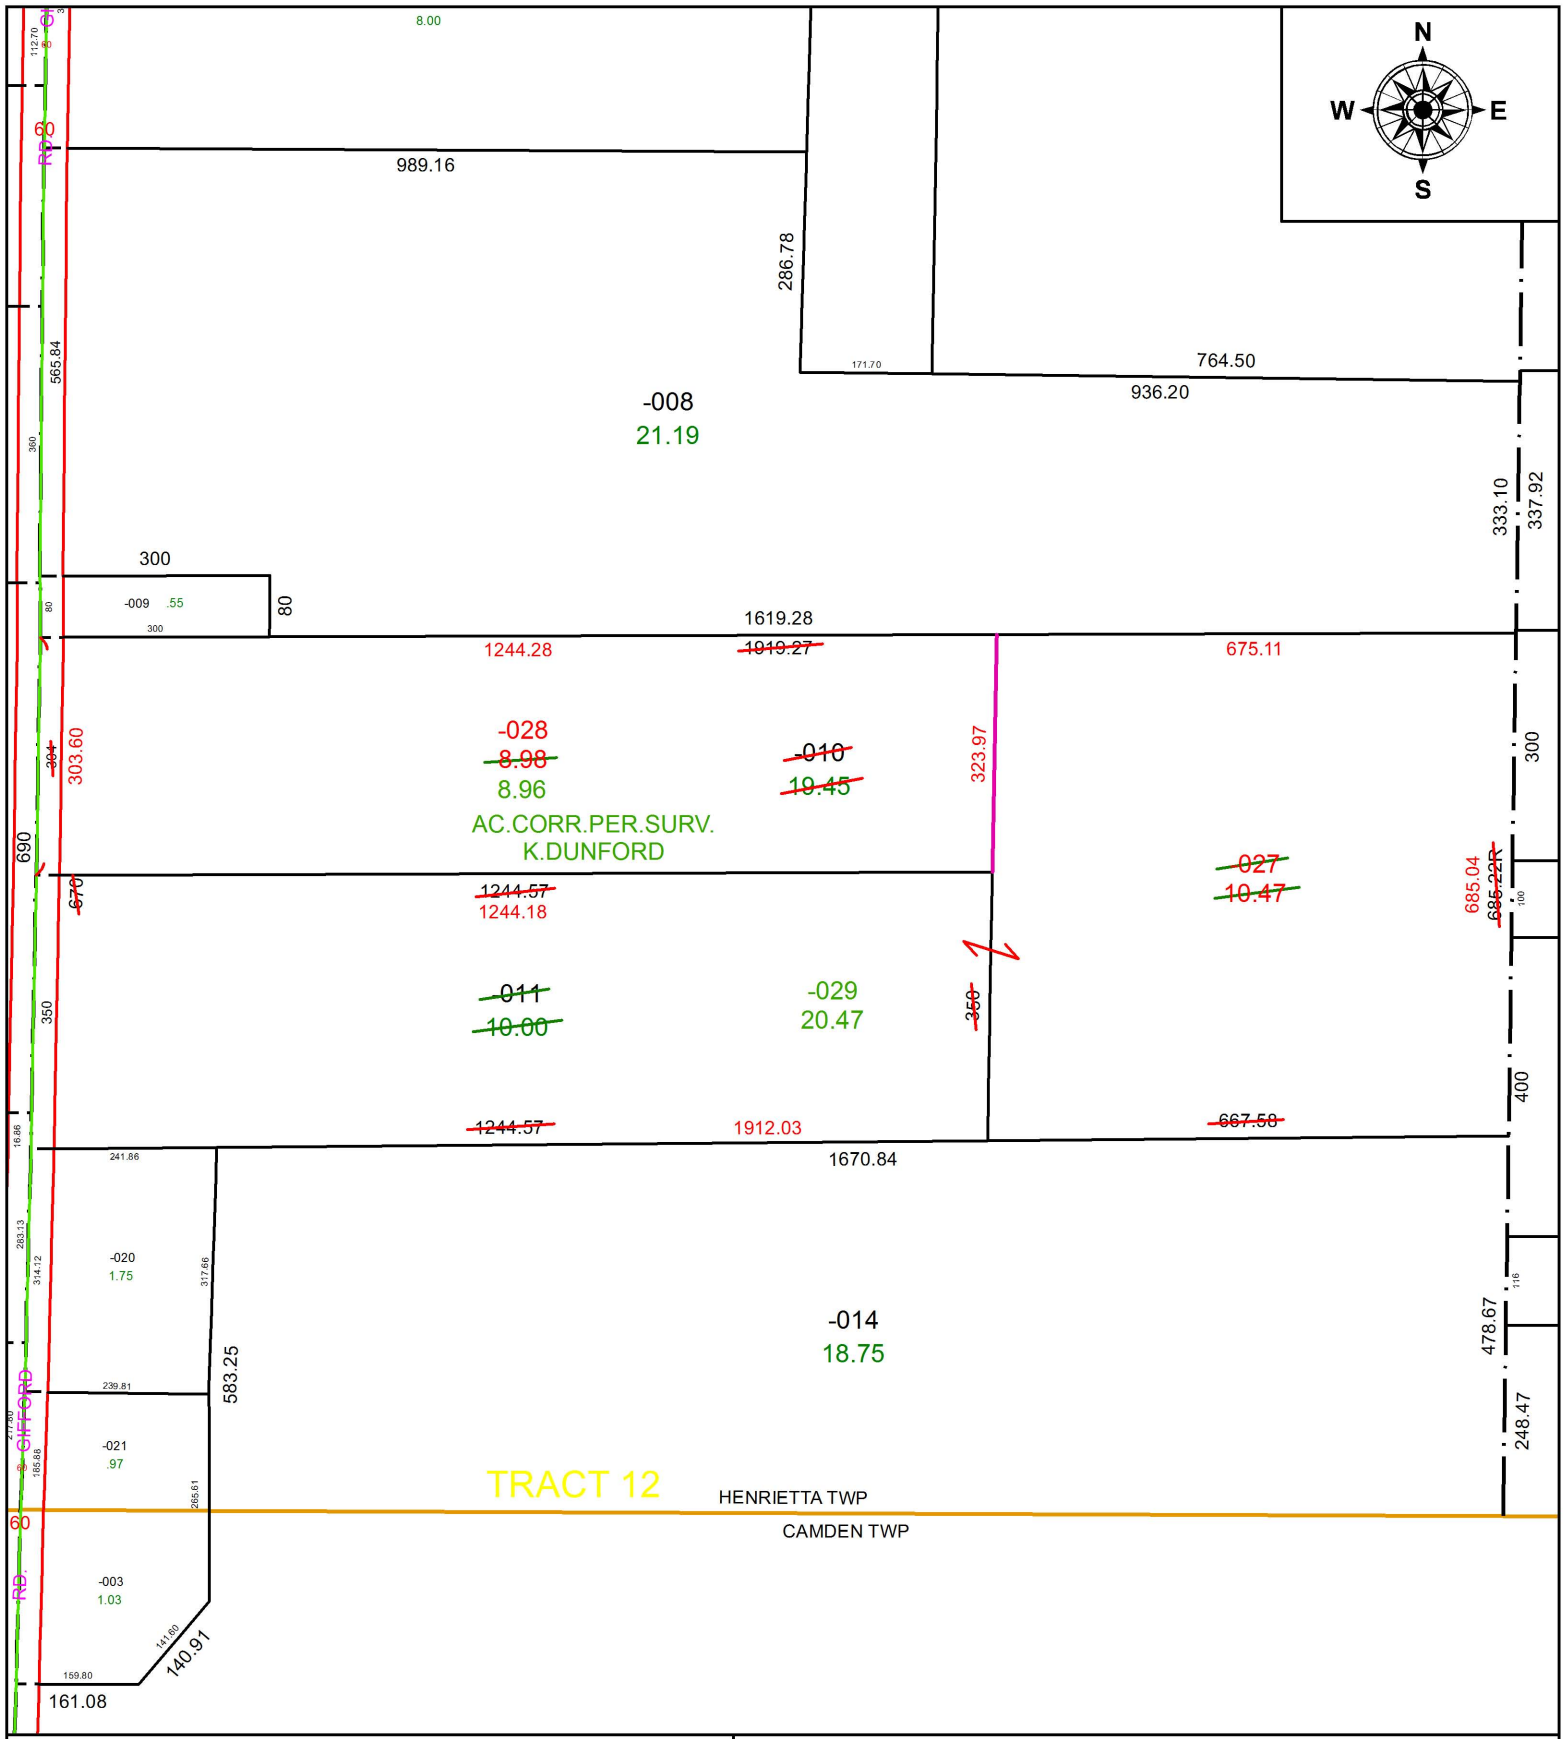

SPLITS/DEEDS PROCESSED

LORAIN COUNTY TAX MAP DEPARTMENT
226 MIDDLE AVE. ELYRIA, OH

SURVEYED BY: KELLY D. DUNFORD
CLOSURE: 1:558,408
MAP PAGE(S): 8-12-018
APPOVED BY: RRM **DATE:** 10-9-19
SCALE: 1" = 250 **PRIOR INSTRUMENT:** 19980578552