PARENT PARCEL: 06-24-023-105-011, -012

CHILD PARCEL:

STARTING POINT: INTERSECTION OF NORTH LINE OF LOWELL ST. AND C/L OF MURRAY RIDGE RD.

19-04029-A

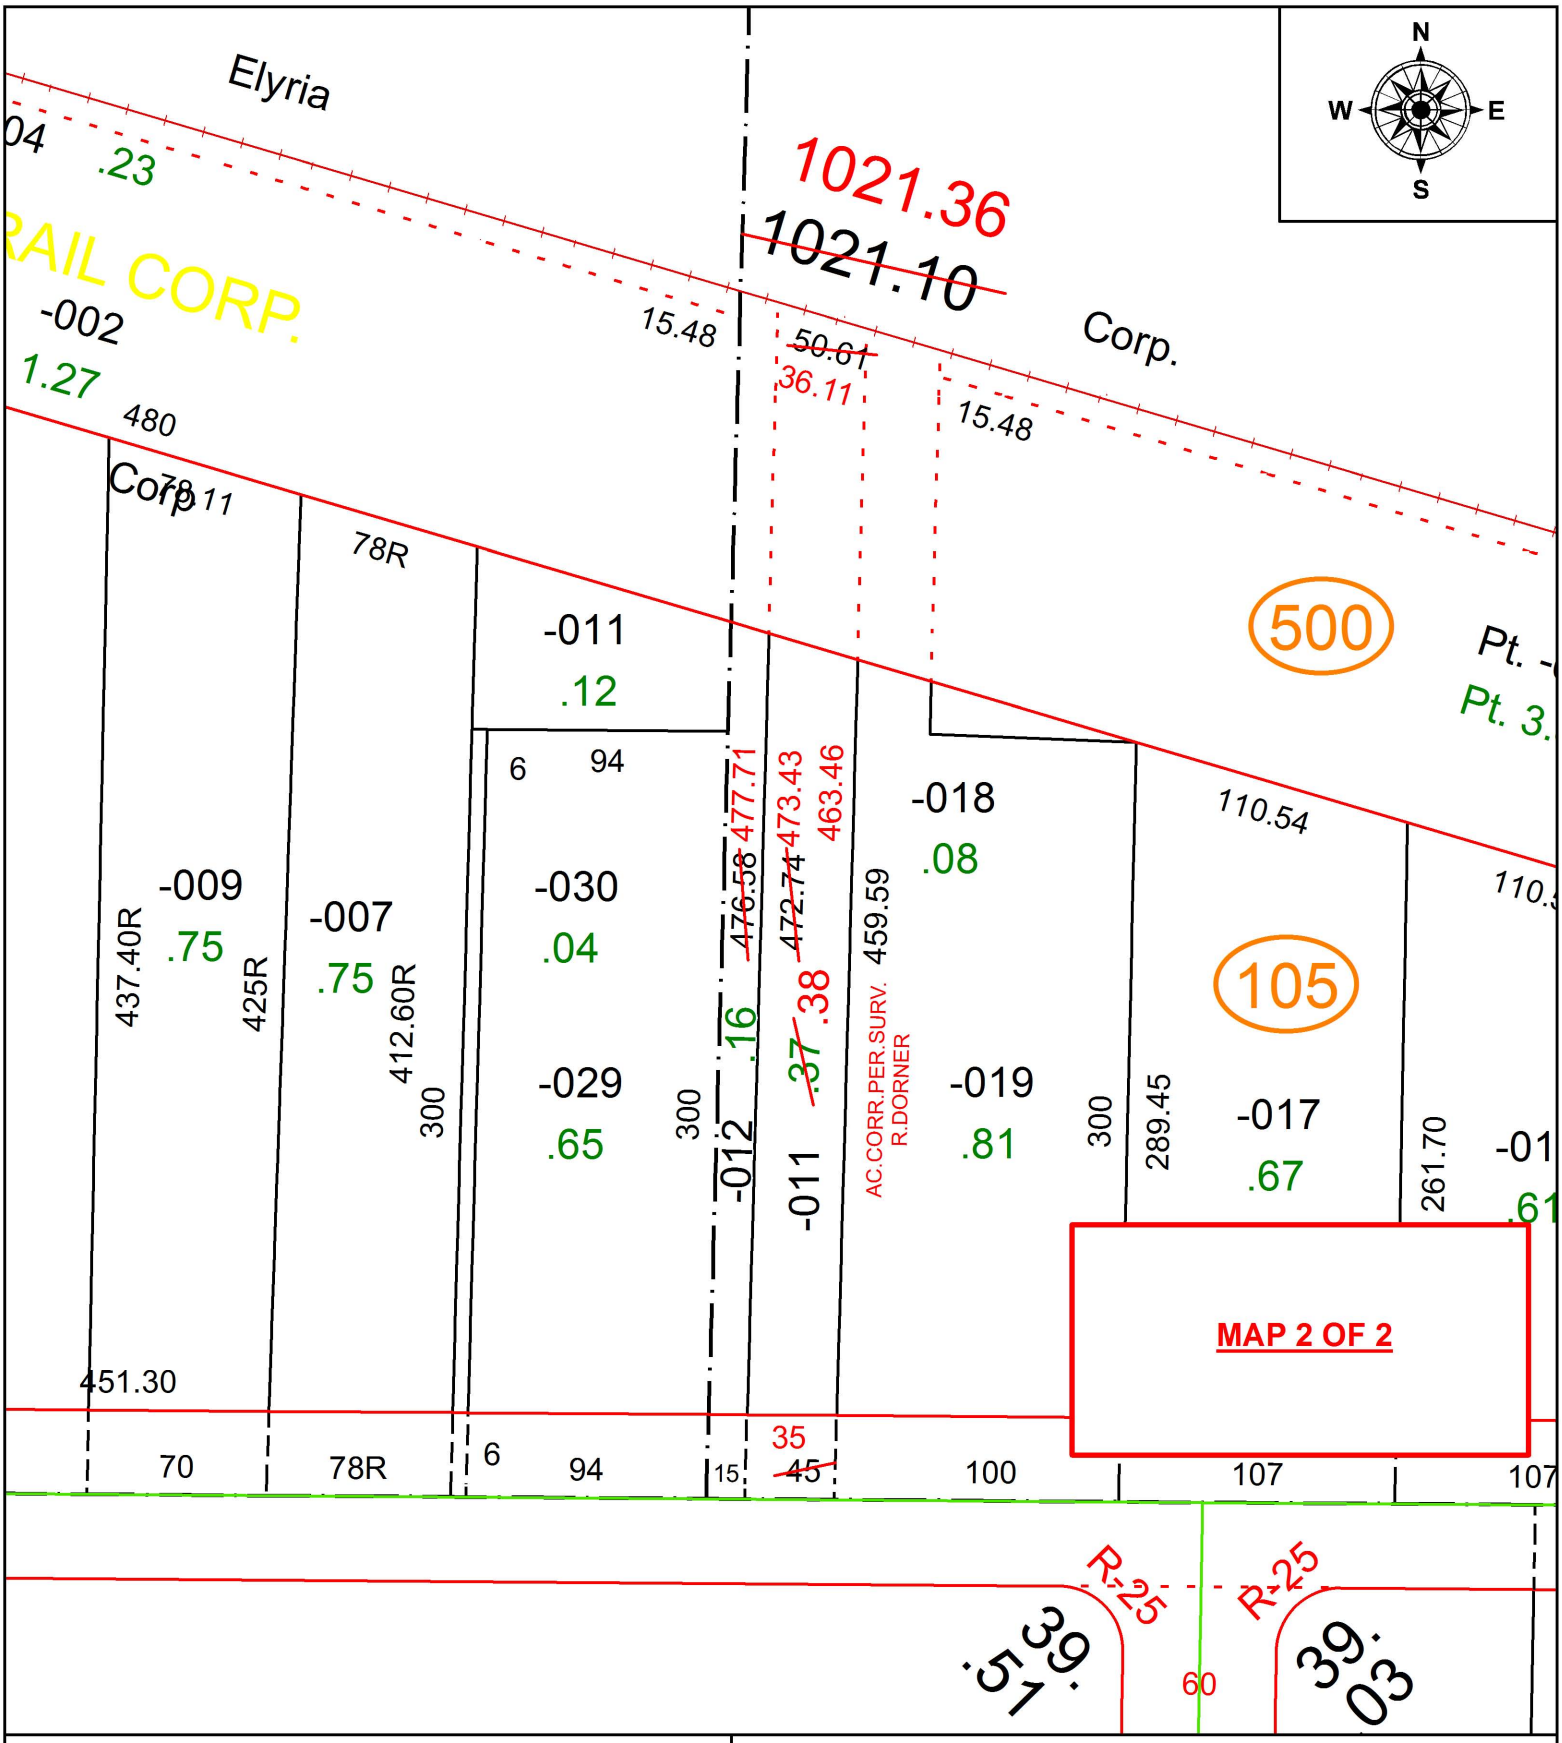

MAP 2 OF 2

SPLITS/DEEDS PROCESSED

LORAIN COUNTY TAX MAP DEPARTMENT
226 MIDDLE AVE. ELYRIA, OH

SURVEYED BY: ROBERT A. DORNER
CLOSURE: 1:363,193
MAP PAGE(S): 6-24-023
APPOVED BY: RRM **DATE:** 1-16-19
SCALE: 1" = 75 **PRIOR INSTRUMENT:** 20180681930