PARENT PARCEL: 06-24-037-107-012, -015 THRU -017

CHILD PARCEL: 06-24-037-107-020, -021

STARTING POINT: INTERSECTION OF C/L OF LAKE AVE AND SOUTH LINE OF O.L.37

19-04030-C

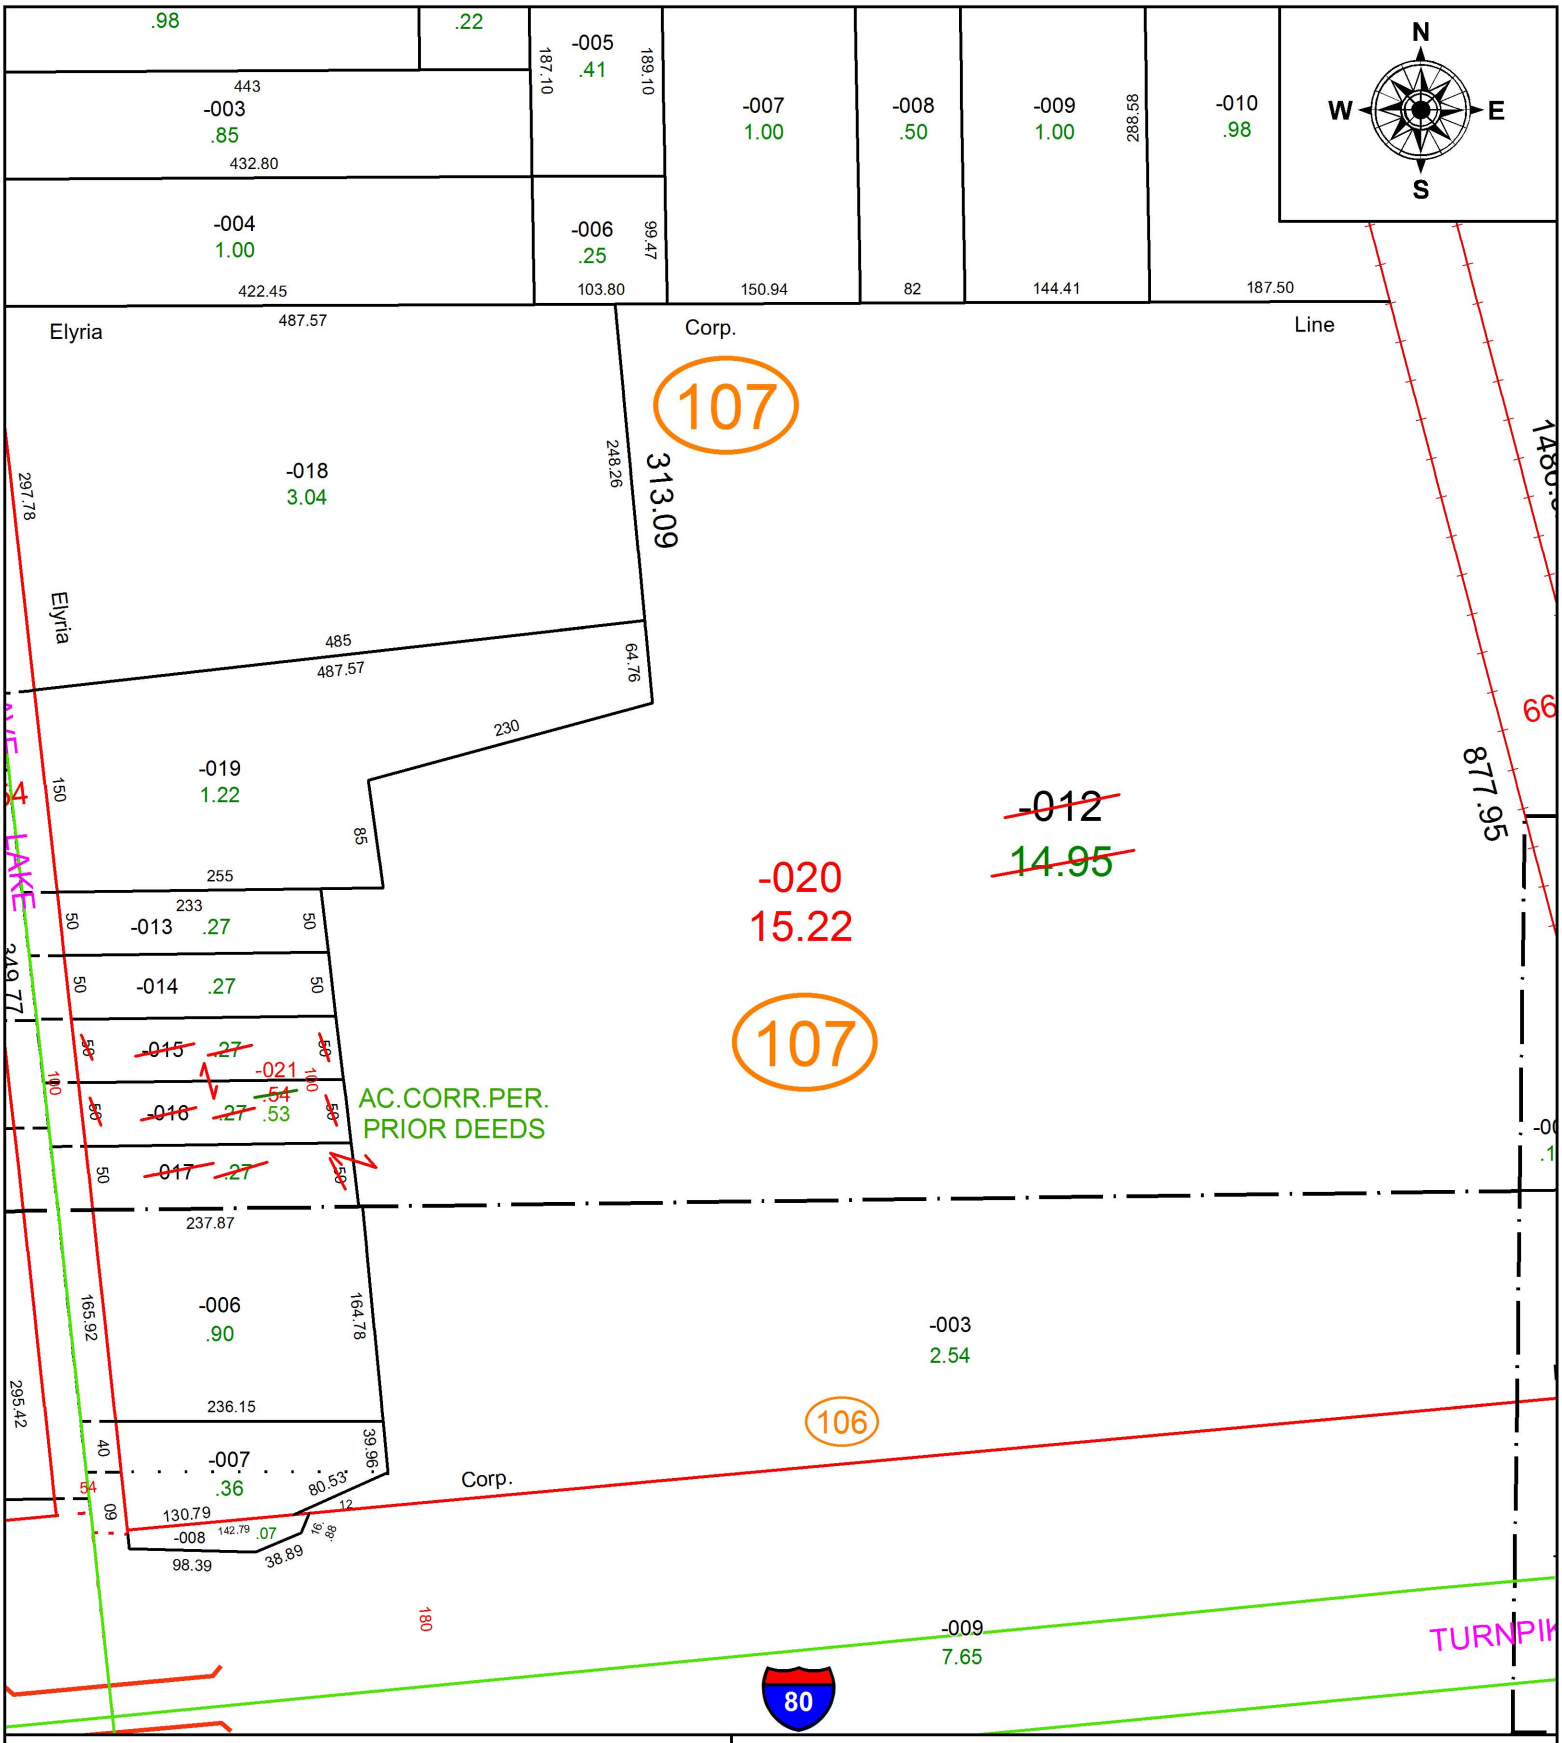

SPLITS/DEEDS PROCESSED

LORAIN COUNTY TAX MAP DEPARTMENT
226 MIDDLE AVE. ELYRIA, OH

SURVEYED BY: N/A
CLOSURE: 1:2147483648
MAP PAGE(S): 6-24-037
APPOVED BY: RRM **DATE:** 1-18-19
SCALE: 1" = 150 **PRIOR INSTRUMENT:** 20190700272