PARENT PARCEL: 15-00-099-103-122, -125

CHILD PARCEL: 15-00-099-103-122, -179, -180

STARTING POINT: NORTHEAST CORNER OF S/L 134 IN PHEASANT RUN VILLAGE PH.1

19-04031

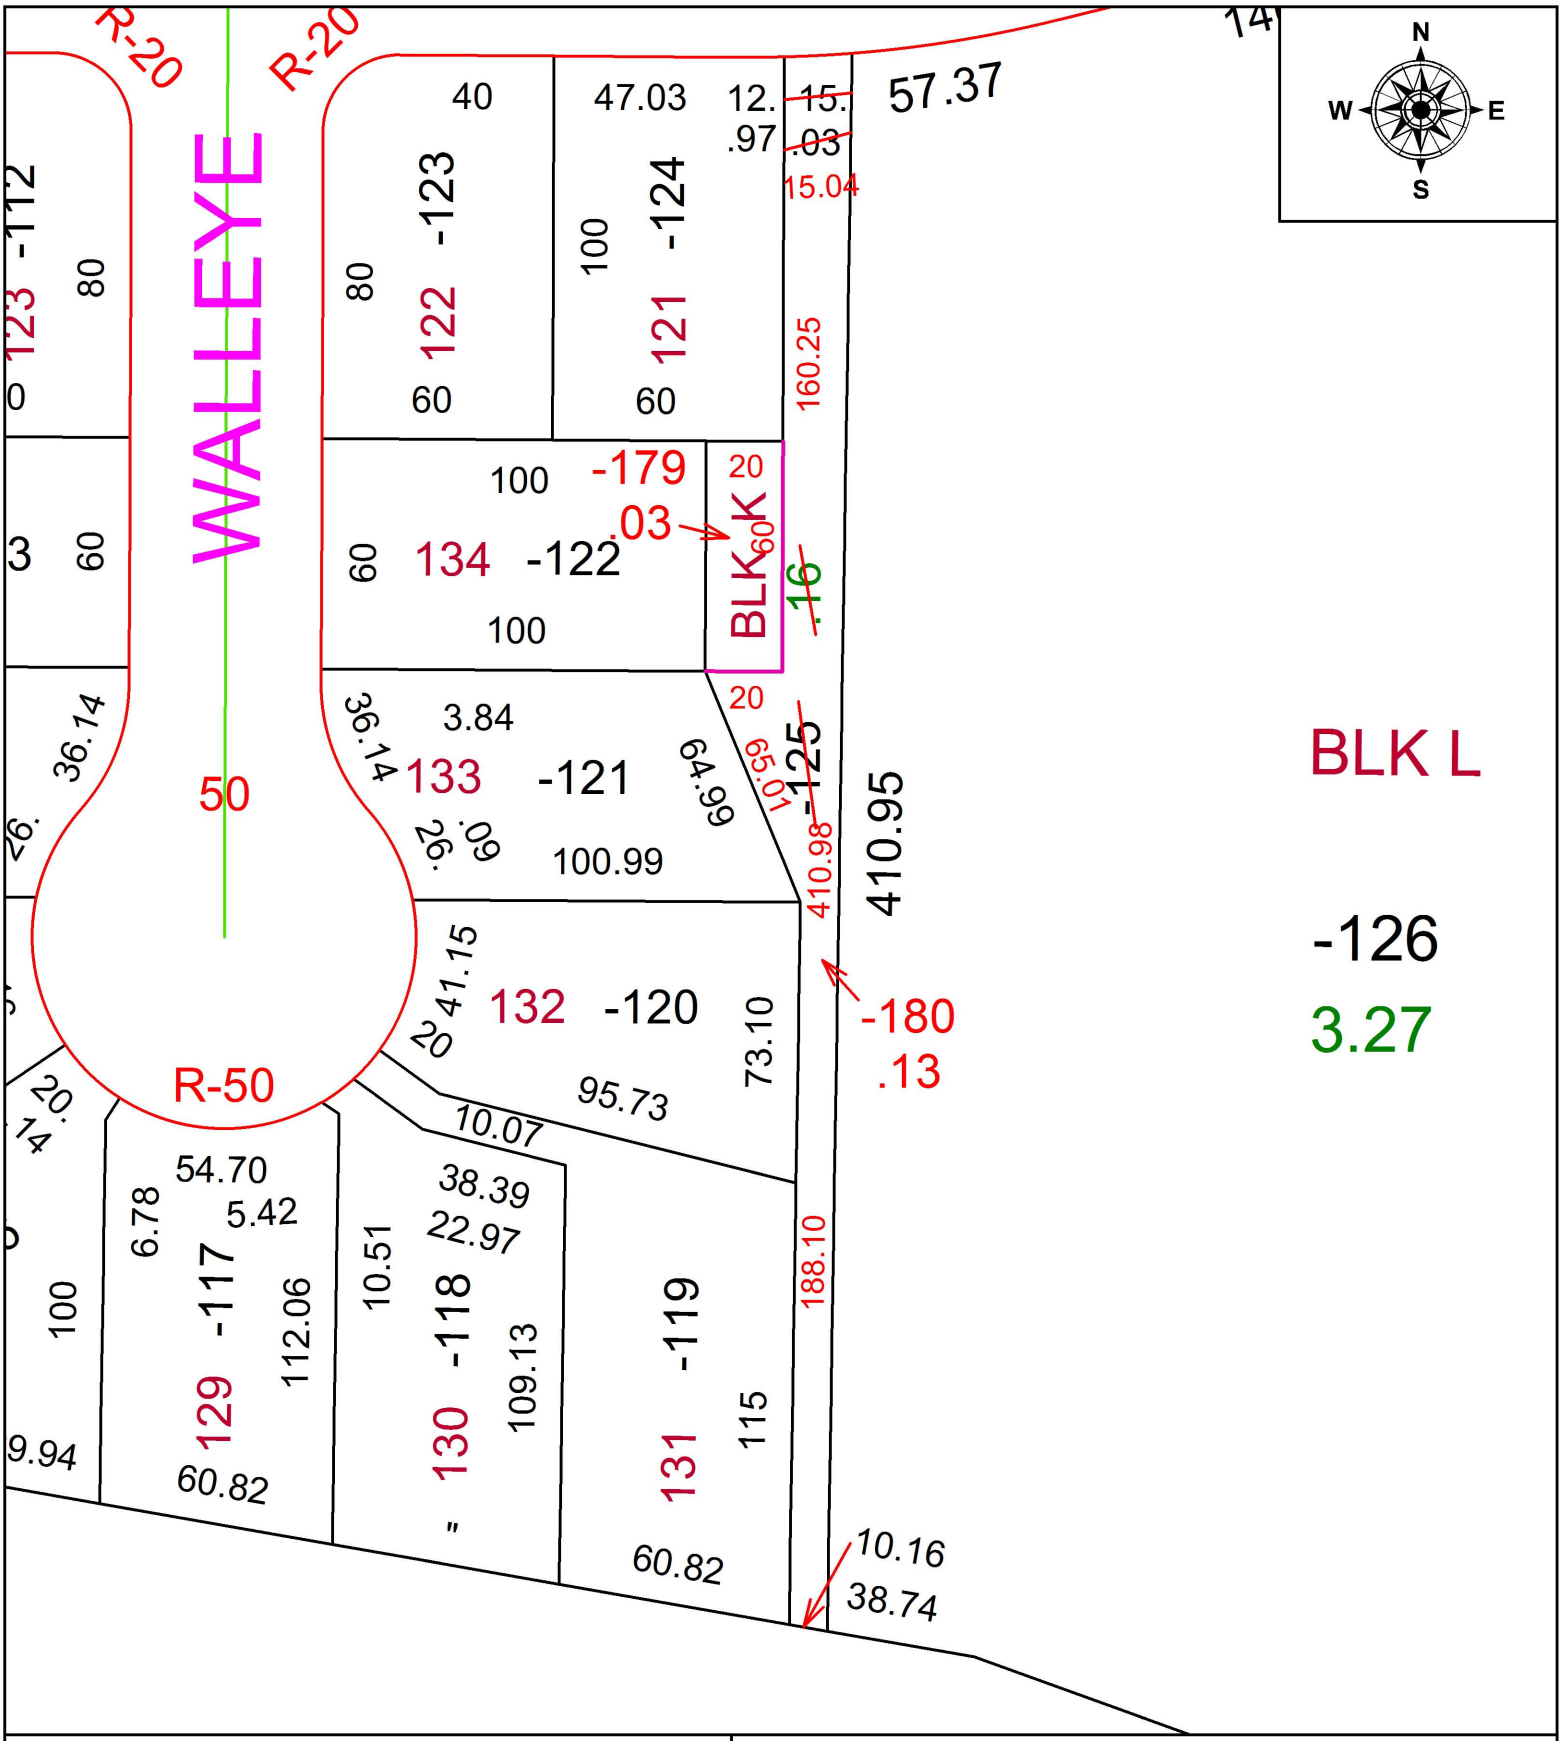

SPLITS/DEEDS PROCESSED

LORAIN COUNTY TAX MAP DEPARTMENT
226 MIDDLE AVE. ELYRIA, OH

SURVEYED BY: THOMAS A. SIMON
CLOSURE: 1:125,412
MAP PAGE(S): 15-00-099
APPOVED BY: RRM **DATE:** 10-16-19
SCALE: 1" = 50 **PRIOR INSTRUMENT:** 20150554268