PARENT PARCEL: 15-00-099-101-208, -238
CHILD PARCEL: 15-00-099-101-208, -239, -240
STARTING POINT: SOUTHWEST CORNER OF S/L 530 IN PHEASANT RUN VILLAGE PH. 1 REV.2

19-04033

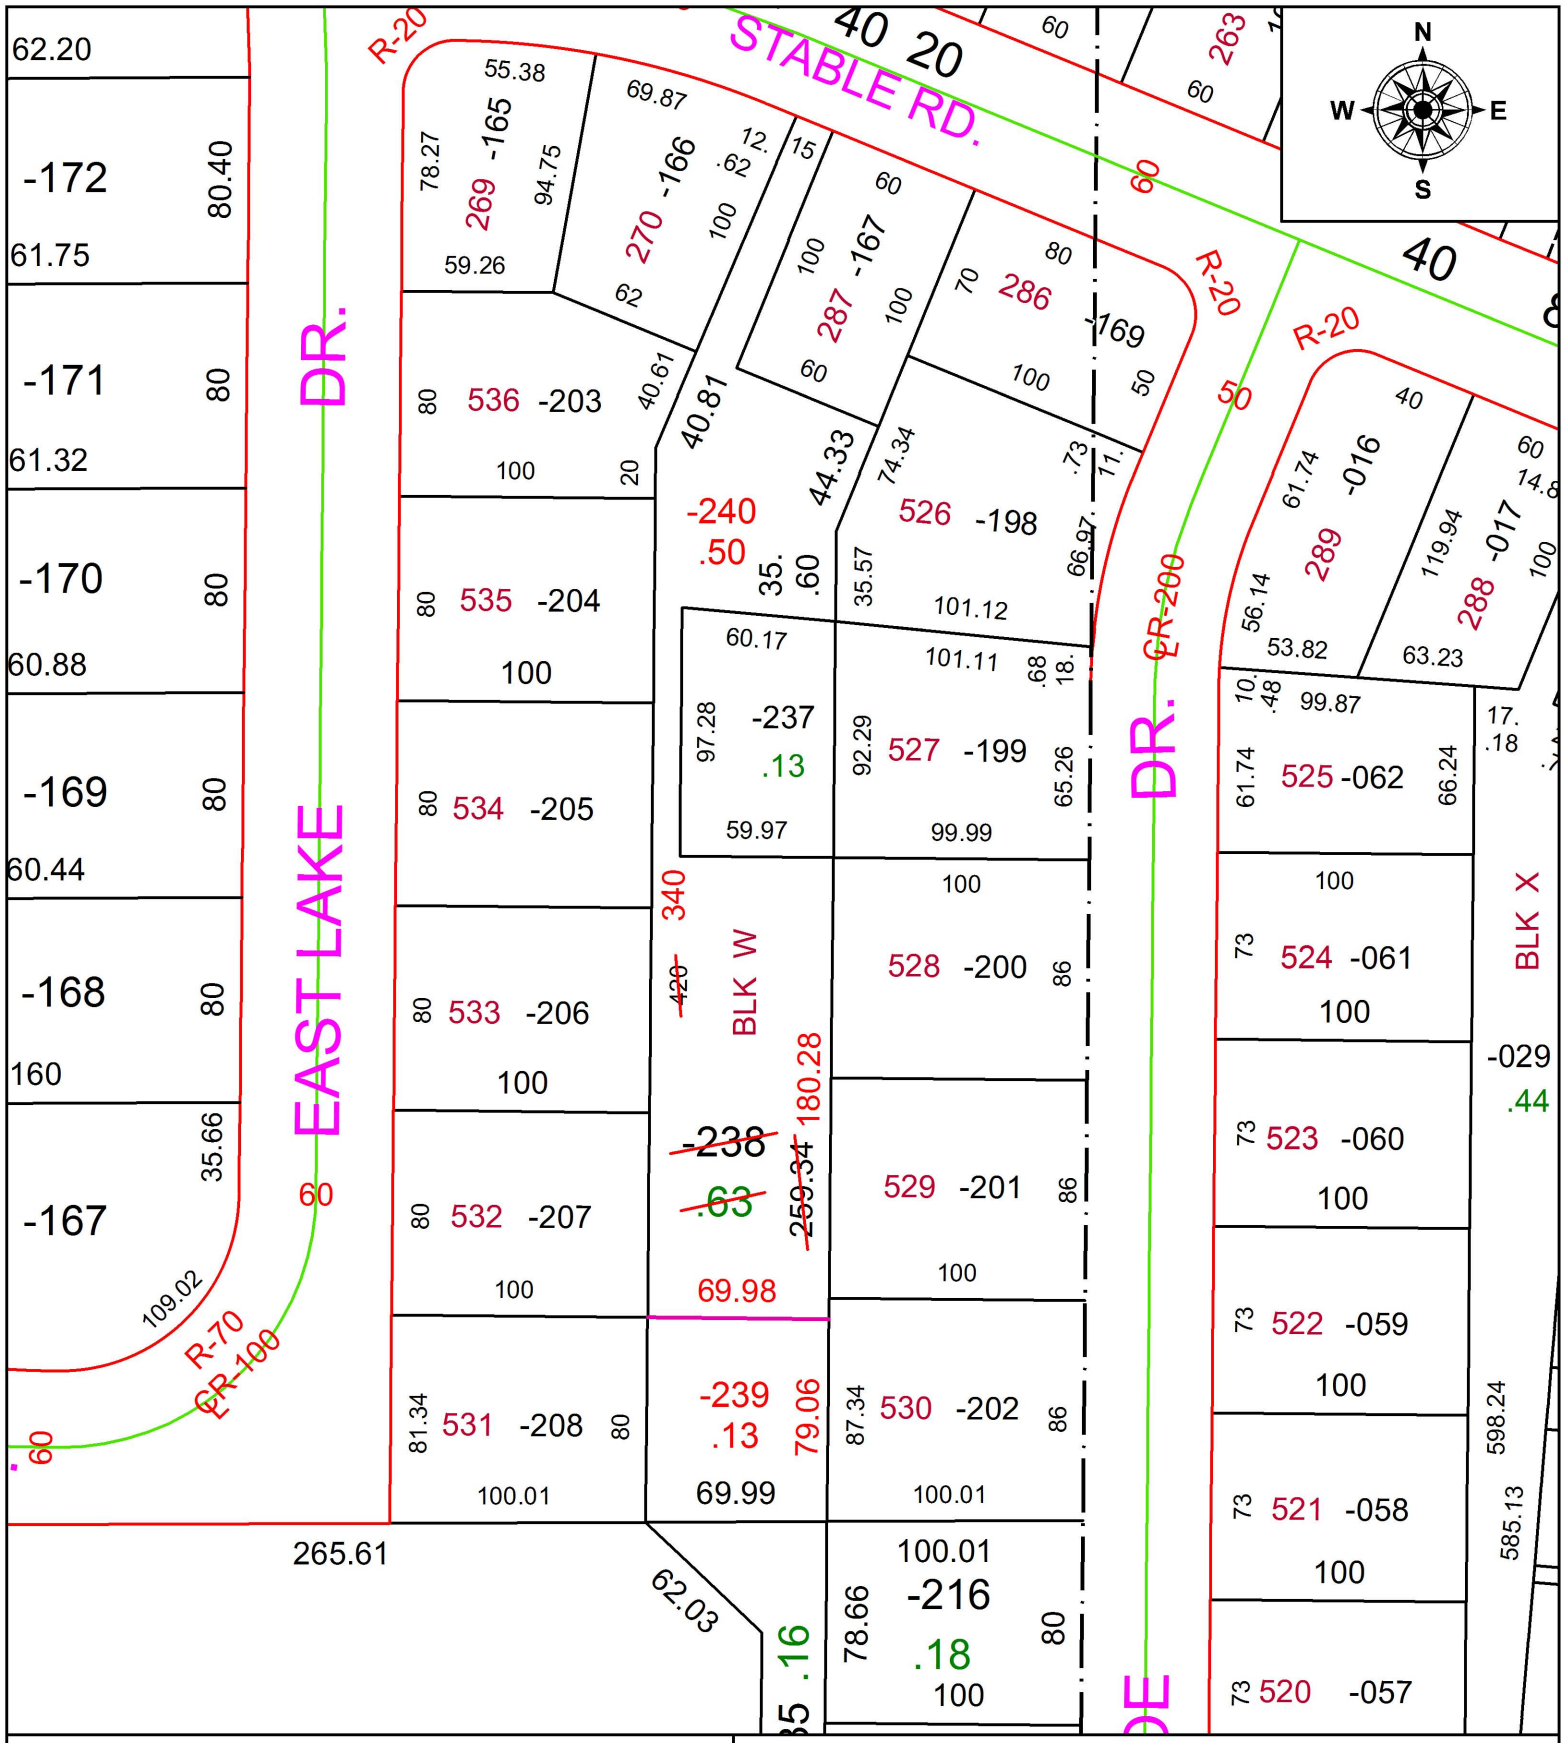

SPLITS/DEEDS PROCESSED
LORAIN COUNTY TAX MAP DEPARTMENT
226 MIDDLE AVE. ELYRIA, OH

SURVEYED BY: THOMAS A. SIMON
CLOSURE: 1:515,854
MAP PAGE(S): 15-00-099
APPOVED BY: RRM **DATE:** 10-16-19
SCALE: 1" = 75 **PRIOR INSTRUMENT:** 20180658799