PARENT PARCEL: 05-00-051-000-001

CHILD PARCEL: 05-00-051-000-029 THRU -033

STARTING POINT: INTERSECTION OF NORTH LINE OF O.L.51 AND C/L OF OBERLIN RD.

19-04036

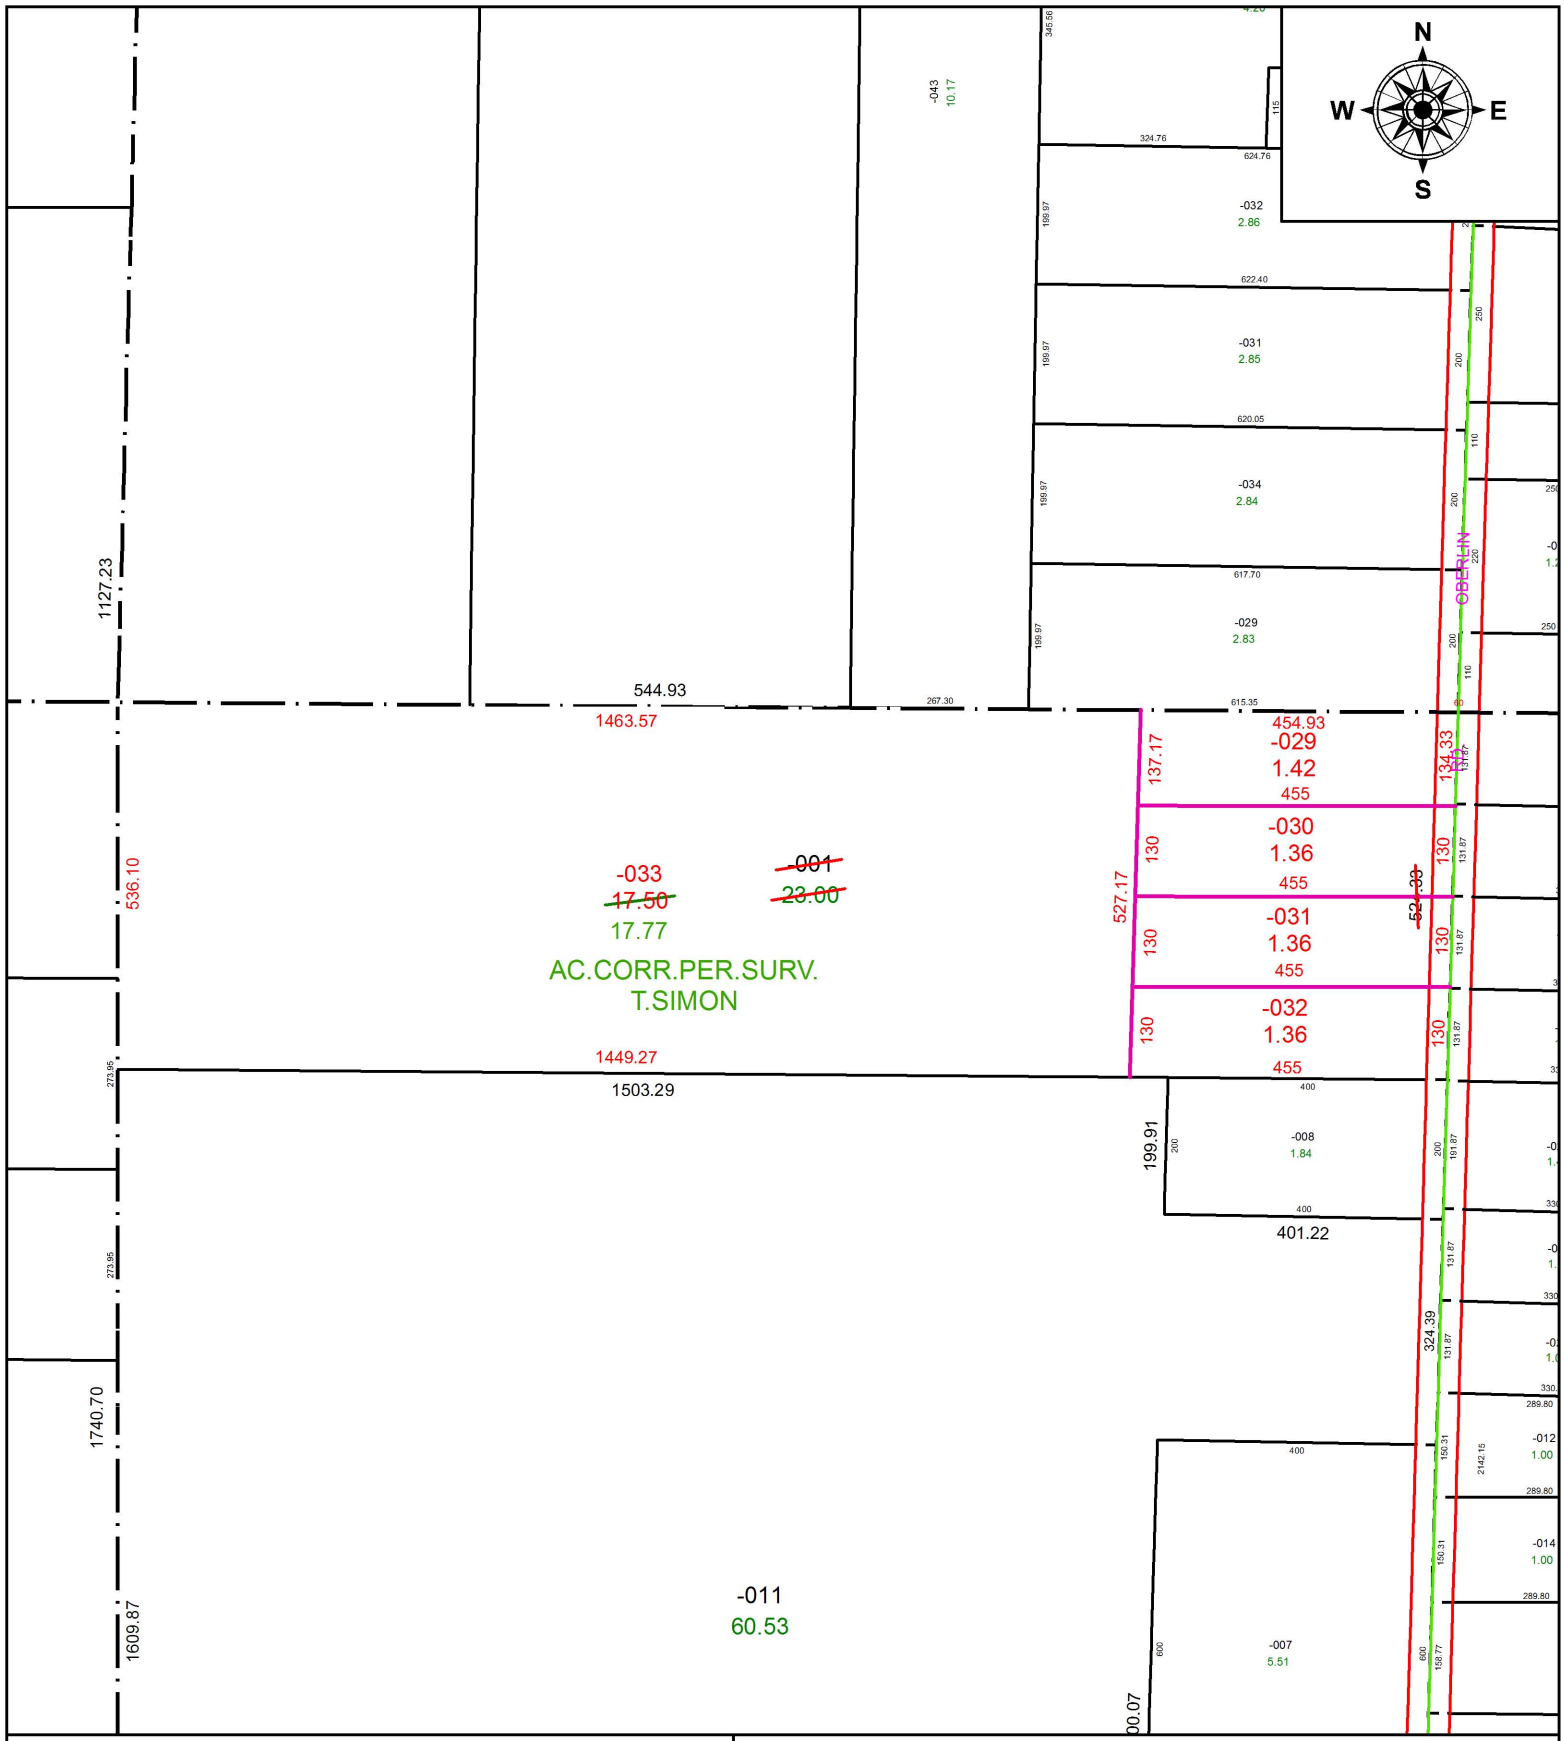

SPLITS/DEEDS PROCESSED

LORAIN COUNTY TAX MAP DEPARTMENT
226 MIDDLE AVE. ELYRIA, OH

SURVEYED BY: THOMAS A. SIMON
CLOSURE: 1:236,642
MAP PAGE(S): 5-00-051
APPOVED BY: RRM **DATE:** 10-24-19
SCALE: 1" = 275 **PRIOR INSTRUMENT:** 19930264070