PARENT PARCEL: 07-00-027-500-004

CHILD PARCEL: DROP FROM DUPLICATE - NO LONGER LEASED

STARTING POINT: NA

17-04037-D

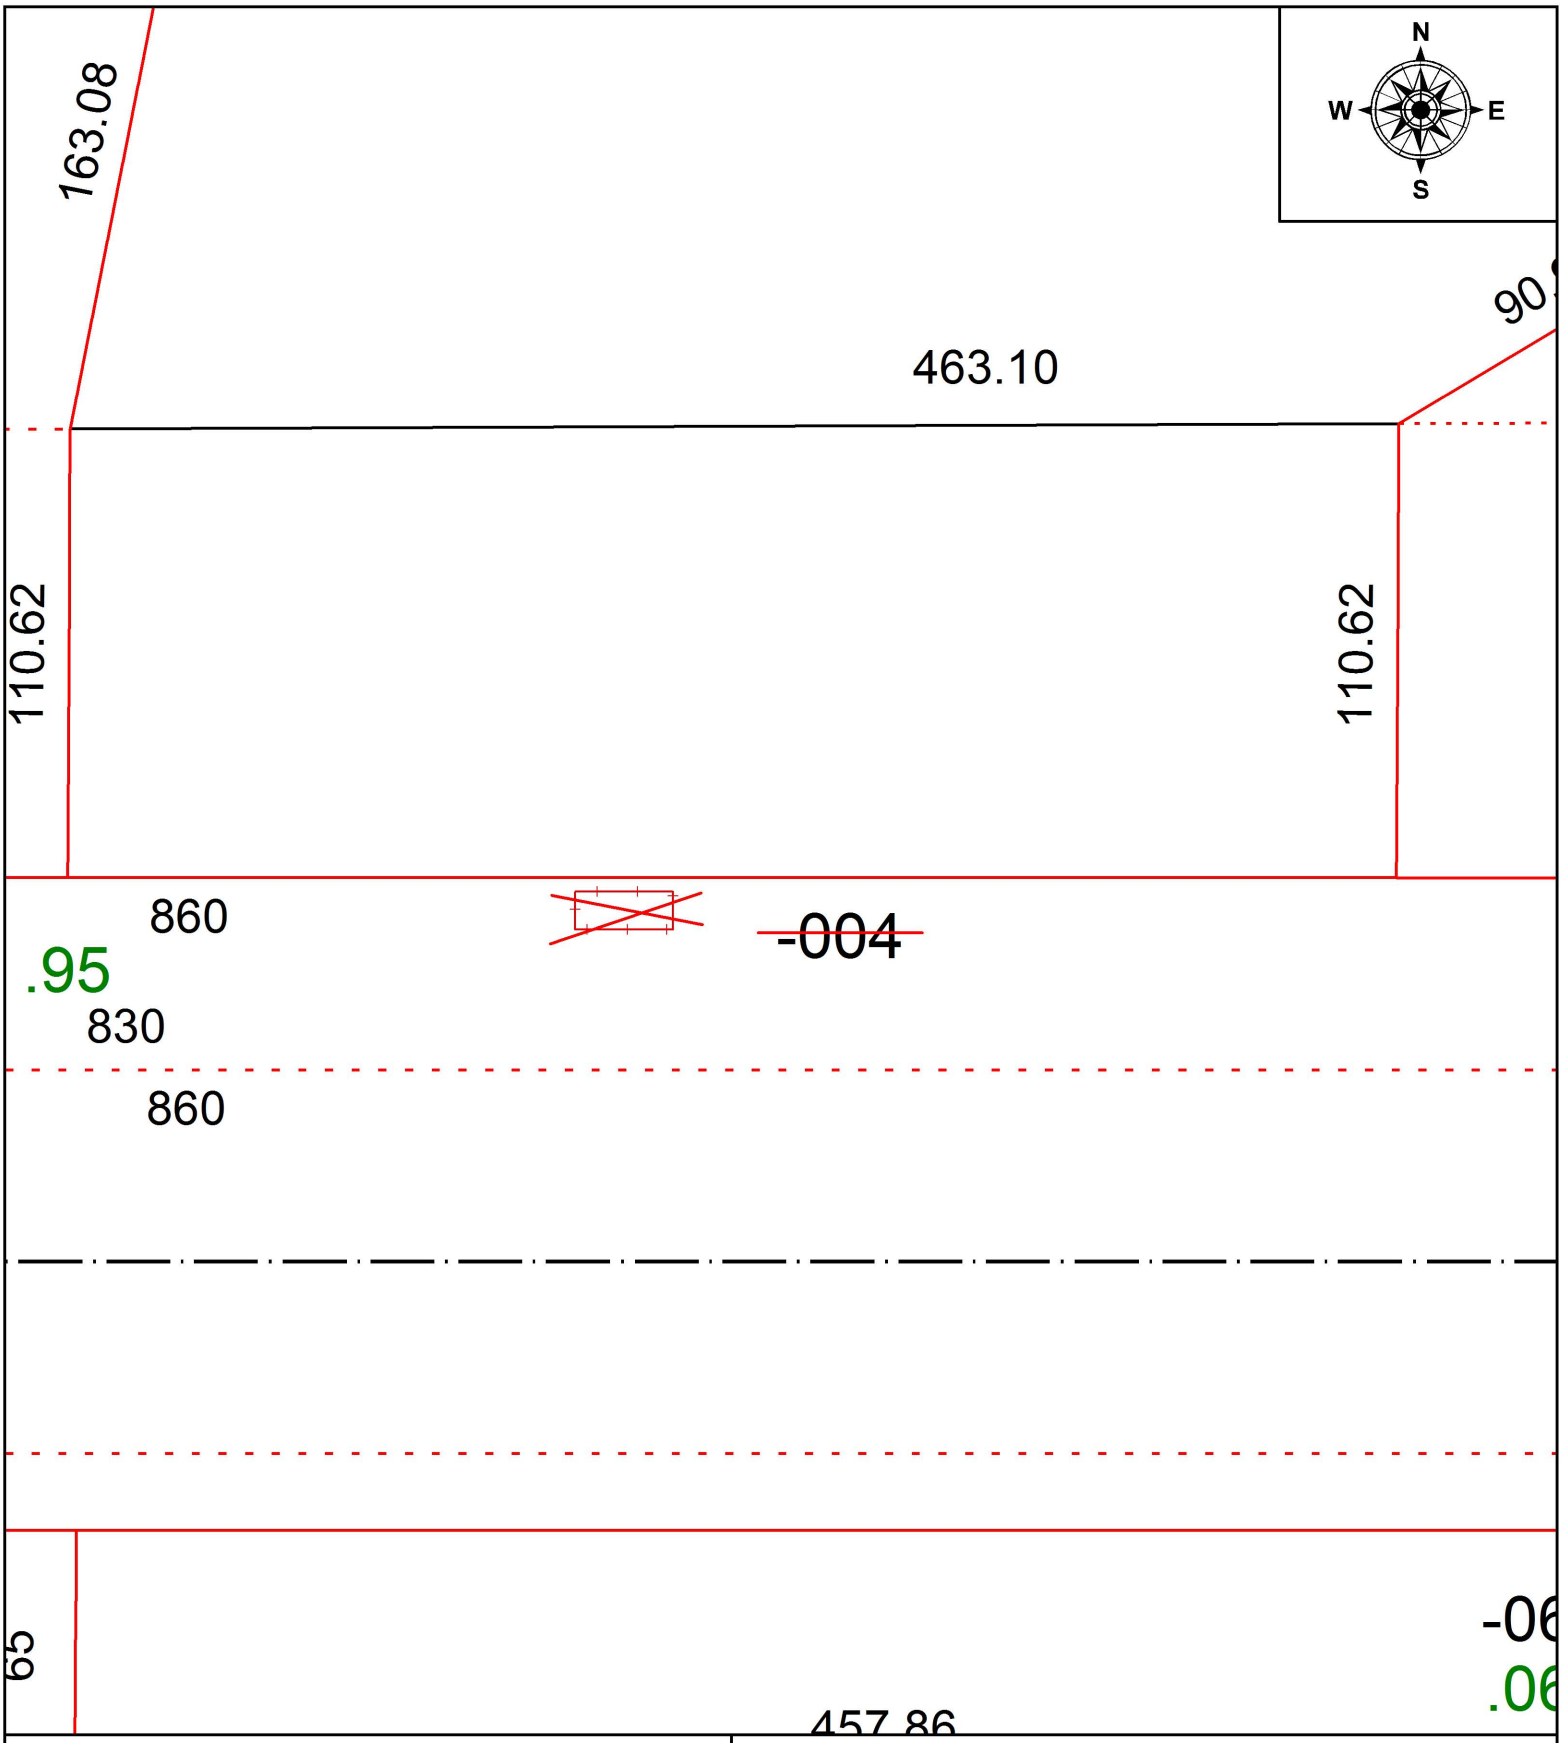

SPLITS/DEEDS PROCESSED

LORAIN COUNTY TAX MAP DEPARTMENT
226 MIDDLE AVE. ELYRIA, OH

SURVEYED BY: NA
CLOSURE: NA
MAP PAGE(S): 07-00-027
APPOVED BY: TJS **DATE:** 1/28/19
SCALE: 1" = 50' **PRIOR INSTRUMENT:** DV XXXX/XXXX