PARENT PARCEL: 15-00-099-102-073, -079

CHILD PARCEL: 15-00-099-102-079, -117, -118

STARTING POINT: NORTHWEST CORNER OF S/L 94 IN PHEASANT RUN VILLAGE PH.1

19-04037

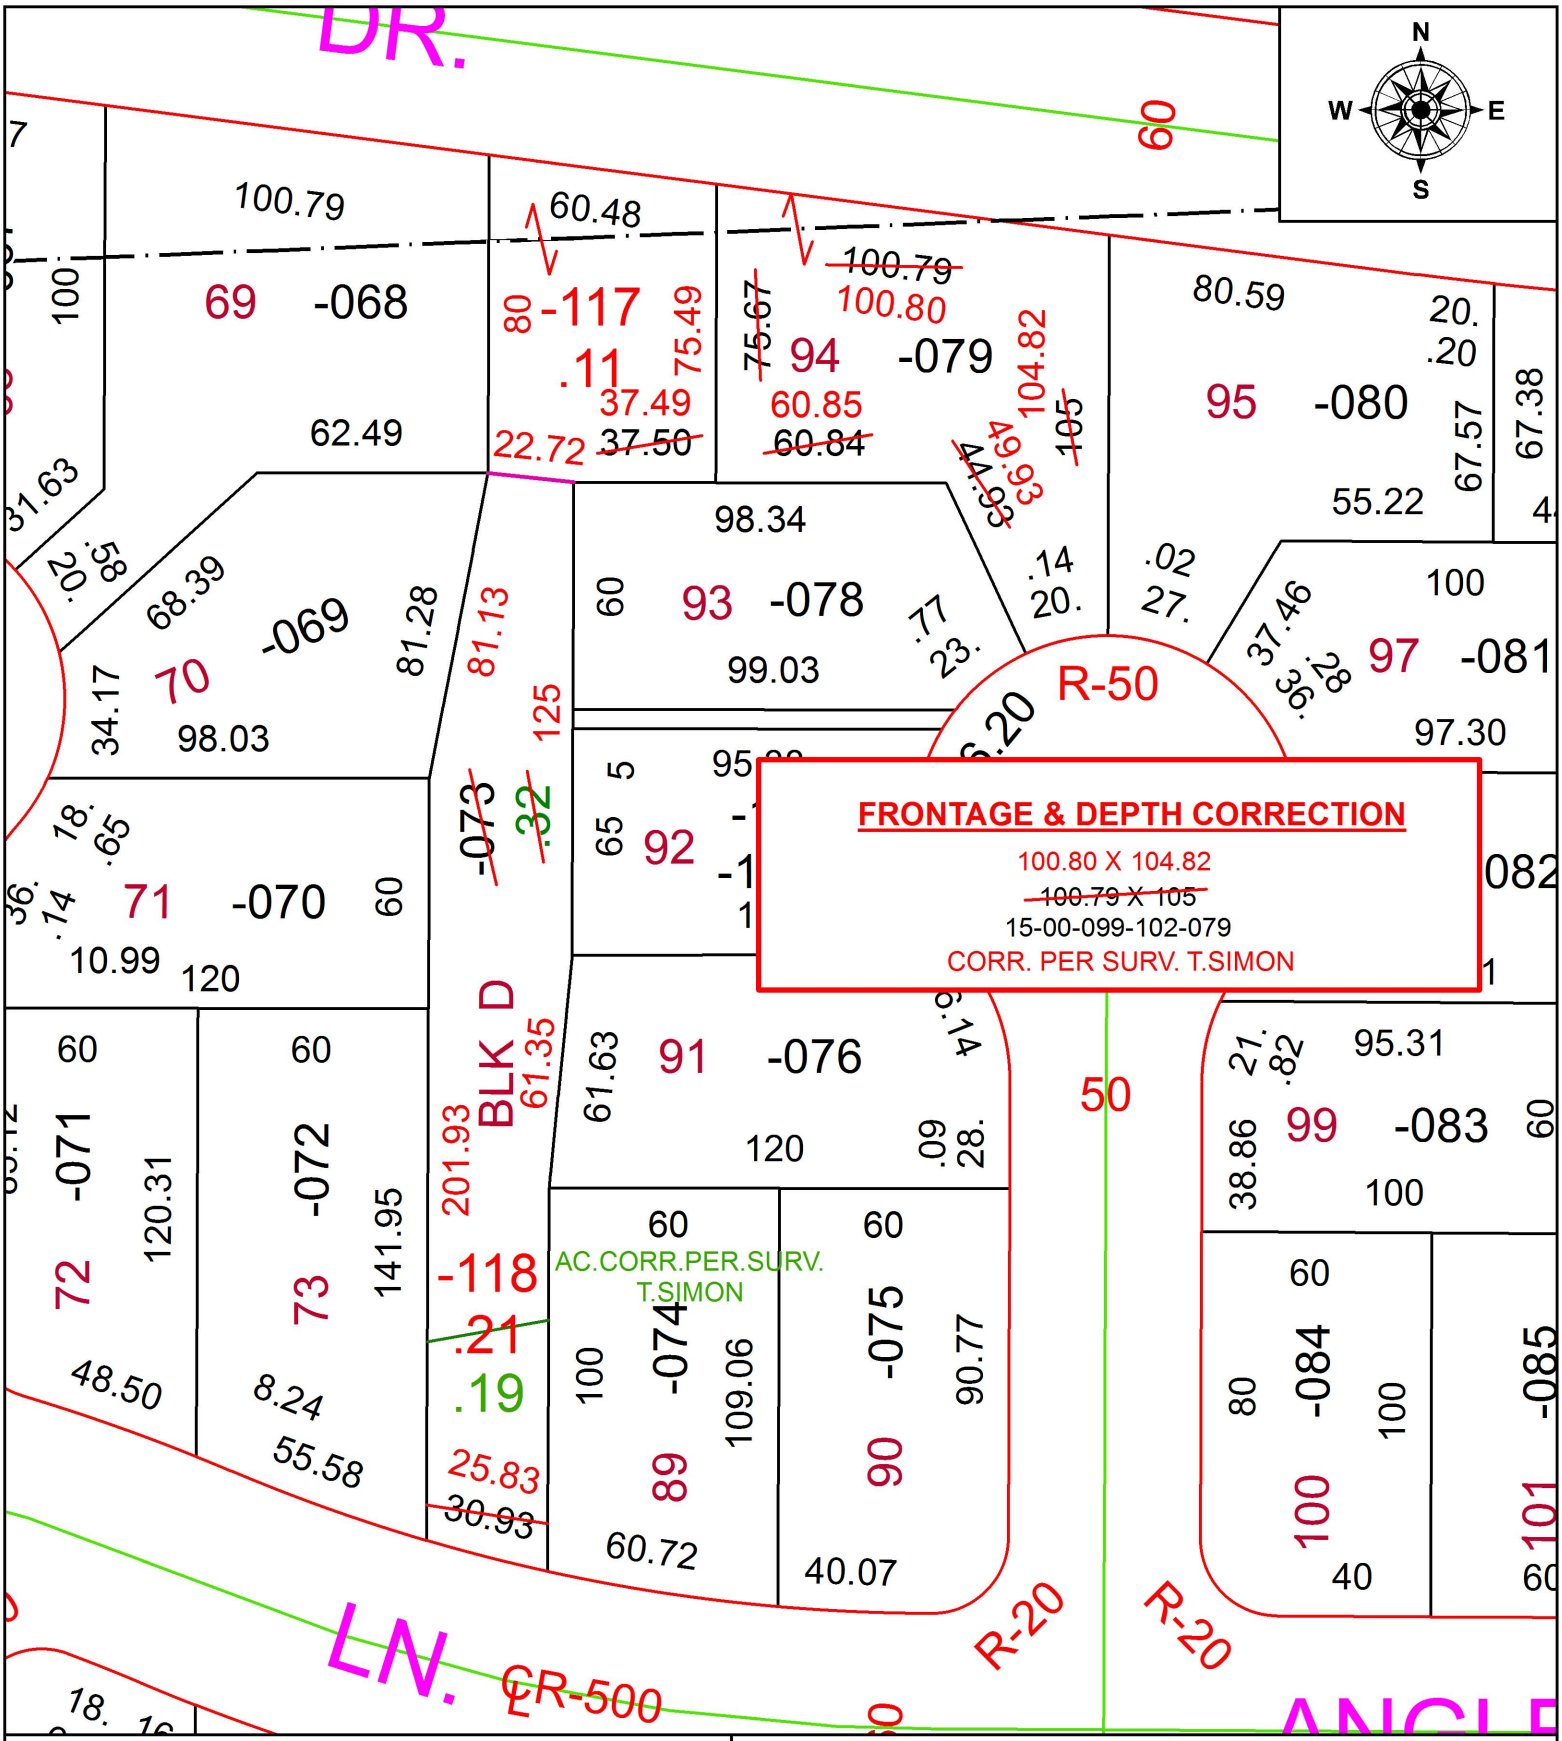

SPLITS/DEEDS PROCESSED

LORAIN COUNTY TAX MAP DEPARTMENT
226 MIDDLE AVE. ELYRIA, OH

SURVEYED BY: THOMAS A. SIMON
CLOSURE: 1:86,462
MAP PAGE(S): 15-00-099
APPOVED BY: RRM **DATE:** 10-28-19
SCALE: 1" = 50 **PRIOR INSTRUMENT:** 20150554268