PARENT PARCEL: 18-00-024-000-018, -019
CHILD PARCEL: 18-00-024-000-020 THRU -022
STARTING POINT: AT STATION 296+85 OF C/L PLAT OF S.R. 58 (VOL.72 PG.41)

19-04040

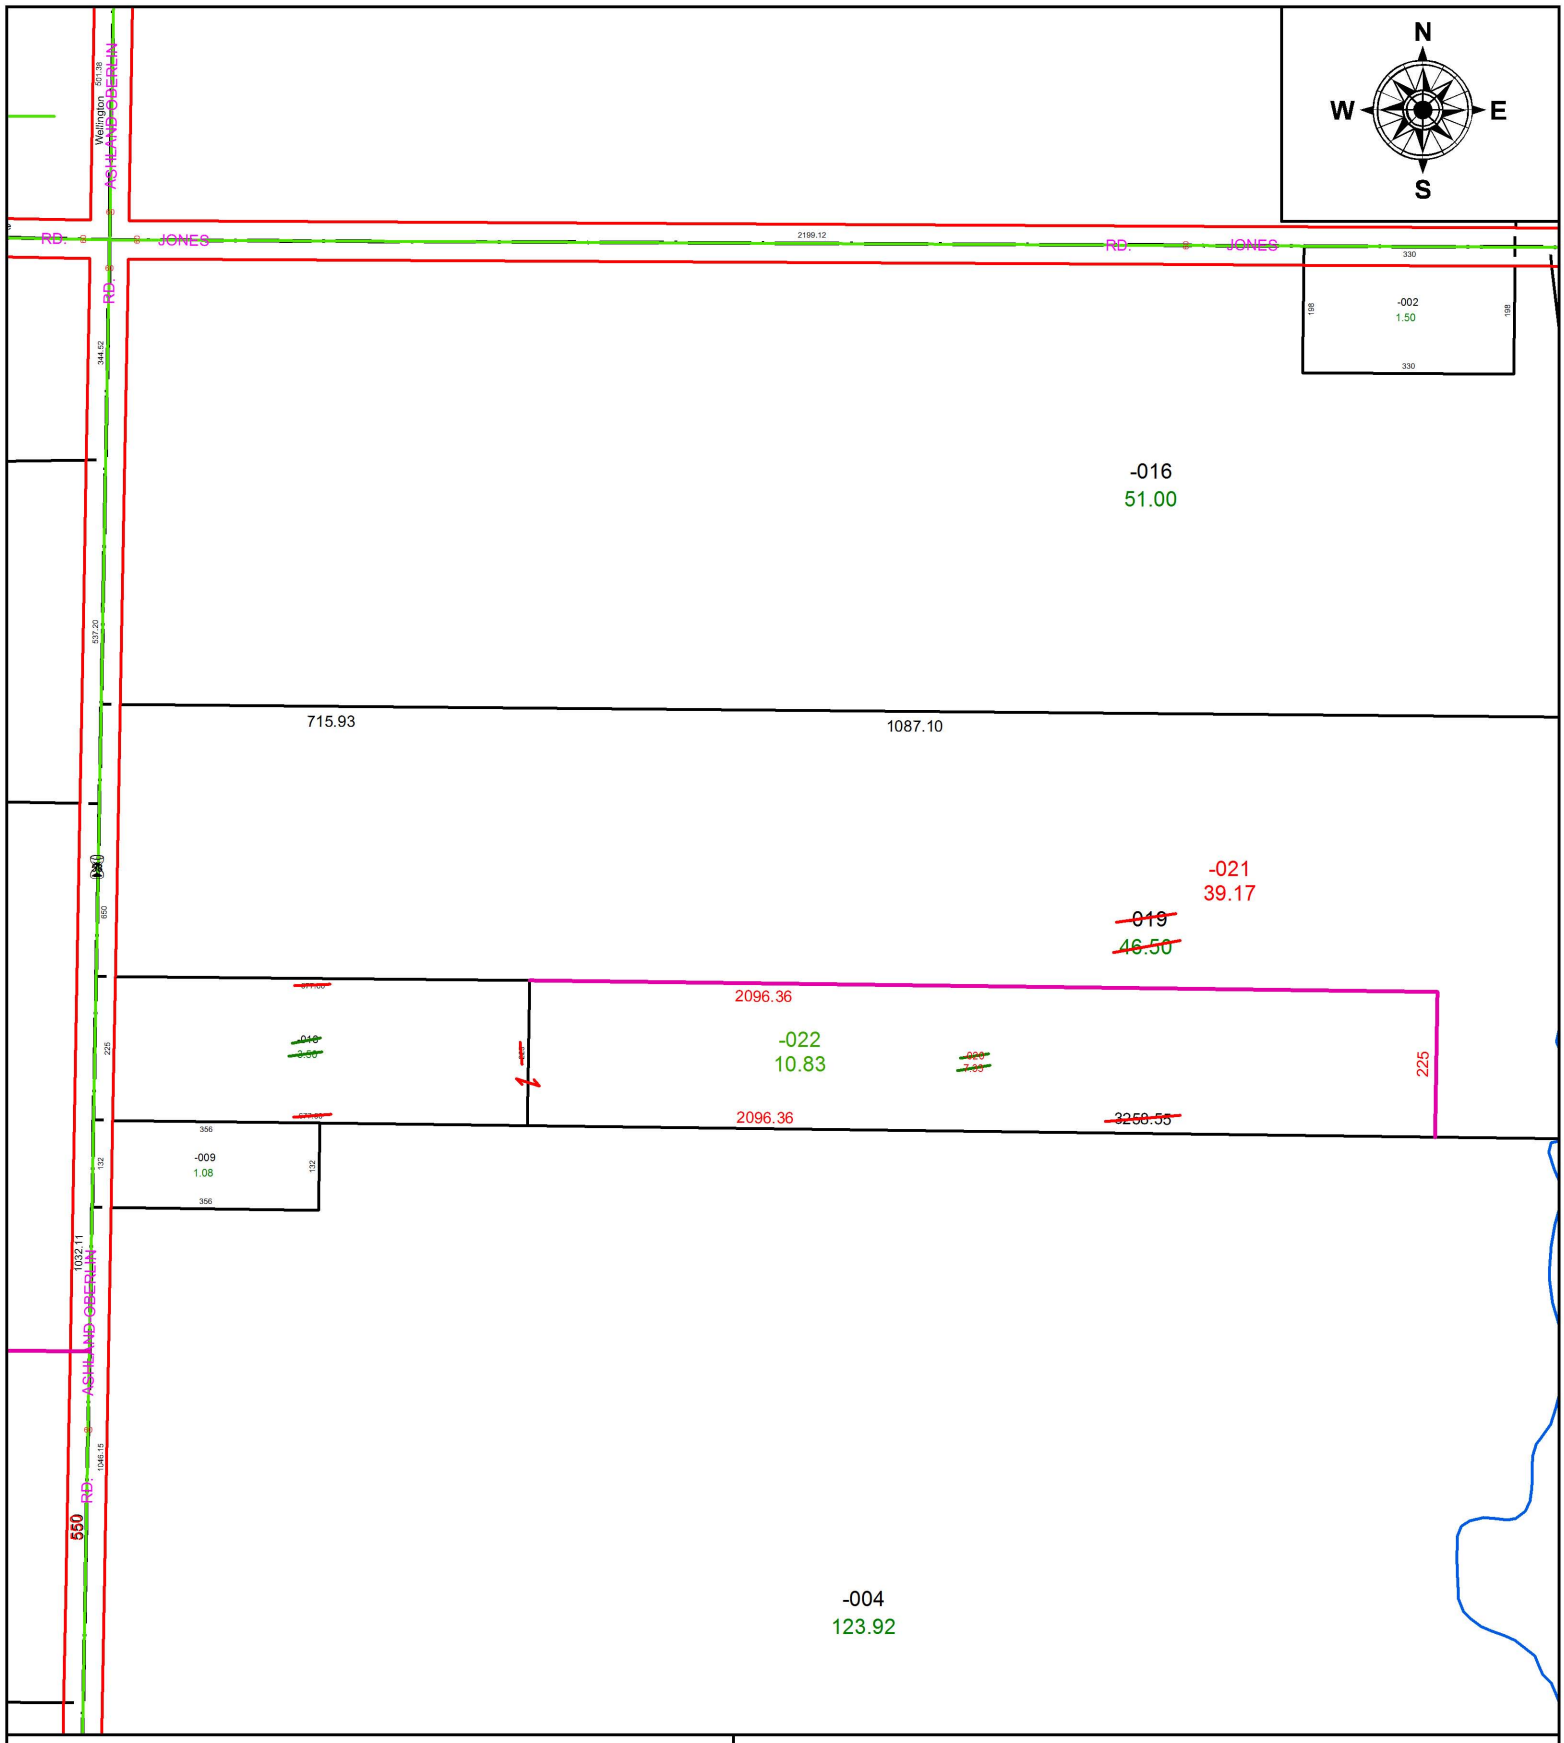

SPLITS/DEEDS PROCESSED

LORAIN COUNTY TAX MAP DEPARTMENT
226 MIDDLE AVE. ELYRIA, OH

SURVEYED BY: RICHARD D. CARLSON
CLOSURE: 1:2147483648
MAP PAGE(S): 18-00-024
APPOVED BY: RRM **DATE:** 11-6-19
SCALE: 1" = 300 **PRIOR INSTRUMENT:** 20130471939