PARENT PARCEL: 05-00-038-105-022
CHILD PARCEL:
STARTING POINT: INTERSECTION OF C/L OF EAST LINE OF JACKSON ST. AND NORTH LINE OF PARK AVE.

19-04043-D

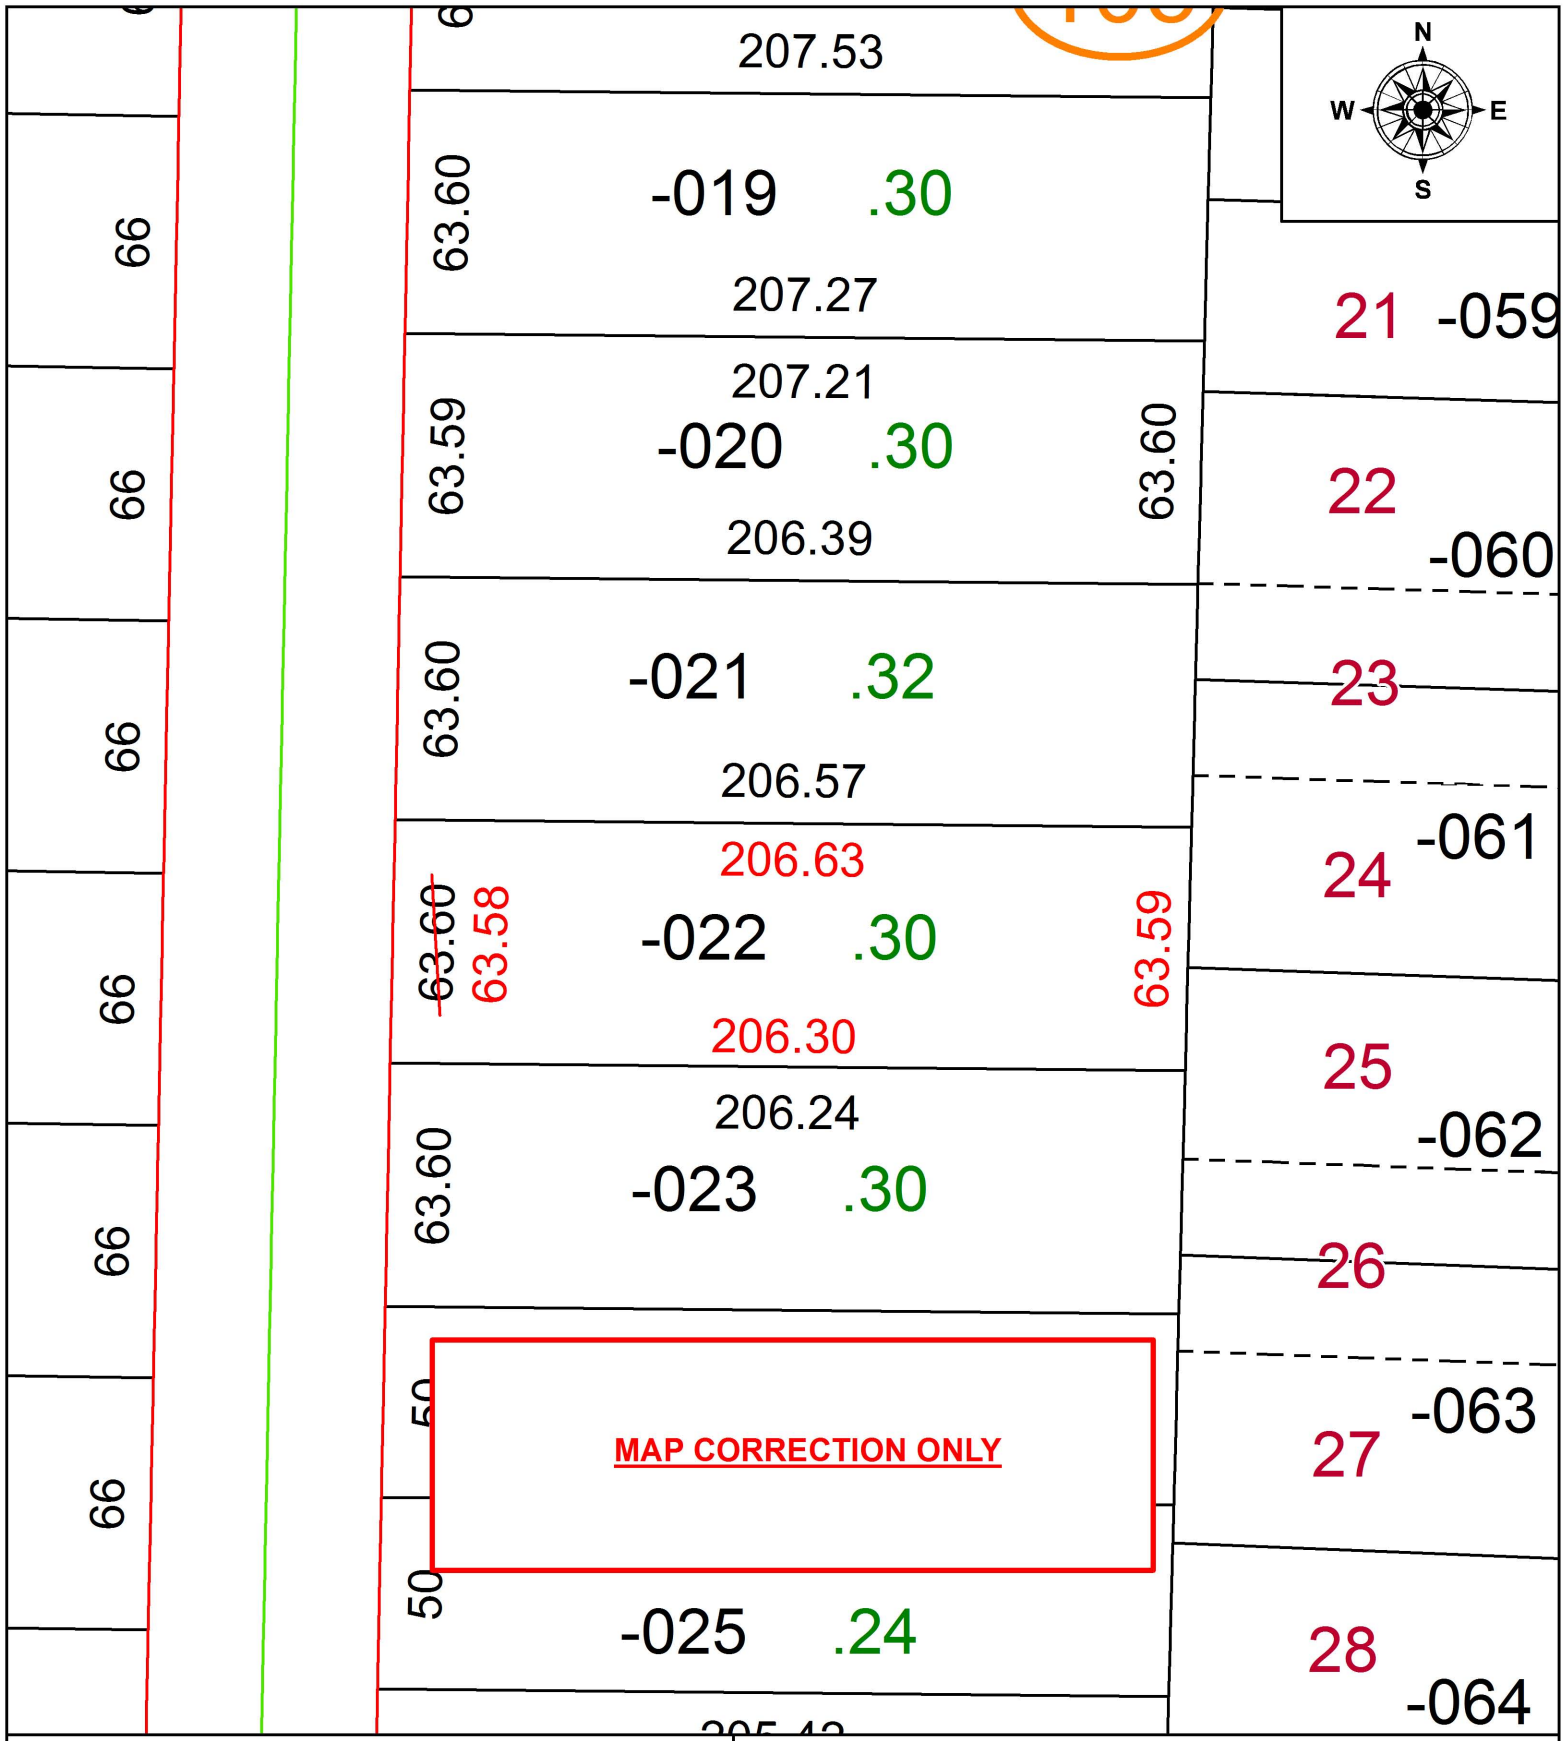

SPLITS/DEEDS PROCESSED
LORAIN COUNTY TAX MAP DEPARTMENT
226 MIDDLE AVE. ELYRIA, OH

SURVEYED BY: PATRICK A. MCGANNON
CLOSURE: 1:63,950
MAP PAGE(S): 5-00-038
APPOVED BY: RRM **DATE:** 2-6-19
SCALE: 1" = 50 **PRIOR INSTRUMENT:** 20180658803