PARENT PARCEL: 05-00-039-108-012

CHILD PARCEL: 05-00-038-102-019, -020, 05-00-039-108-084, -085

STARTING POINT: SOUTHEAST CORNER OF NORTH ORCHARD HILL SUB. NO.1

19-04044

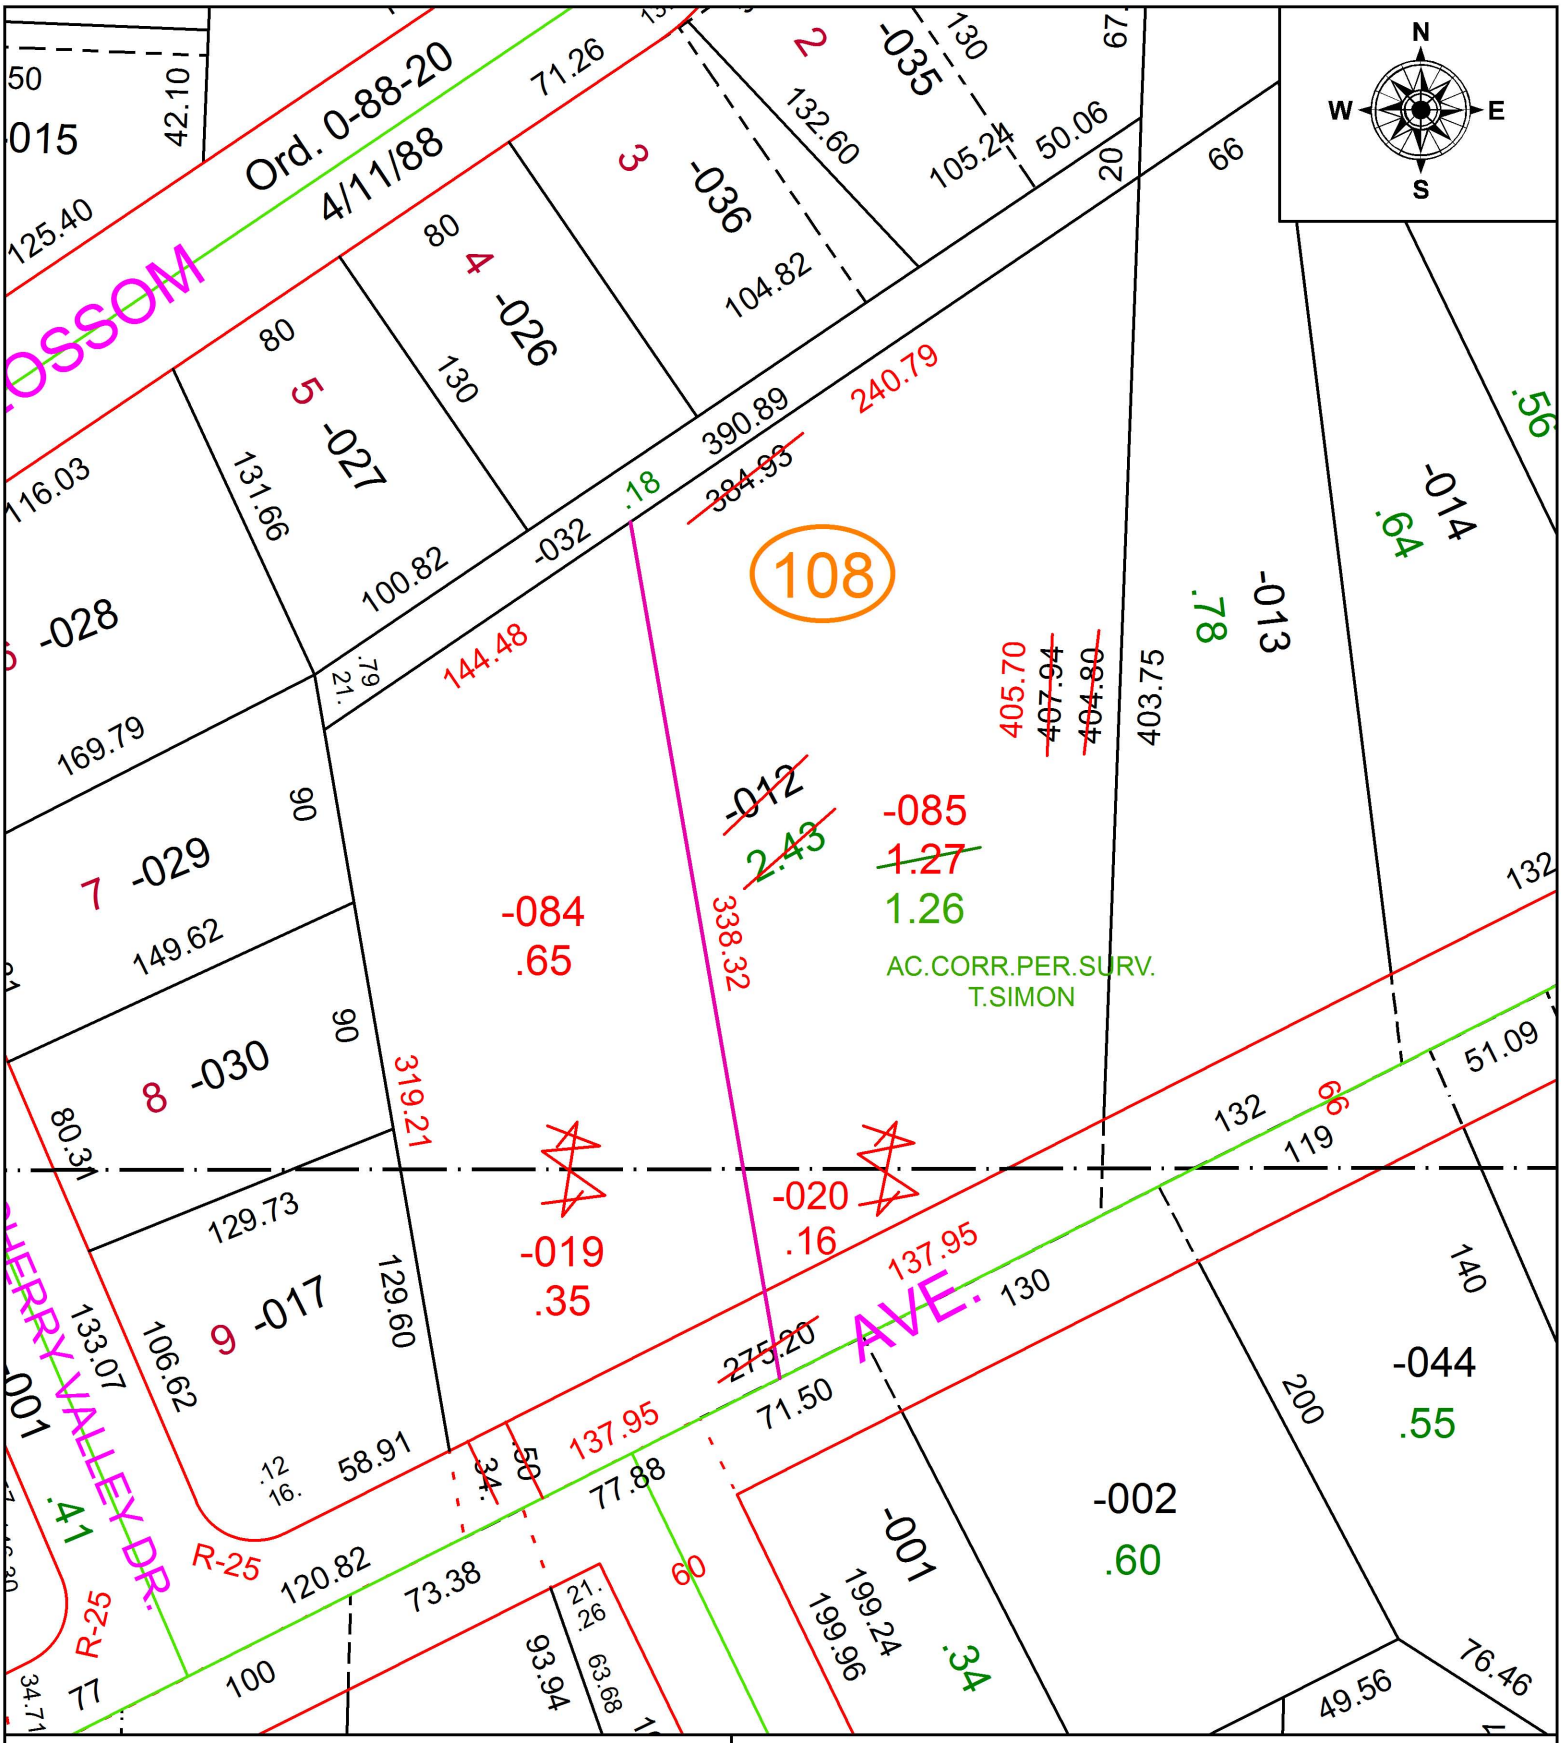

SPLITS/DEEDS PROCESSED

LORAIN COUNTY TAX MAP DEPARTMENT
226 MIDDLE AVE. ELYRIA, OH

SURVEYED BY: THOMAS A. SIMON
CLOSURE: 1:272,361
MAP PAGE(S): 5-00-039
APPOVED BY: RRM **DATE:** 11-12-19
SCALE: 1" = 75 **PRIOR INSTRUMENT:** 20190713014