PARENT PARCEL: 02-01-005-109-026, -027

CHILD PARCEL: 02-01-005-109-031

STARTING POINT: SOUTHWEST LINE OF REID AVE. AND NORTHWEST LINE OF 6TH ST.

19-04045-C

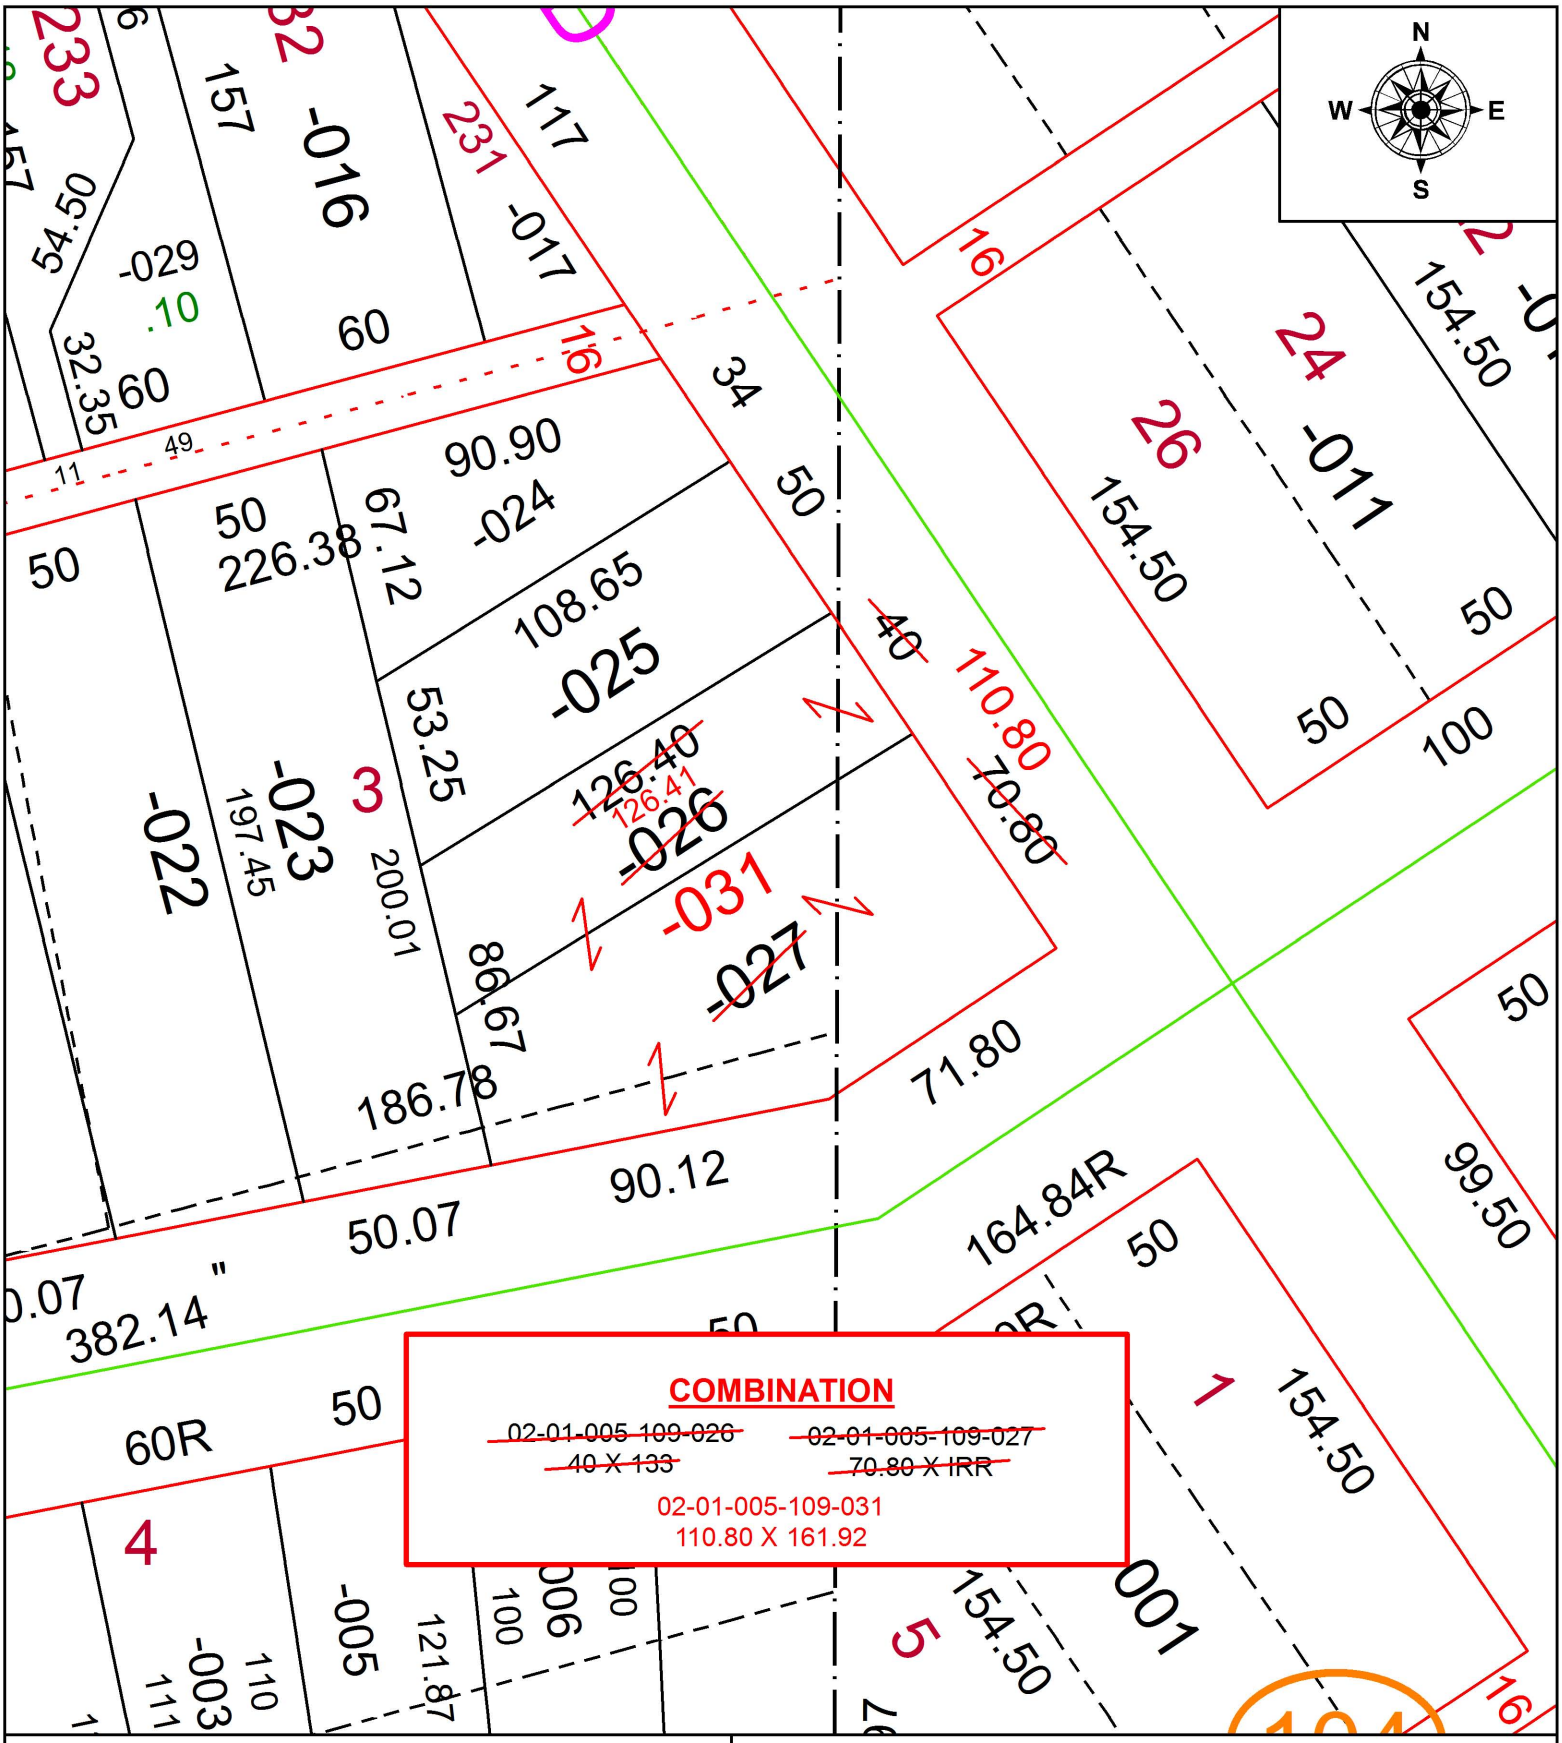

SPLITS/DEEDS PROCESSED

LORAIN COUNTY TAX MAP DEPARTMENT
226 MIDDLE AVE. ELYRIA, OH

SURVEYED BY: N/A
CLOSURE: N/A
MAP PAGE(S): 2-01-005
APPOVED BY: RRM **DATE:** 2-13-19
SCALE: 1" = 50 **PRIOR INSTRUMENT:** 20180694066