PARENT PARCEL: 03-00-094-105-021
CHILD PARCEL: 03-00-094-105-049, -050
STARTING POINT: NORHTEAST CORNER OF S/L 259 IN SHEFFIELD LAND CO'S SUB. NO.1

19-04045

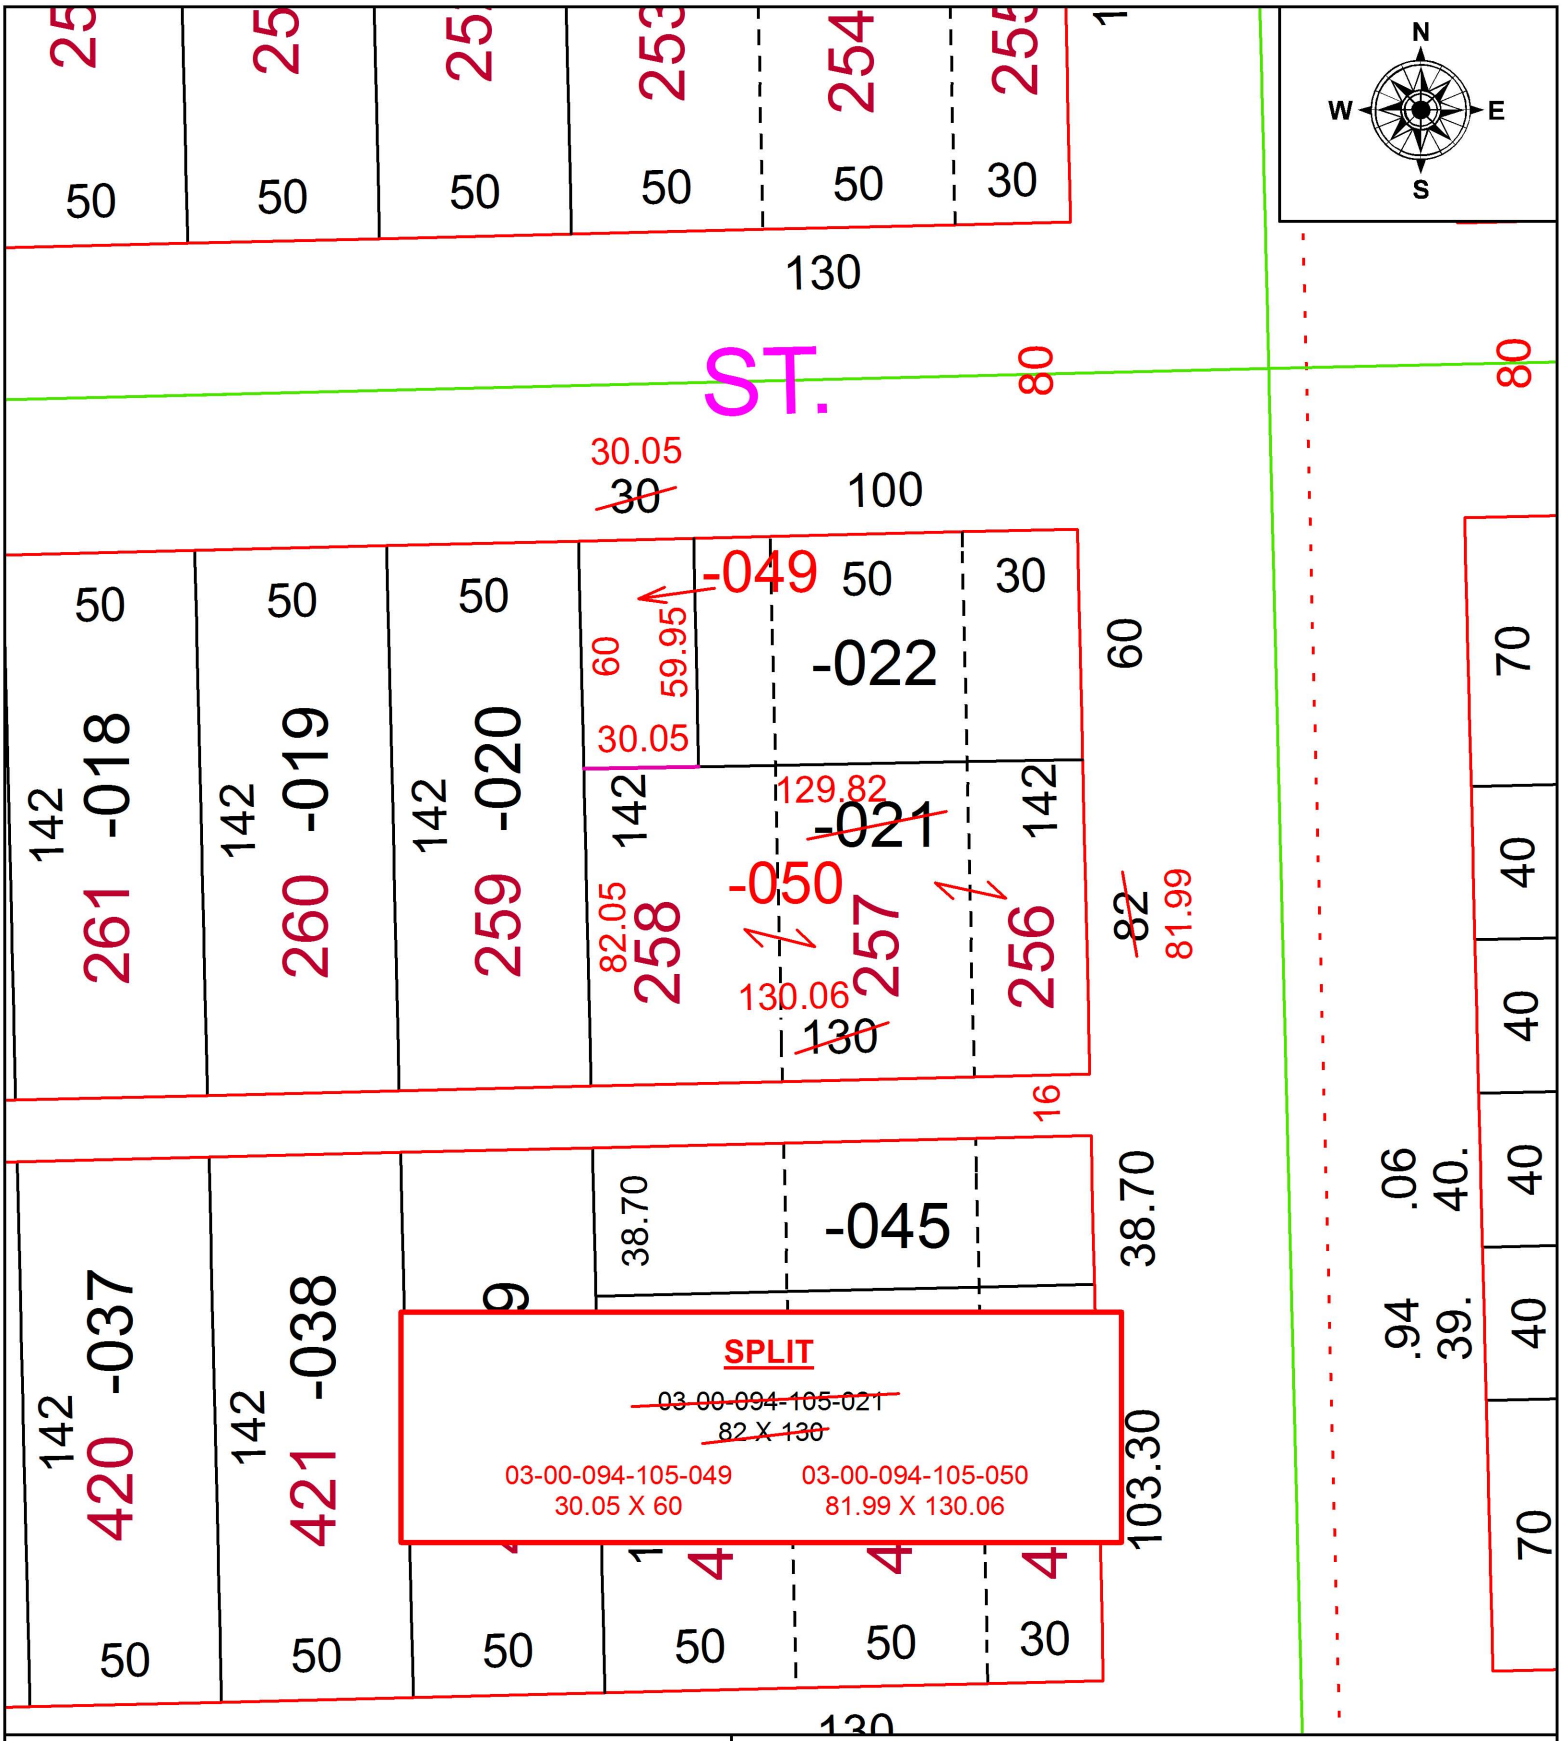

SPLITS/DEEDS PROCESSED
LORAIN COUNTY TAX MAP DEPARTMENT
226 MIDDLE AVE. ELYRIA, OH

SURVEYED BY: PATRICK A. MCGANNON
CLOSURE: 1:59,409
MAP PAGE(S): 3-00-094
APPOVED BY: RRM **DATE:** 11-13-19
SCALE: 1" = 50 **PRIOR INSTRUMENT:** OR 514/478