**PARENT PARCEL:** 13-10-030-000-009, -025
**CHILD PARCEL:** 13-10-030-000-033 THRU -035
**STARTING POINT:** INTERSECTION OF C/L OF BAIRD RD. AND C/L OF S.R.303

# 19-04047

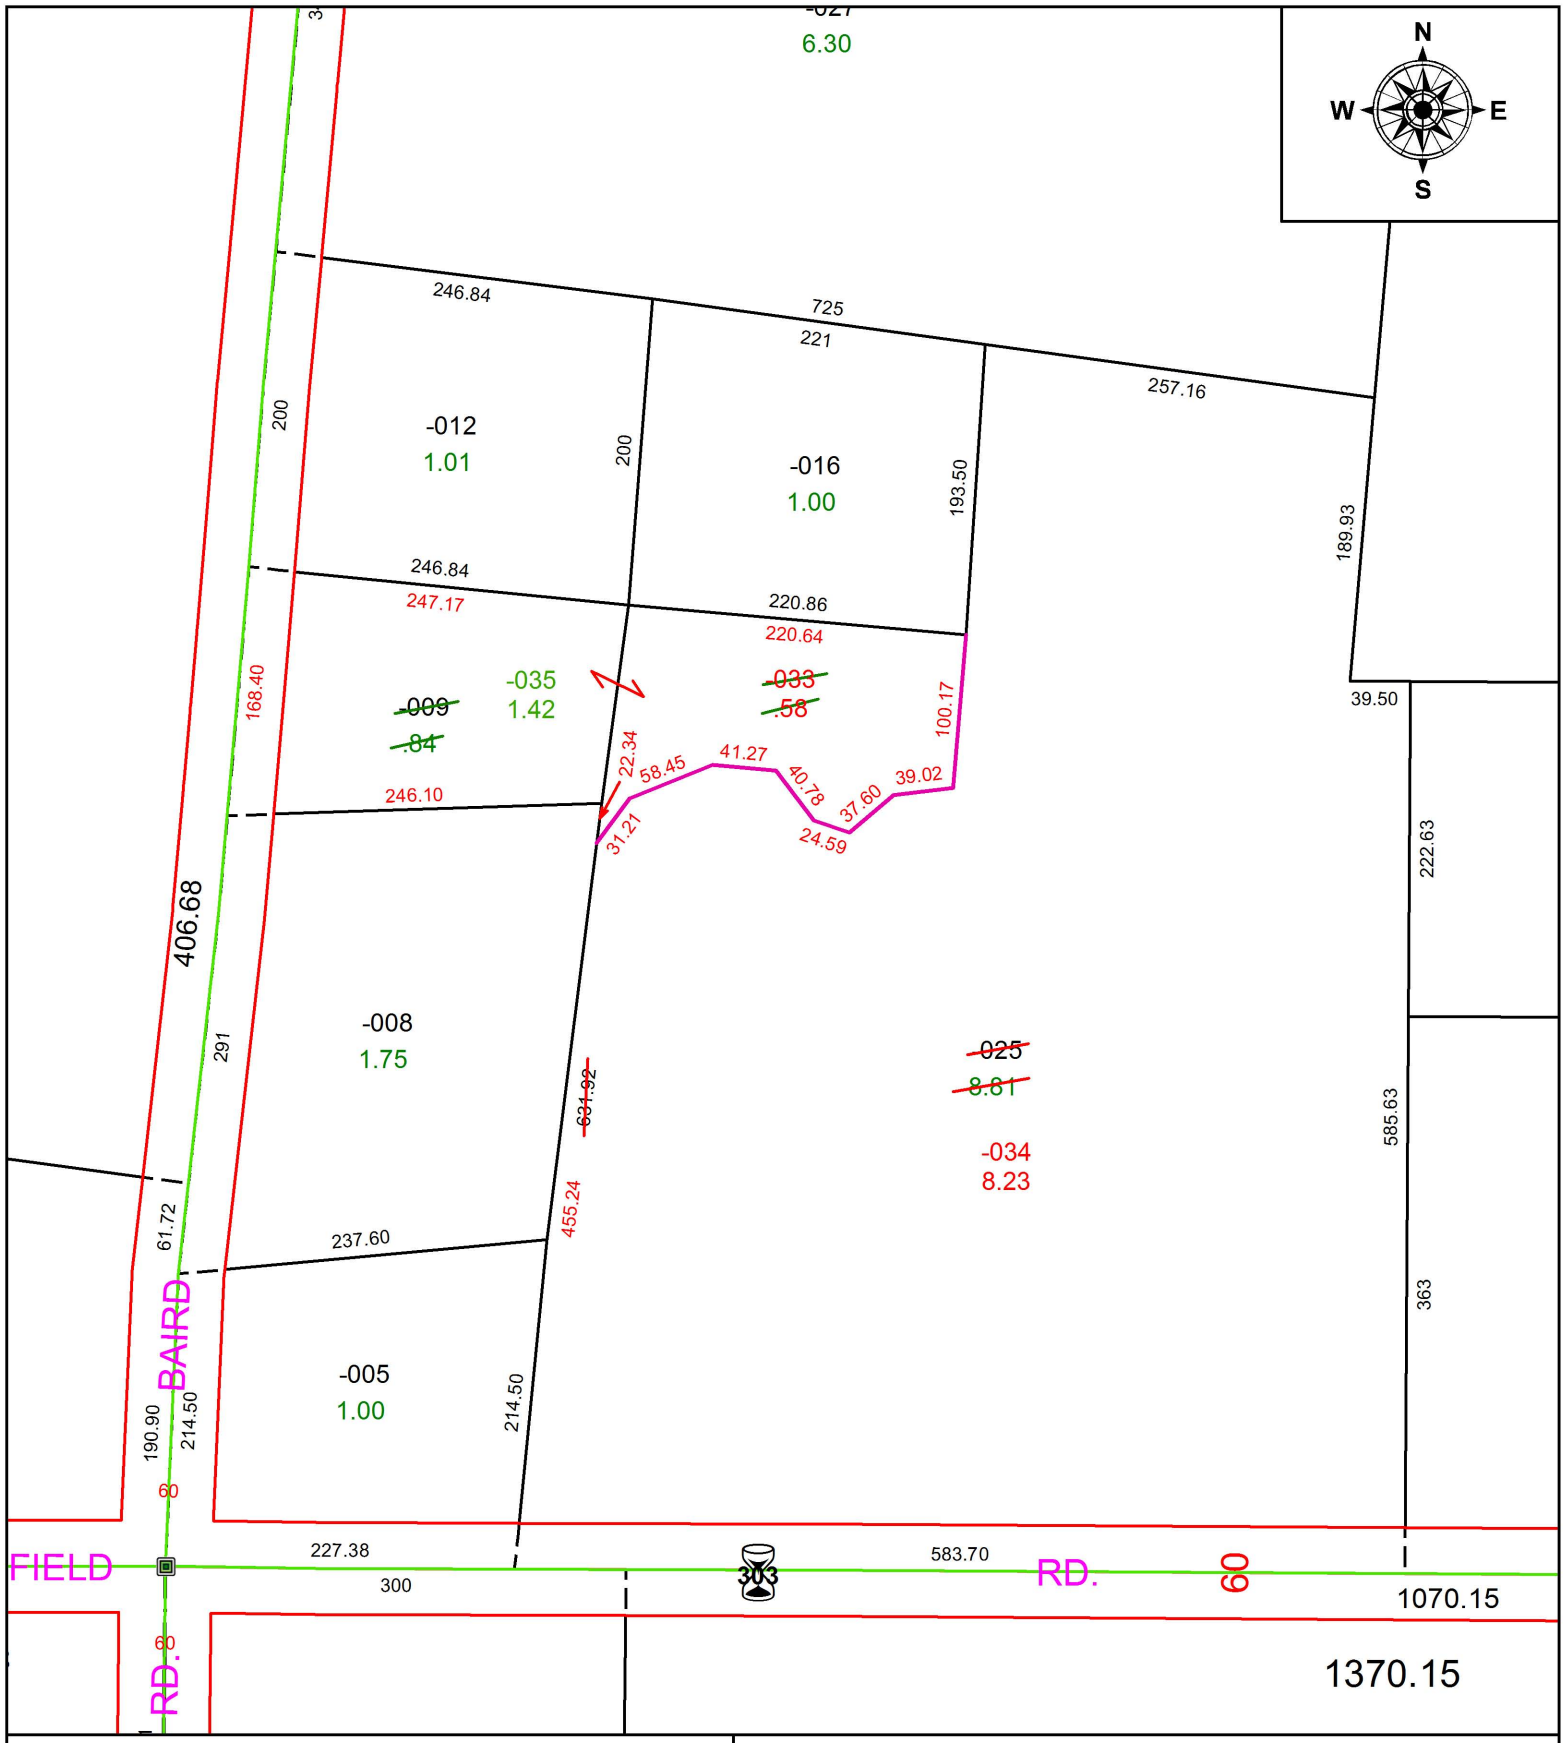


**SPLITS/DEEDS PROCESSED**
LORAIN COUNTY TAX MAP DEPARTMENT
226 MIDDLE AVE. ELYRIA, OH

**SURVEYED BY:** TIMOTHY D. HOZALSKI
**CLOSURE:** 1:390,860
**MAP PAGE(S):** 13-10-030
**APPOVED BY:** RRM **DATE:** 11-15-19
**SCALE:** 1" = 125 **PRIOR INSTRUMENT:** OR 1141/653