PARENT PARCEL: 06-26-014-102-017

CHILD PARCEL:

STARTING POINT: NORTHWEST CORNER OF S/L 10 IN A.D. HOWE ADDITION (PV 2/8)

19-04050-D

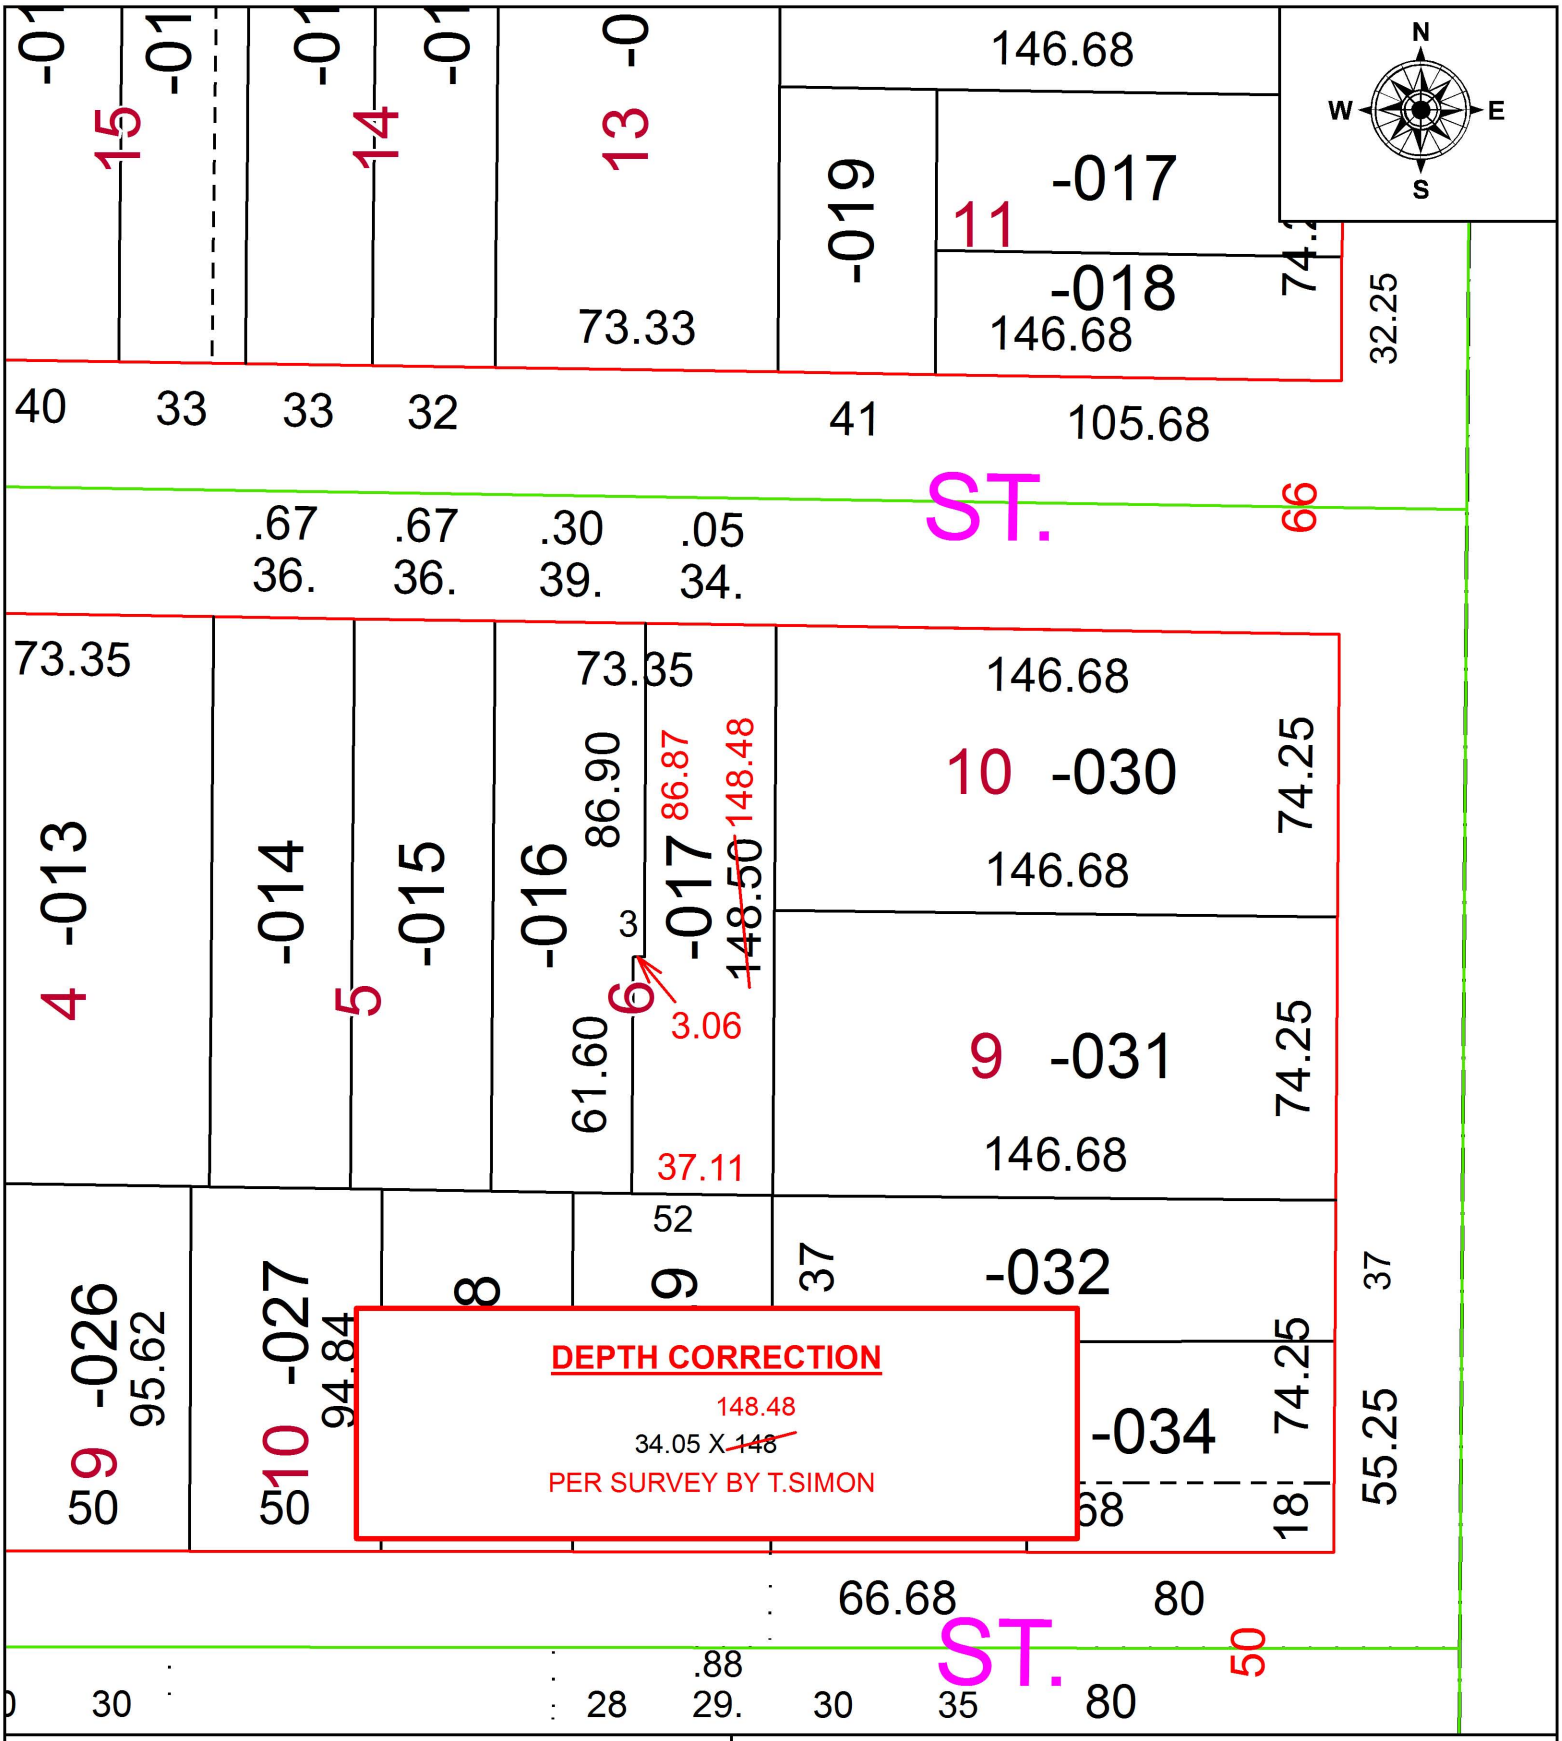

SPLITS/DEEDS PROCESSED

LORAIN COUNTY TAX MAP DEPARTMENT
226 MIDDLE AVE. ELYRIA, OH

SURVEYED BY: THOMAS A. SIMON
CLOSURE: 1:77,607
MAP PAGE(S): 6-26-014
APPOVED BY: RRM **DATE:** 2-22-19
SCALE: 1" = 50 **PRIOR INSTRUMENT:** 20170642818