PARENT PARCEL: 14-00-050-000-012, -015
CHILD PARCEL: 14-00-050-000-016 THRU -018
STARTING POINT: NORTHEAST CORNER OF O.L.50

19-04050

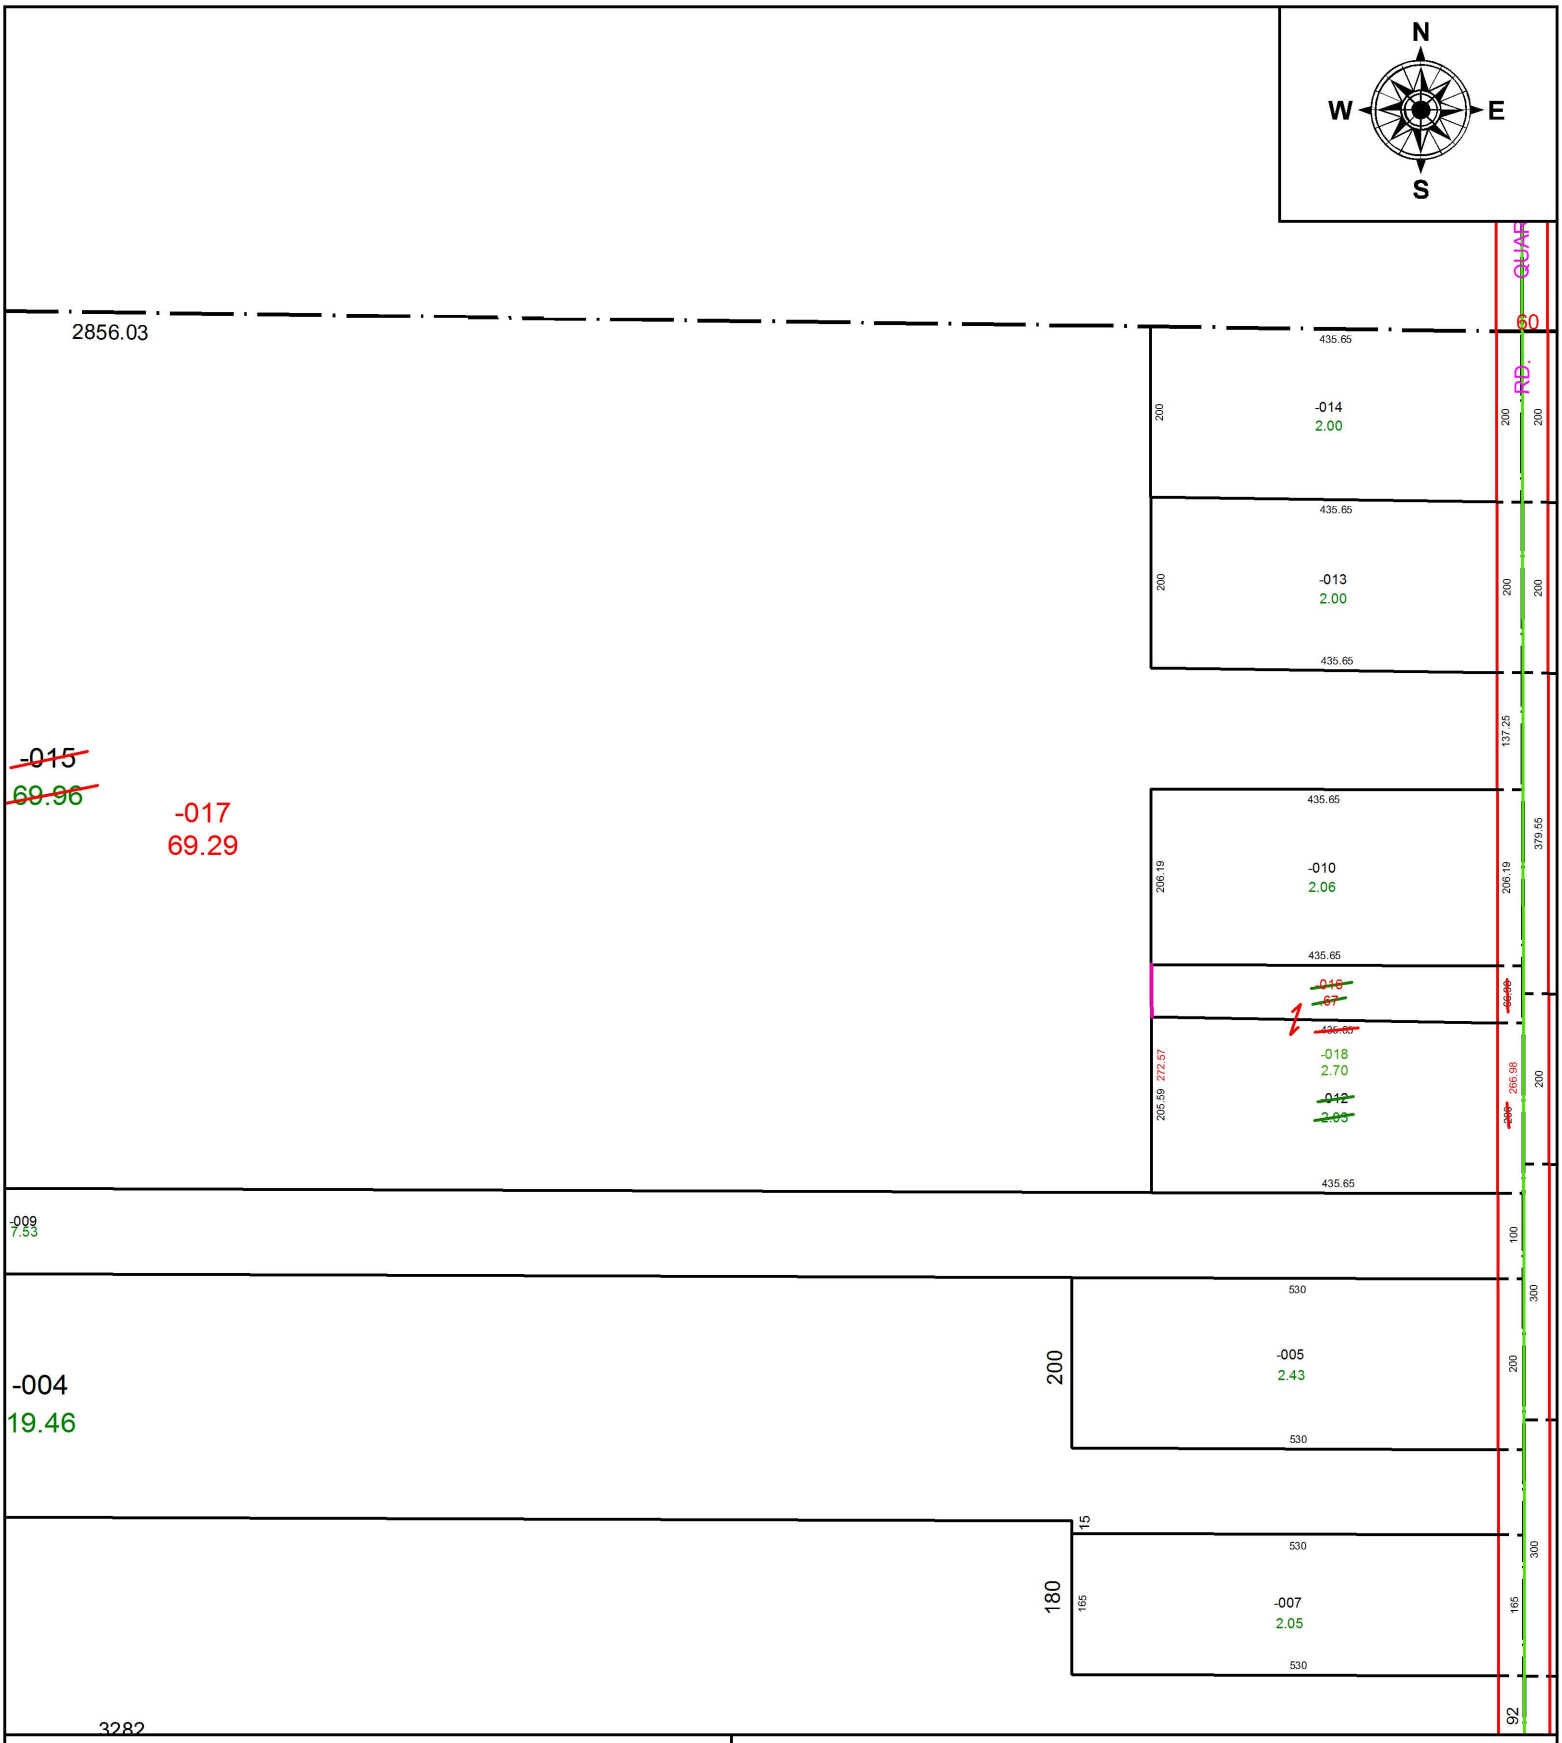

SPLITS/DEEDS PROCESSED

LORAIN COUNTY TAX MAP DEPARTMENT
226 MIDDLE AVE. ELYRIA, OH

SURVEYED BY: DAVID A. WILLIAMS
CLOSURE: 1:2147483648
MAP PAGE(S): 14-00-050
APPOVED BY: RRM **DATE:** 11-20-19
SCALE: 1" = 225 **PRIOR INSTRUMENT:** 20150569861