PARENT PARCEL: 11-00-016-000-002
CHILD PARCEL:
STARTING POINT: INTERSECTION OF C/L OF S.R.82 AND C/L OF REED RD.

19-04051-D

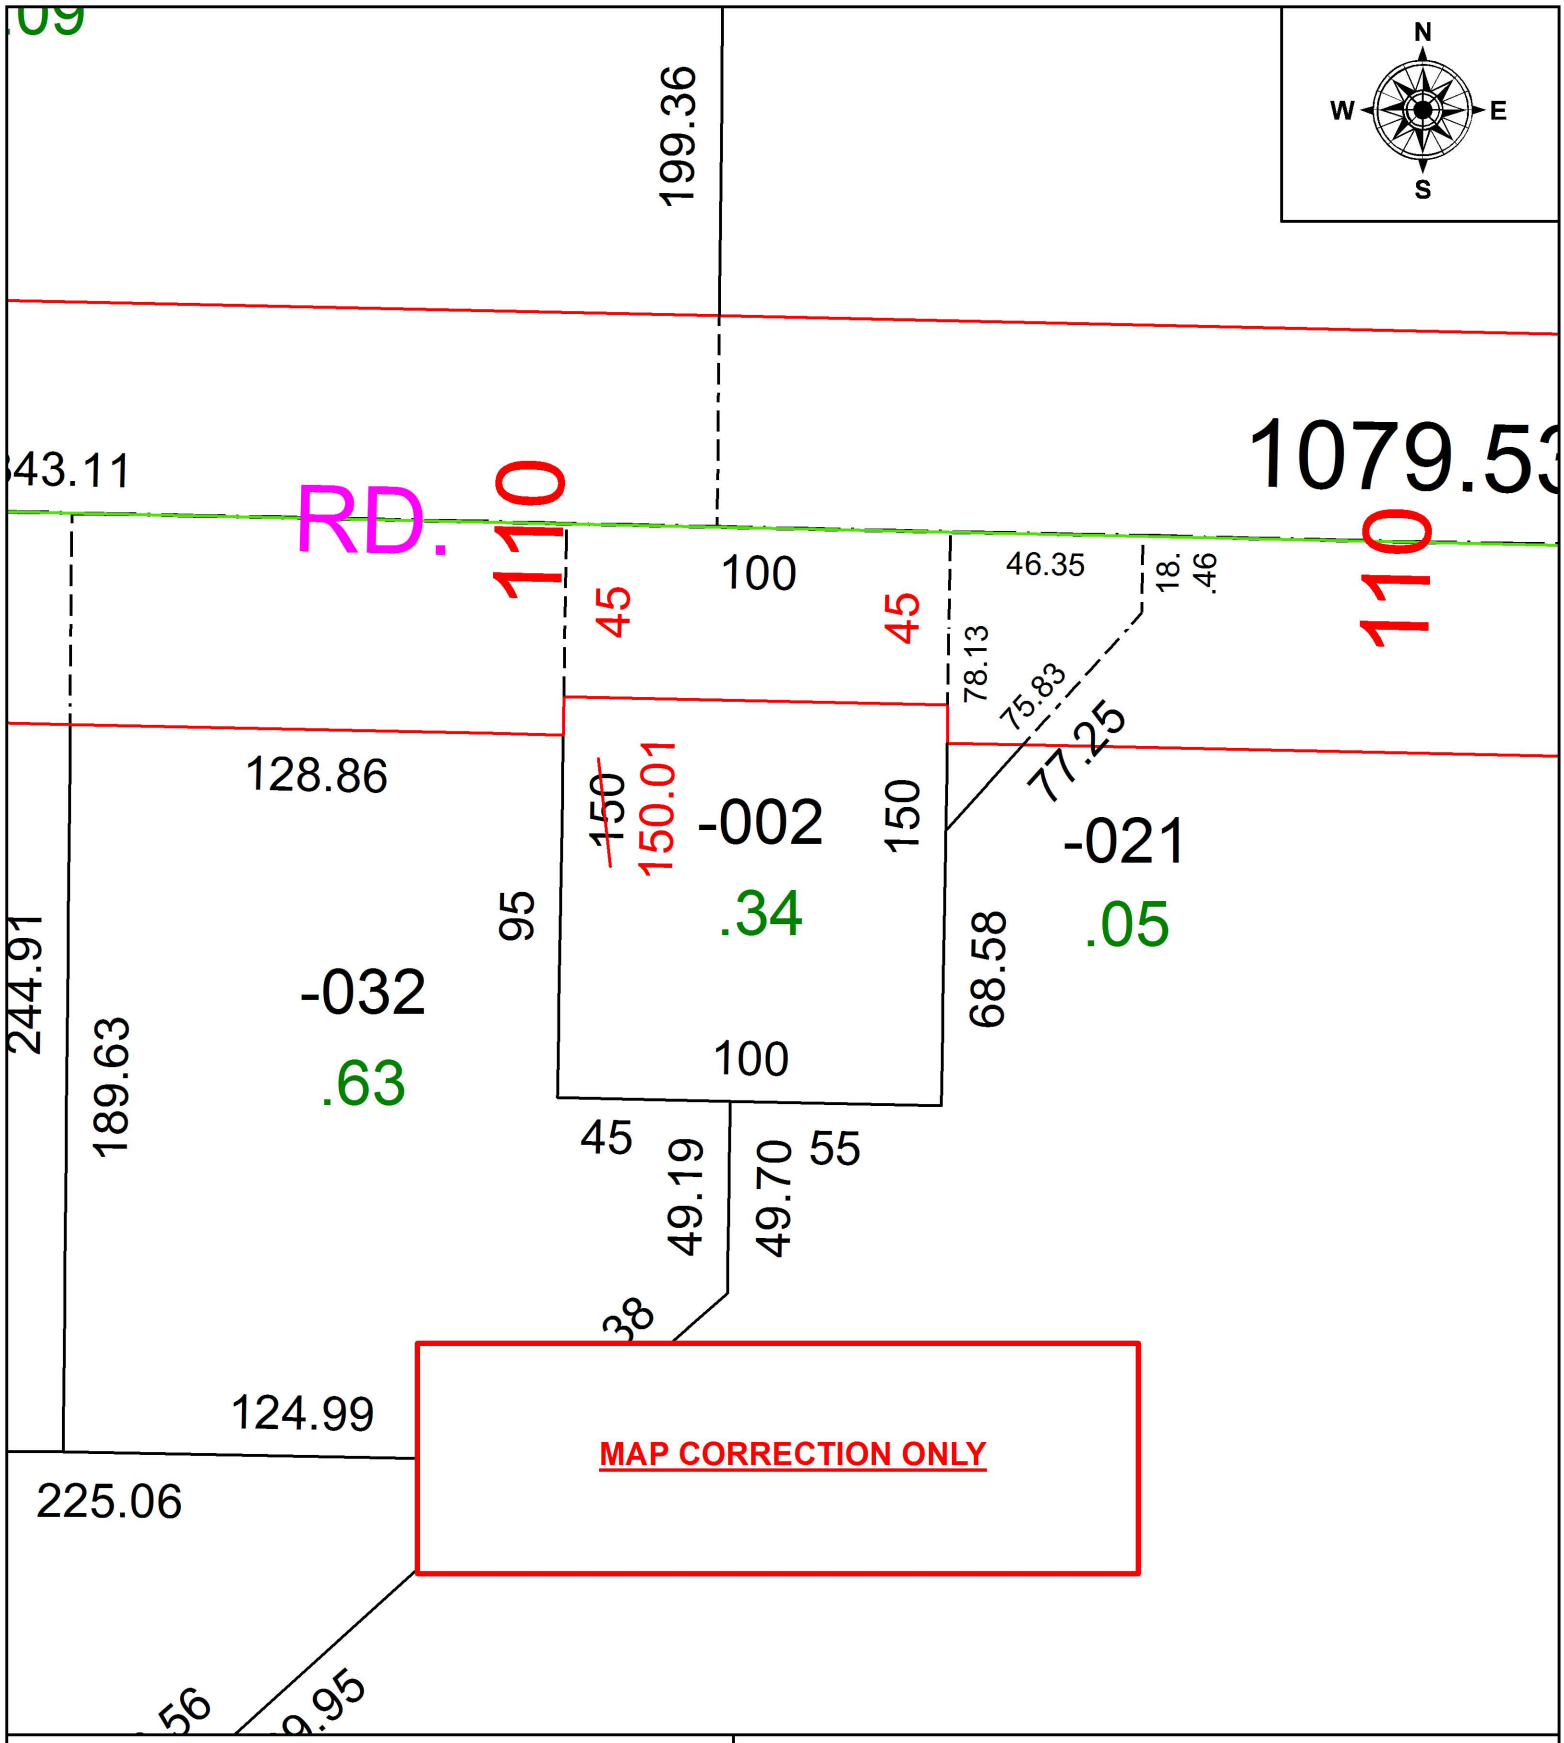


**SPLITS/DEEDS PROCESSED**
LORAIN COUNTY TAX MAP DEPARTMENT
226 MIDDLE AVE. ELYRIA, OH

SURVEYED BY: SEAN A. BOLAND
CLOSURE: 1:305,570
MAP PAGE(S): 11-00-016
APPOVED BY: RRM DATE: 2-25-19
SCALE: 1" = 50 PRIOR INSTRUMENT: 20190702923