PARENT PARCEL: 04-00-028-101-122

CHILD PARCEL: 04-00-028-101-125, -126

STARTING POINT: SOUTHWEST CORNER OF SEC. 28

19-04053

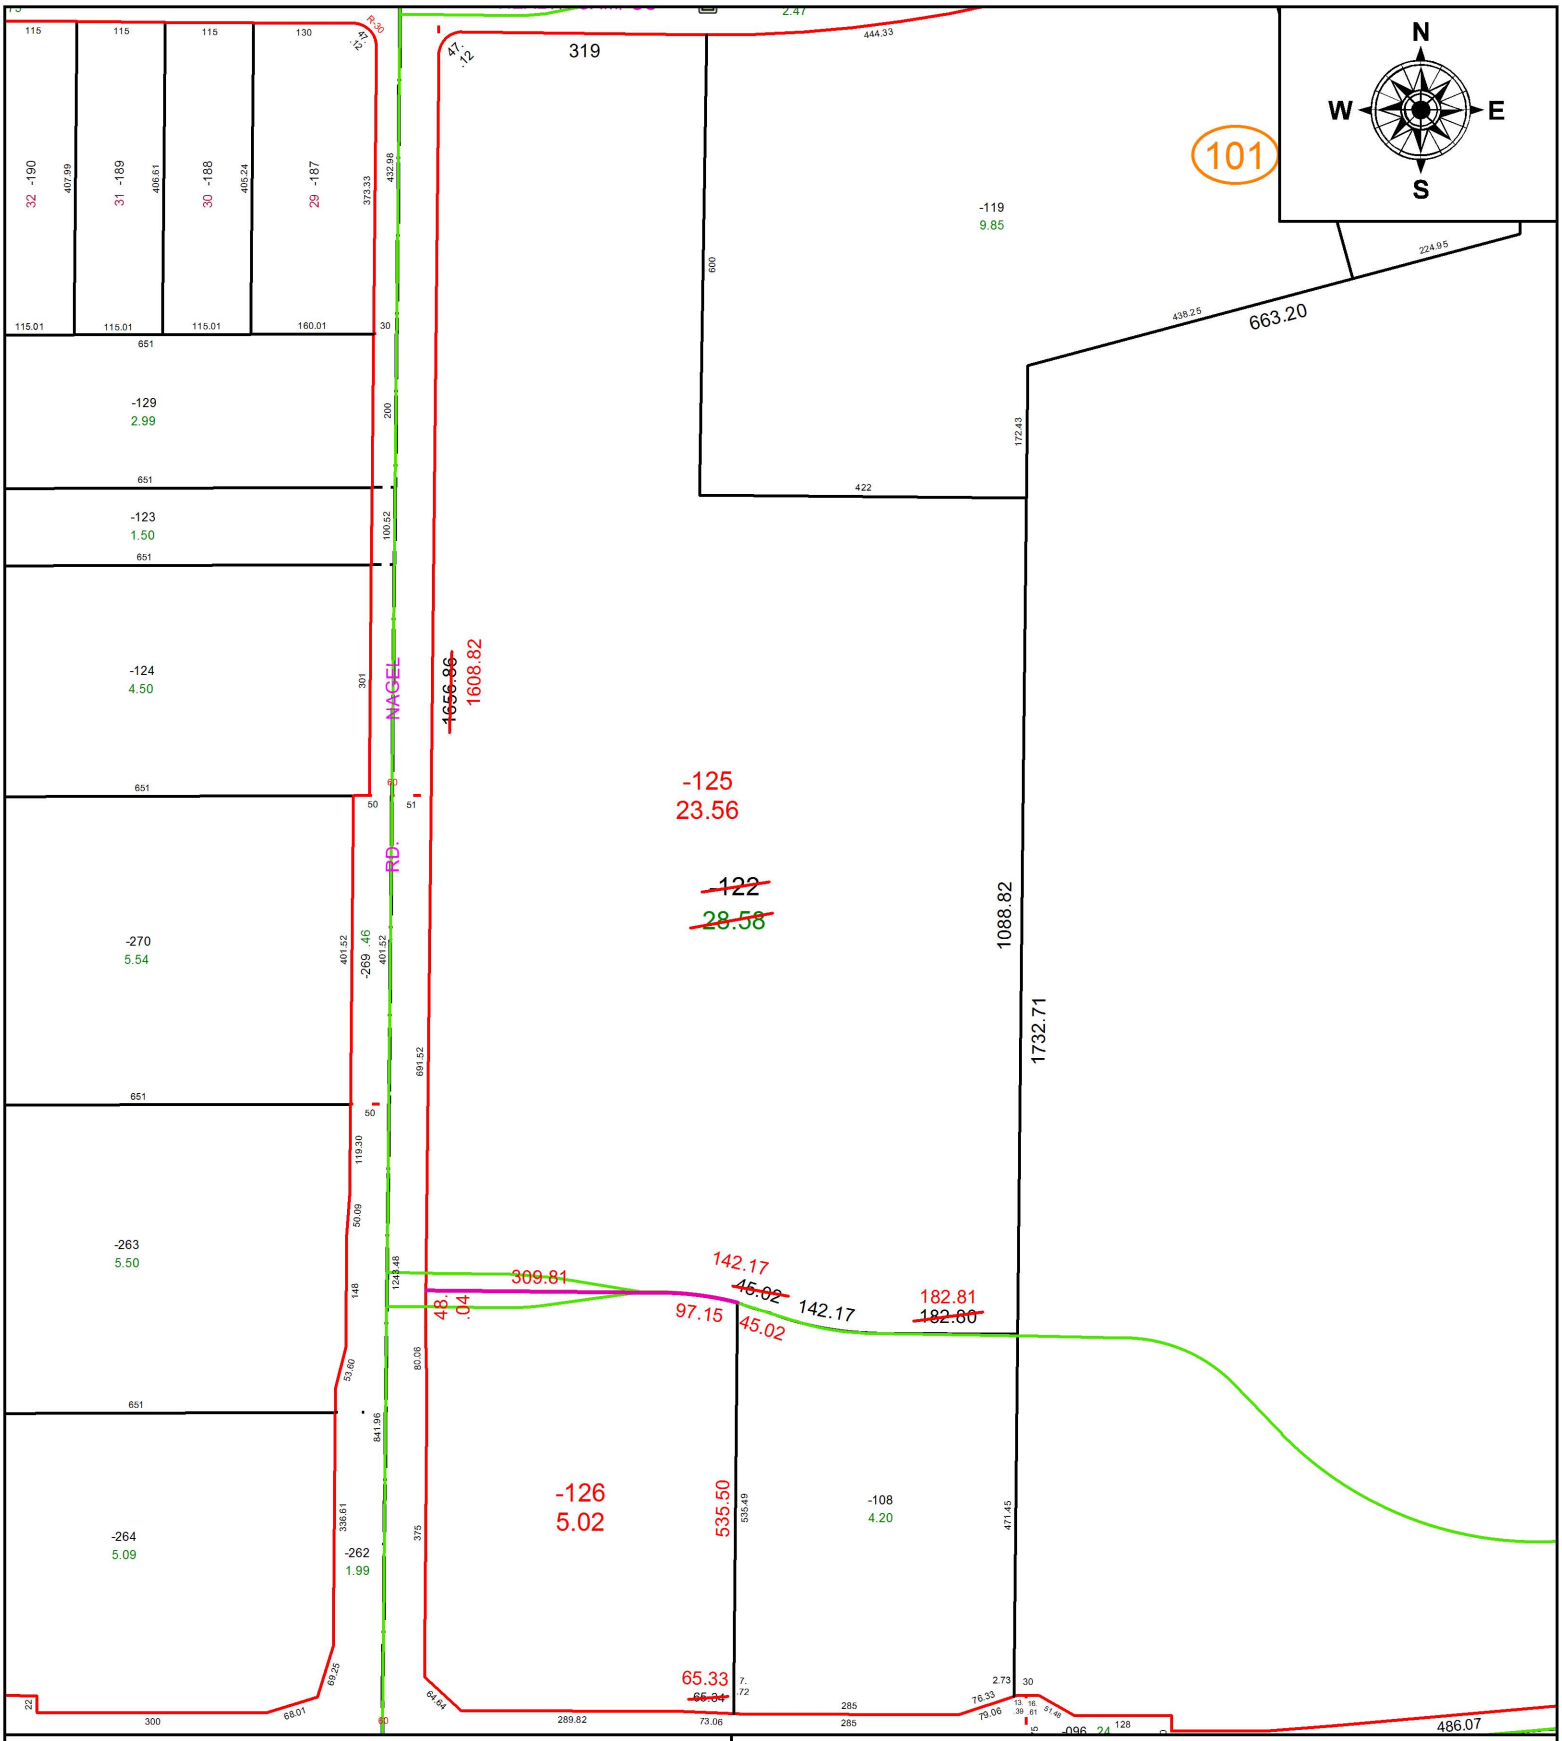

SPLITS/DEEDS PROCESSED

LORAIN COUNTY TAX MAP DEPARTMENT
226 MIDDLE AVE. ELYRIA, OH

SURVEYED BY: AMY M. KELLY
CLOSURE: 1:1,094,531
MAP PAGE(S): 4-00-028
APPOVED BY: RRM **DATE:** 11-25-19
SCALE: 1" = 250 **PRIOR INSTRUMENT:** 20180698949