PARENT PARCEL: ADD TO DUPLICATE - PER PV. 6 PG. 9

CHILD PARCEL: 02-02-023-103-019

STARTING POINT: 3 FOOT STRIP PER PV. 6 PG. 9

19-04054-A

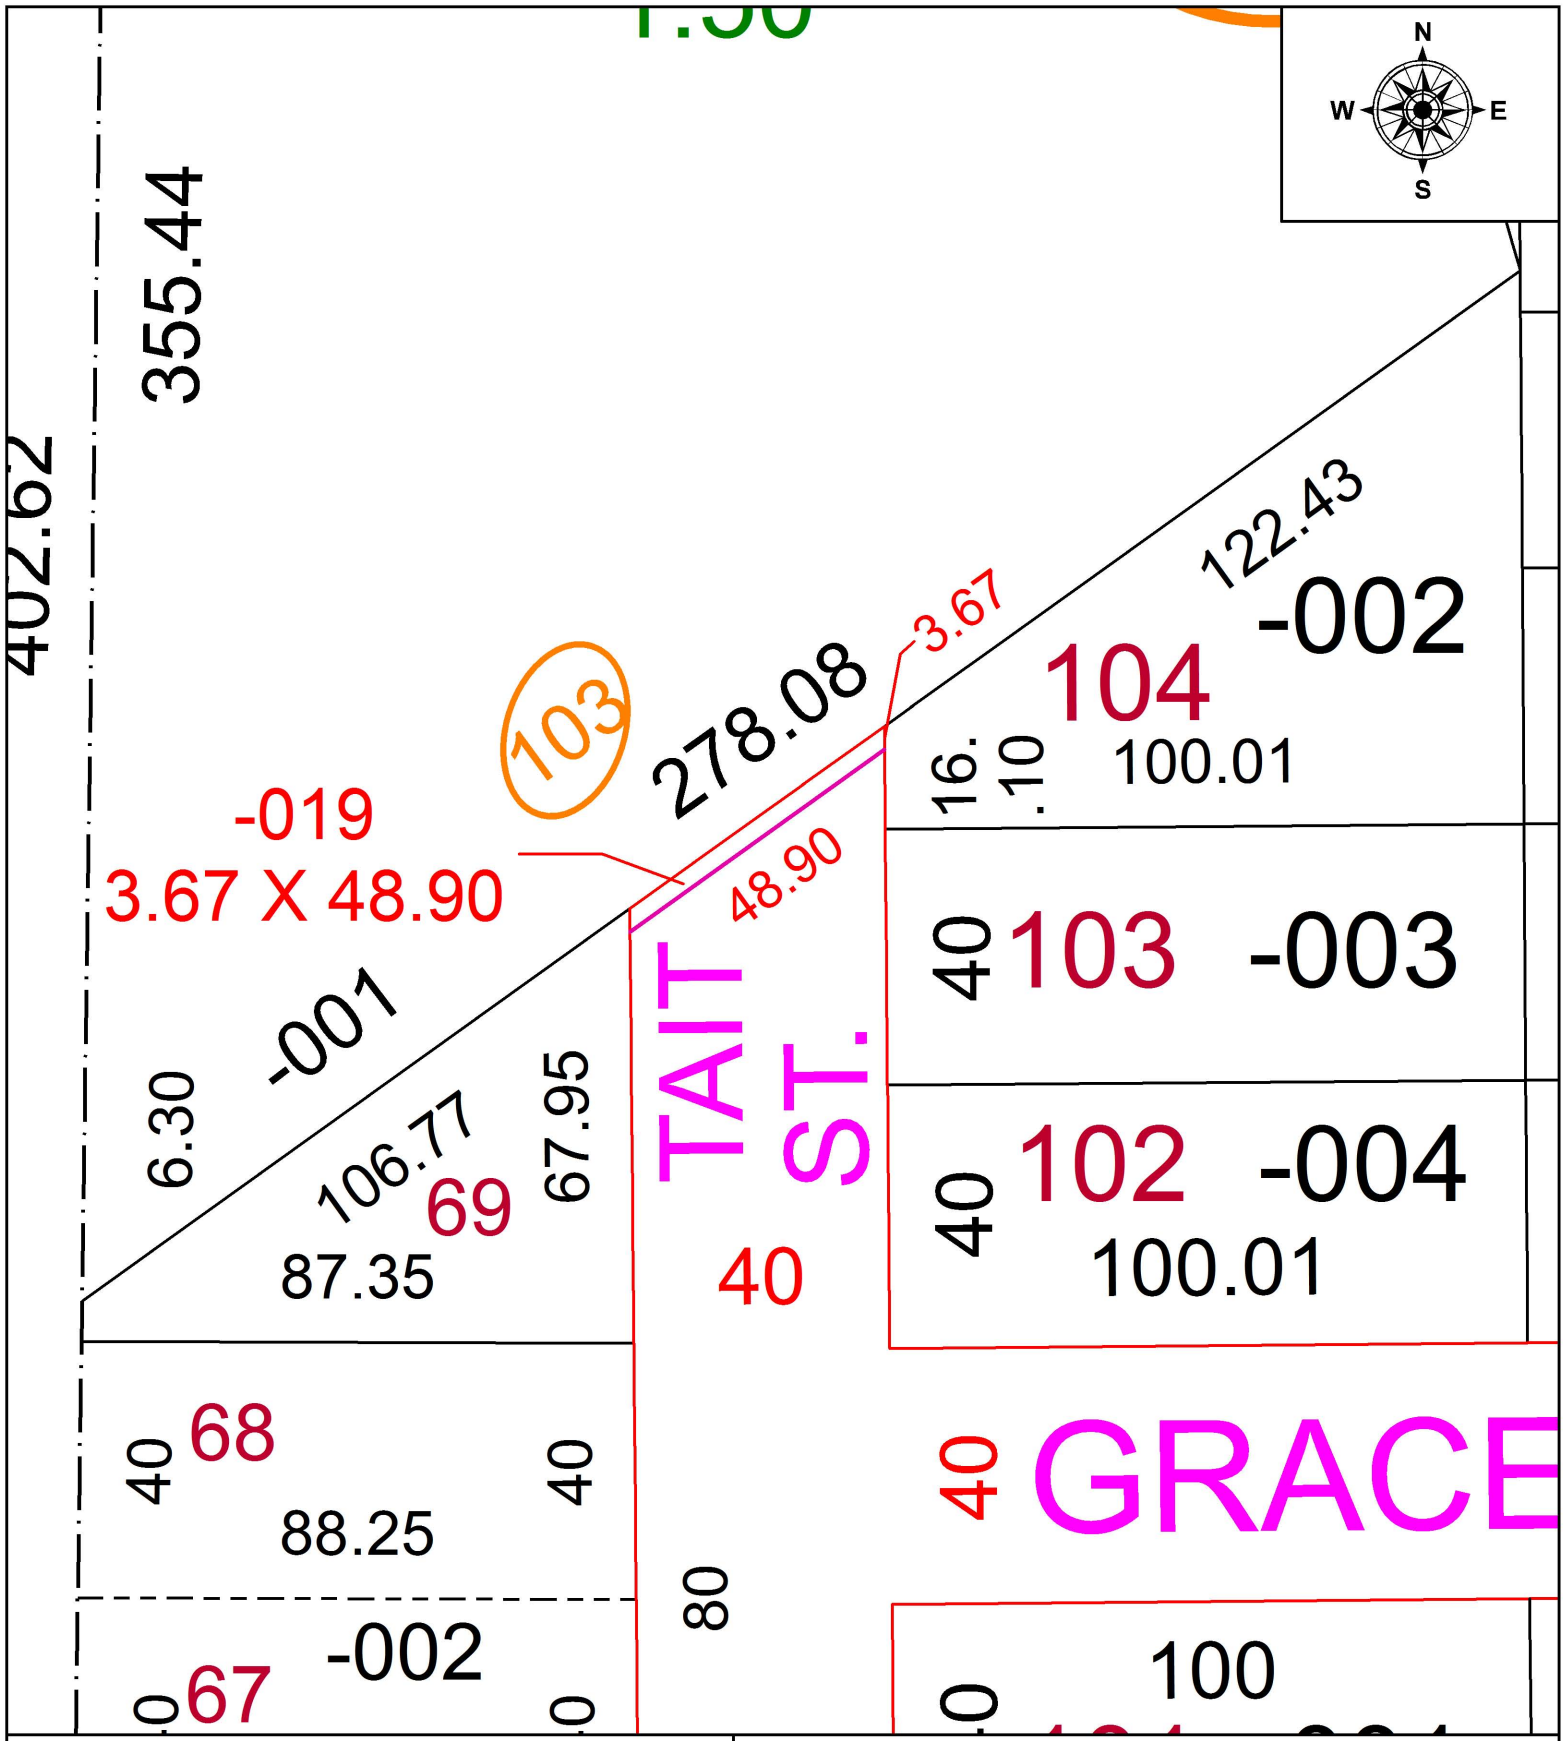

SPLITS/DEEDS PROCESSED

LORAIN COUNTY TAX MAP DEPARTMENT
226 MIDDLE AVE. ELYRIA, OH

SURVEYED BY: F.B. KRAUSE
CLOSURE: 1: 33,000
MAP PAGE(S): 02-02-023
APPOVED BY: TJS **DATE:** 2/27/19
SCALE: 1" = 30' **PRIOR INSTRUMENT:** NA