PARENT PARCEL: 04-00-016-102-101

CHILD PARCEL: 04-00-016-102-102 THRU -106

STARTING POINT: INTERSECTION OF C/L OF S.R. 83 AND C/L OF CHESTER RD

19-04054

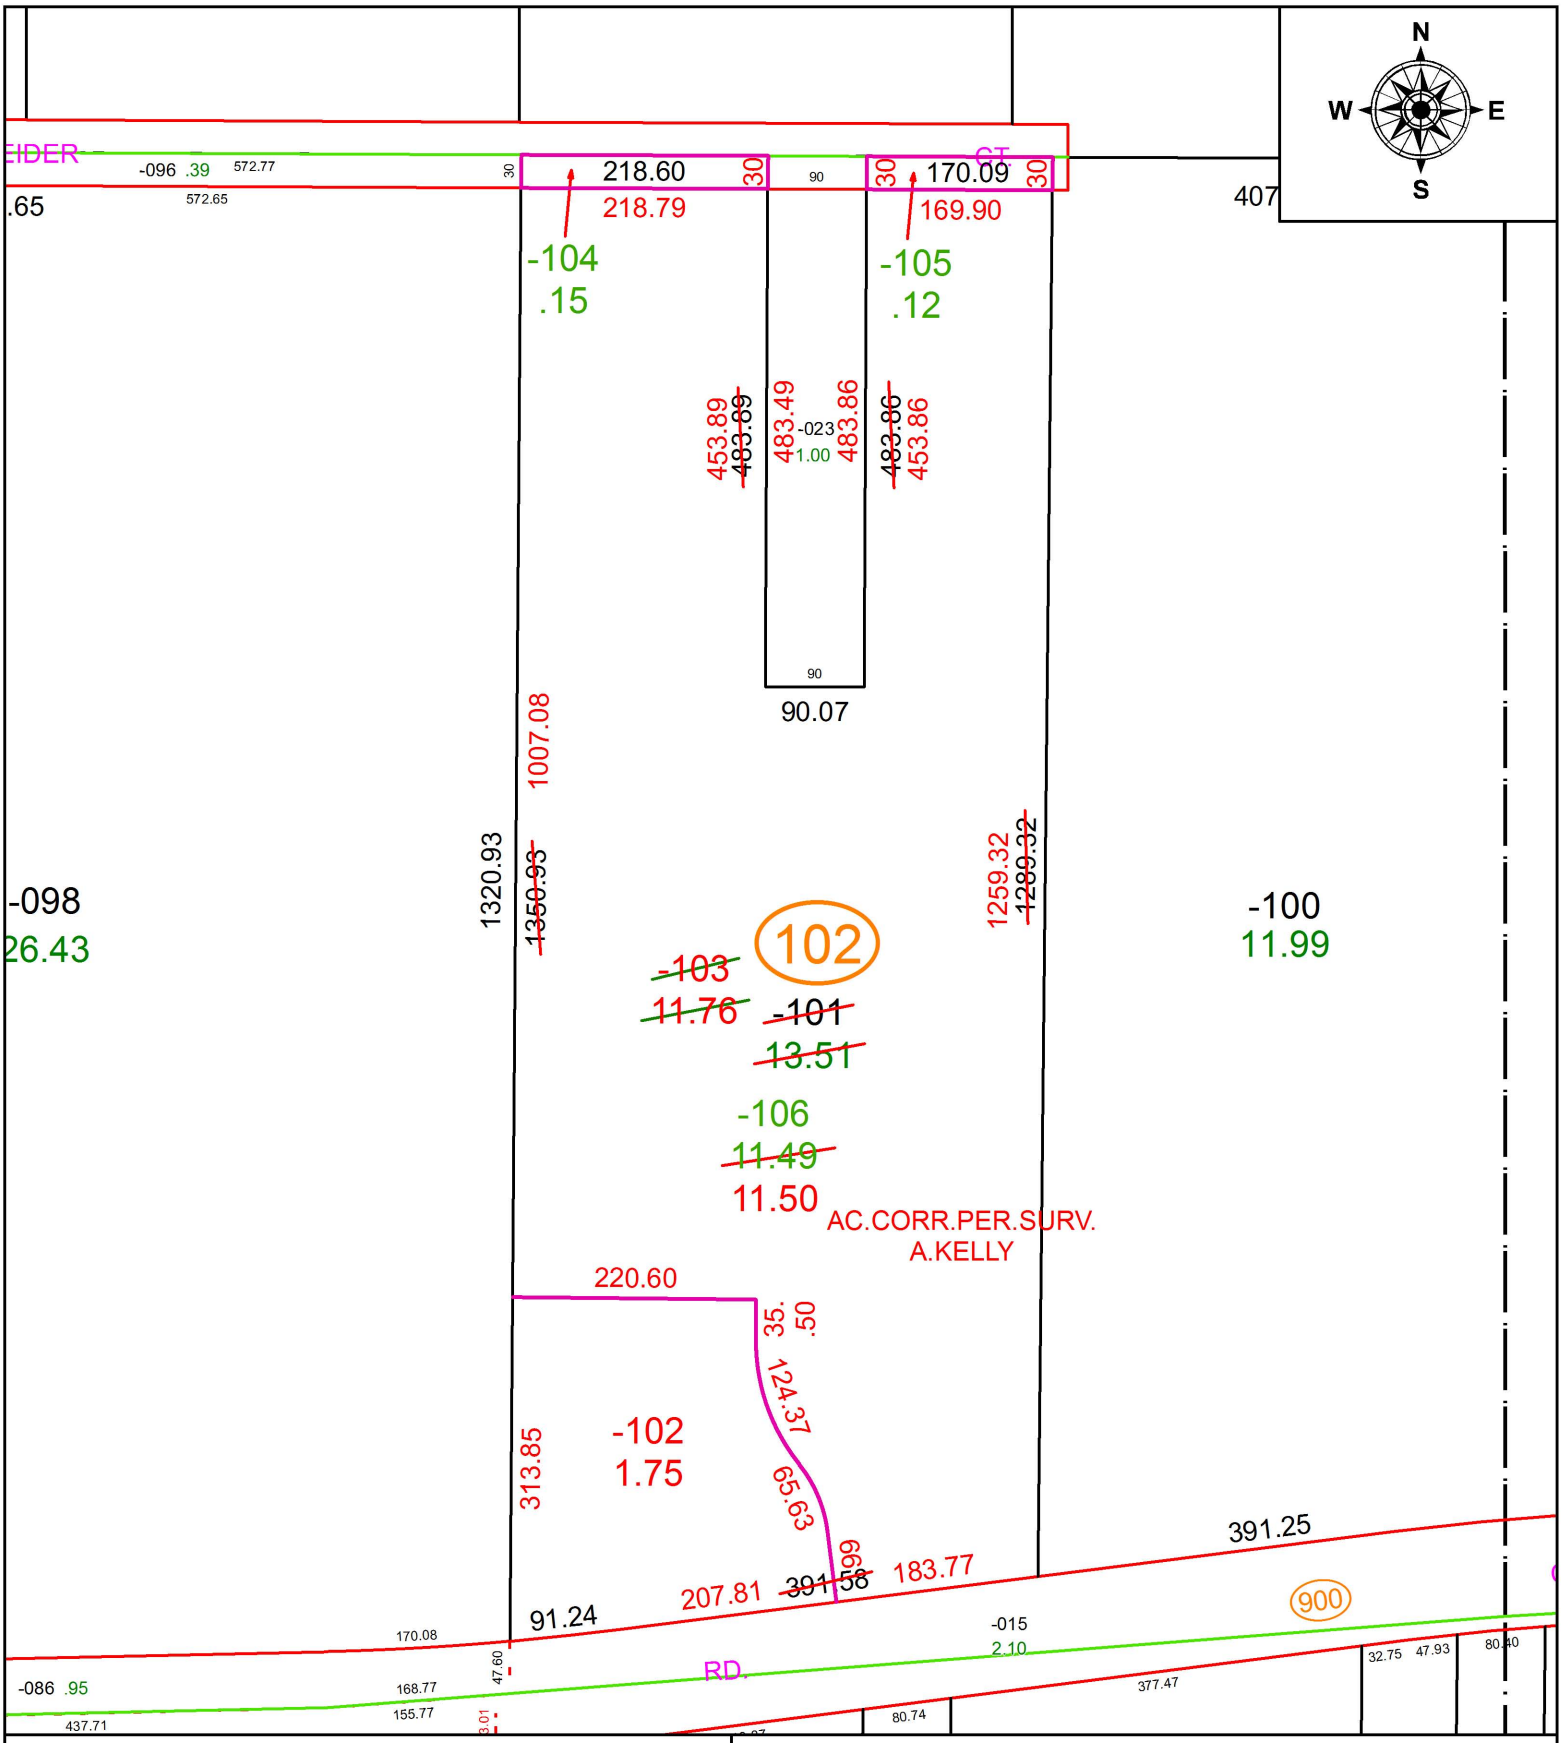

SPLITS/DEEDS PROCESSED

LORAIN COUNTY TAX MAP DEPARTMENT
226 MIDDLE AVE. ELYRIA, OH

SURVEYED BY: AMY M. KELLY
CLOSURE: 1:166,531
MAP PAGE(S): 4-00-016
APPOVED BY: RRM **DATE:** 11-25-19
SCALE: 1" = 175 **PRIOR INSTRUMENT:** 20170623993