CERTIFICATE OF CORRECTION

WINFIELD FARM NO. 3
PLAT VOL. 106, PG. 36
FILE NO. 2019-0704888

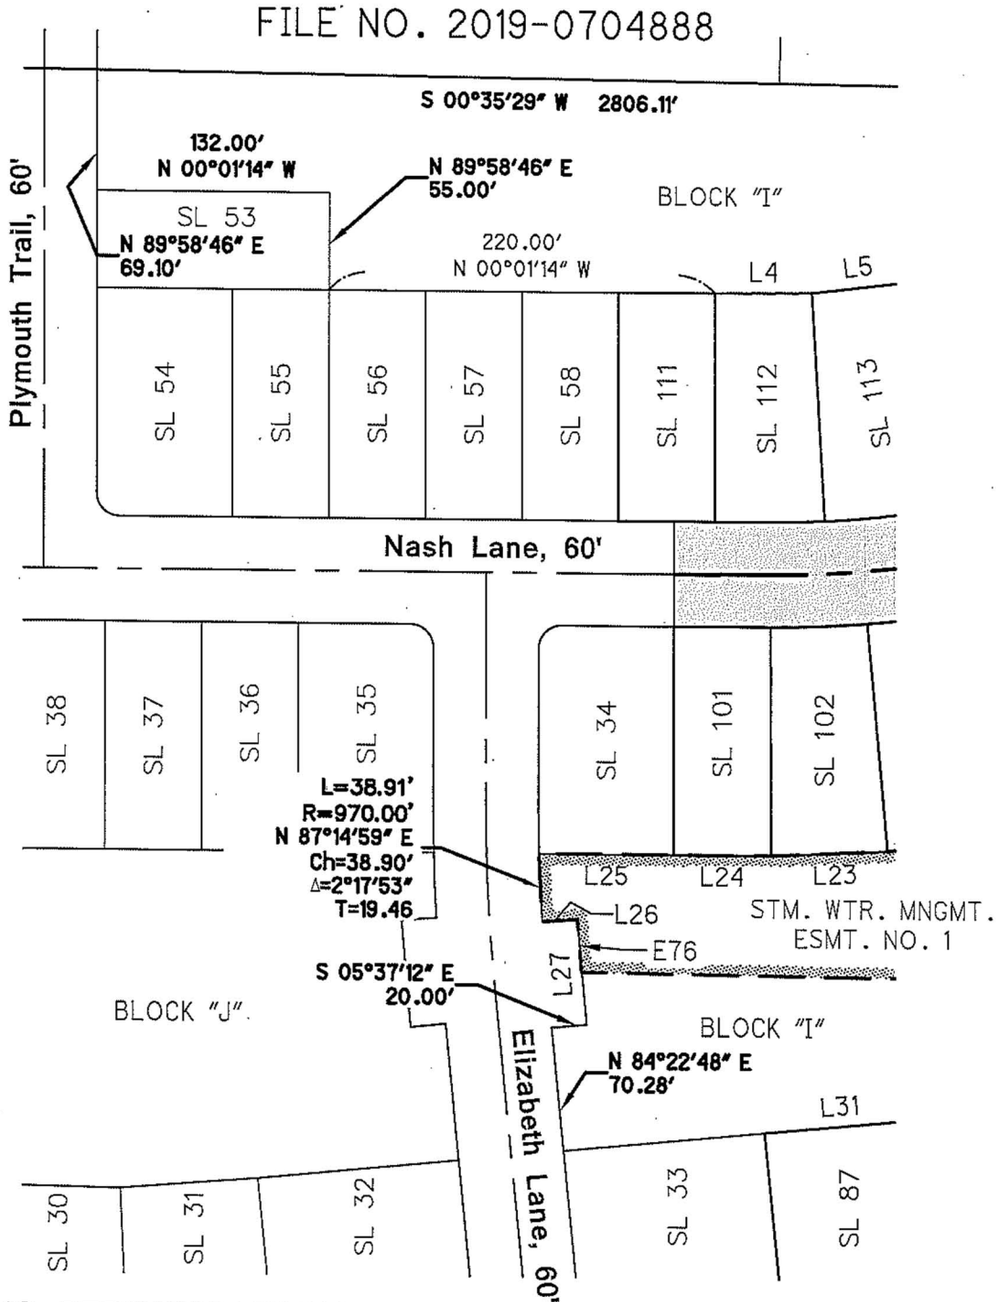

SURVEYOR'S CERTIFICATION

This is to certify that certain corrections need to be made to the plat of "The Reserve at Winfield Farm No. 3", as recorded in Lorain County Plat Vol. 106, Pg. 36.

The corrections required are as follows:

1. Curve information for C52 and C53.
   - •• C52 L= 45.71', R= 655.00', C= 45.70', CB= N 10°18'37" E, D= 03°59'55", T= 22.86'
   - •• C53 L= 35.78', R= 595.00', C= 35.77', CB= S 10°35'13" W, D= 03°26'43", T=17.89'
2. Additional courses for westerly and southerly border of Block "I" (see exhibit above)
3. Revise the overall distance for the easterly line of Block "I" from 4028.28' to 2514.48'

STATE OF OHIO
JEREMY M. SACK
S-8557
REGISTERED PROFESSIONAL SURVEYOR

Jeremy M. Sack, P.S. S-8557 — 2-28-2019 Date

Before me a notary public in and for Medina County, Ohio, personally appeared the above named Jeremy M. Sack, P.S. S-8557 who acknowledged the making of the foregoing instrument and the signing of this certificate of correction to be their own free act and deed. In testimony whereof I have hereunto set my hand and official seal at Sharon Center, Ohio this 28th day of February, 2019.

Notary public and Attorney at Law
Prepared by

My commission ~~expires~~ has no expiration date pursuant to Ohio Rev. Code Sec. 147.03

TGC Engineering, LLC
1310 SHARON COPLEY ROAD, P.O. BOX 37
SHARON-CENTER, OHIO 44274
(PHONE) 330.590.8004 (FAX) 888.820.8423

SCALE (IN FEET) 1 inch = 100 ft. (0, 50, 100)

WINFIELD FARM NO. 3 | PROJECT NUMBER 1447 | DATE 2019-02-27 | 1/1

File: f:\tgc eng\projects\1447-p3 nr nech p3 - north ridgeville\dwg\1447 p3 certificate of correction.dwg Saved: 2/28/2019 6:40 AM (brennen ott) Plotted: 2/28/2019 6:40 AM (brennen ott) Plotstyler: (TGC 2017.ctb) Scaler: (1:1) Page Setup: (-----)