PARENT PARCEL: 03-00-057-112-014

CHILD PARCEL: 03-00-057-112-023, -024

STARTING POINT: INTERSECTION OF C/L OF ROOT RD. AND OLD C/L OF COLORADO AVE.

19-04057

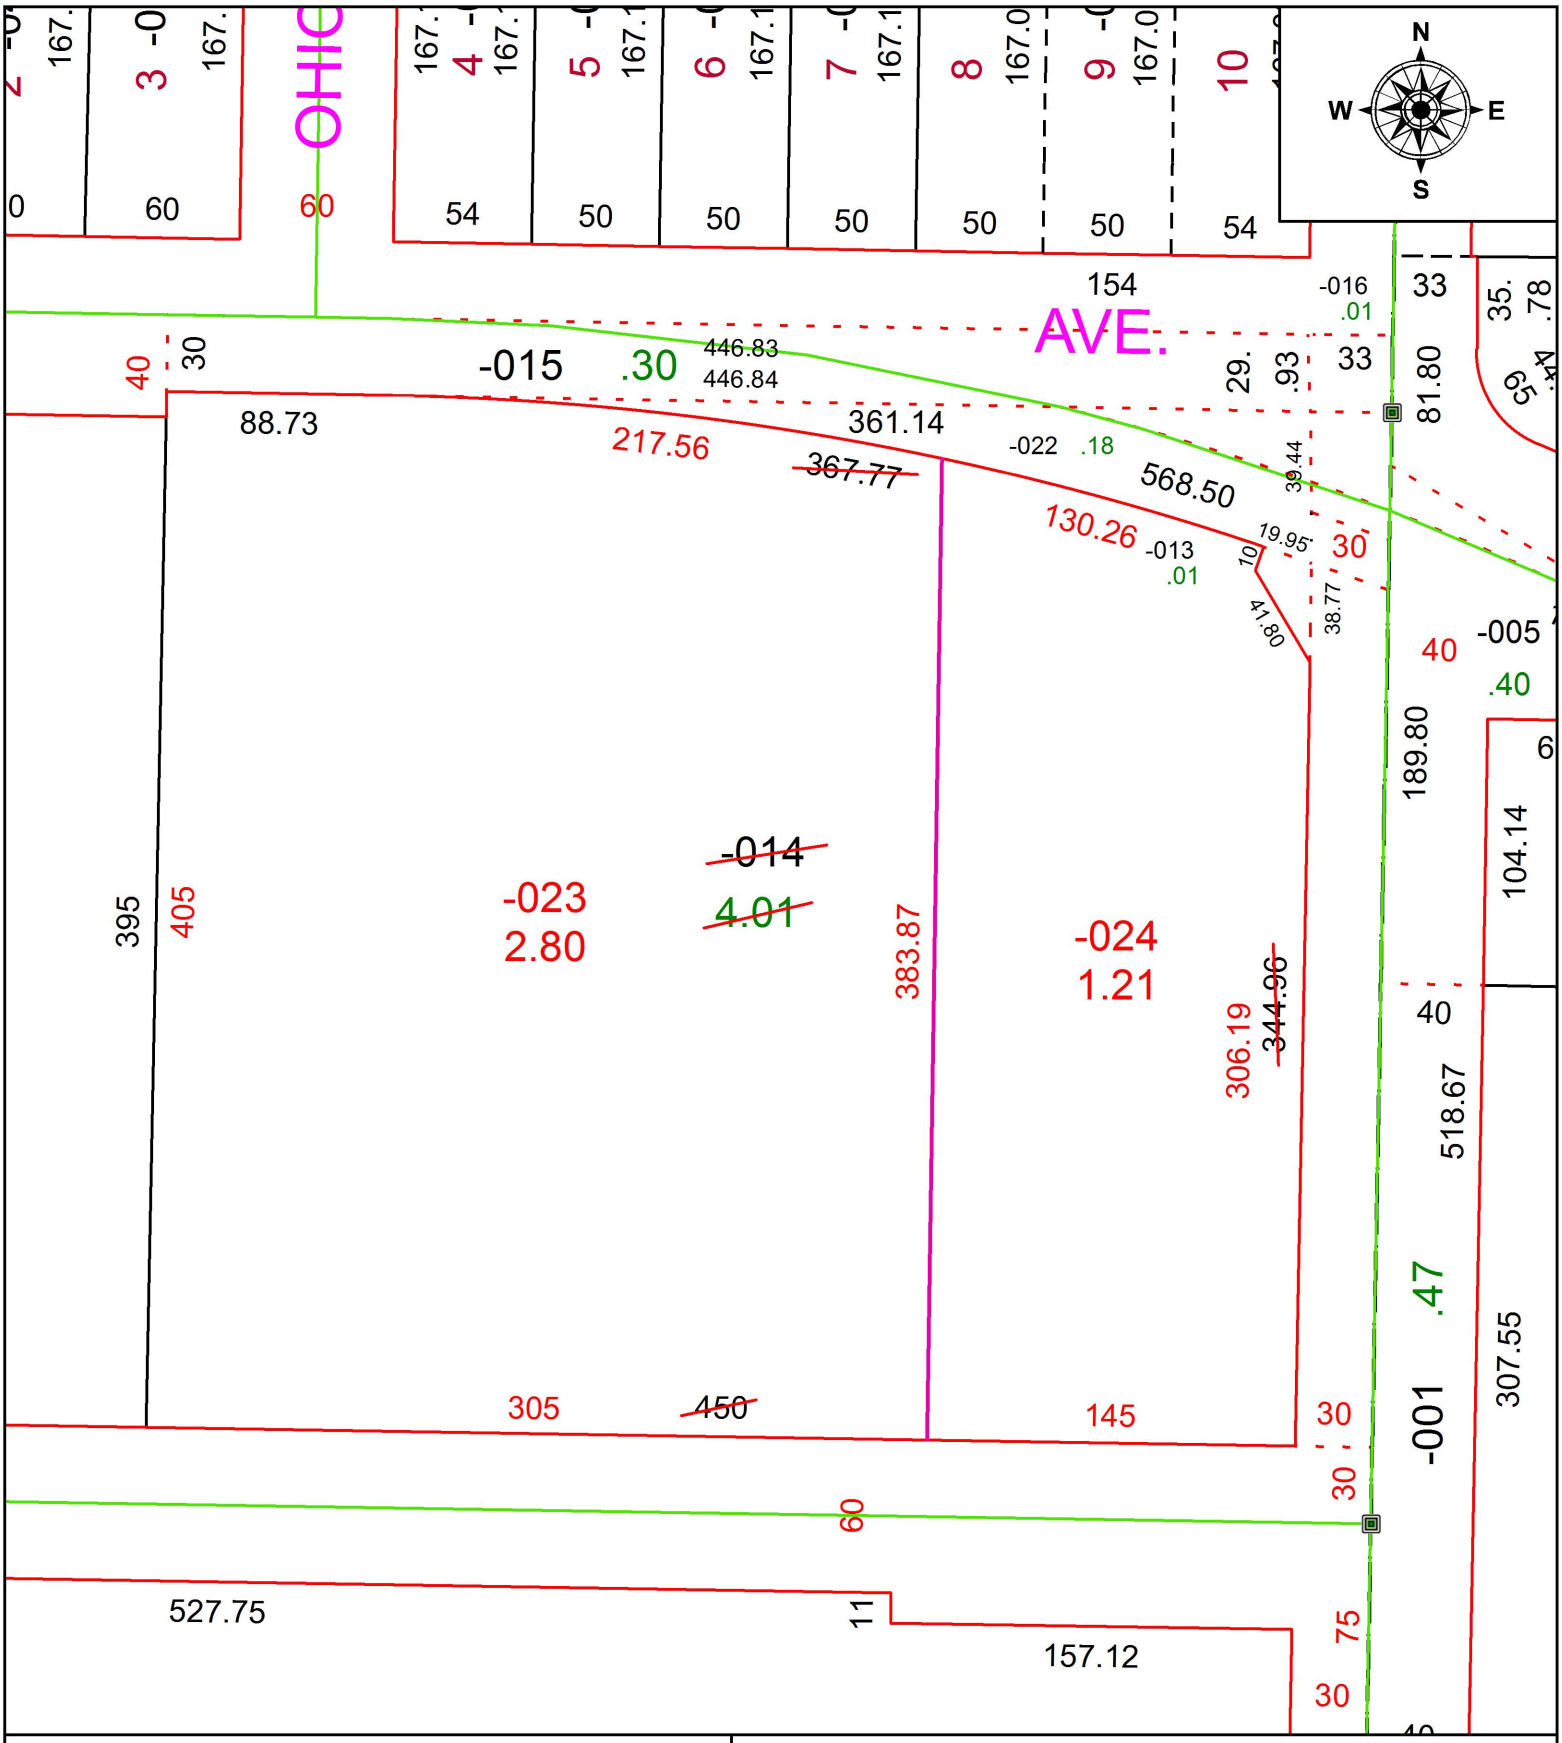

SPLITS/DEEDS PROCESSED

LORAIN COUNTY TAX MAP DEPARTMENT
226 MIDDLE AVE. ELYRIA, OH

SURVEYED BY: DOUGLAS A. HASEL
CLOSURE: 1:133,394
MAP PAGE(S): 3-00-057
APPOVED BY: RRM **DATE:** 12-3-19
SCALE: 1" = 75 **PRIOR INSTRUMENT:** 20170653712