PARENT PARCEL: 04-00-027-102-033

CHILD PARCEL:

STARTING POINT: INTERSECTION OF C/L OF NAGEL RD. AND C/L OF S.R.254

19-04058-A

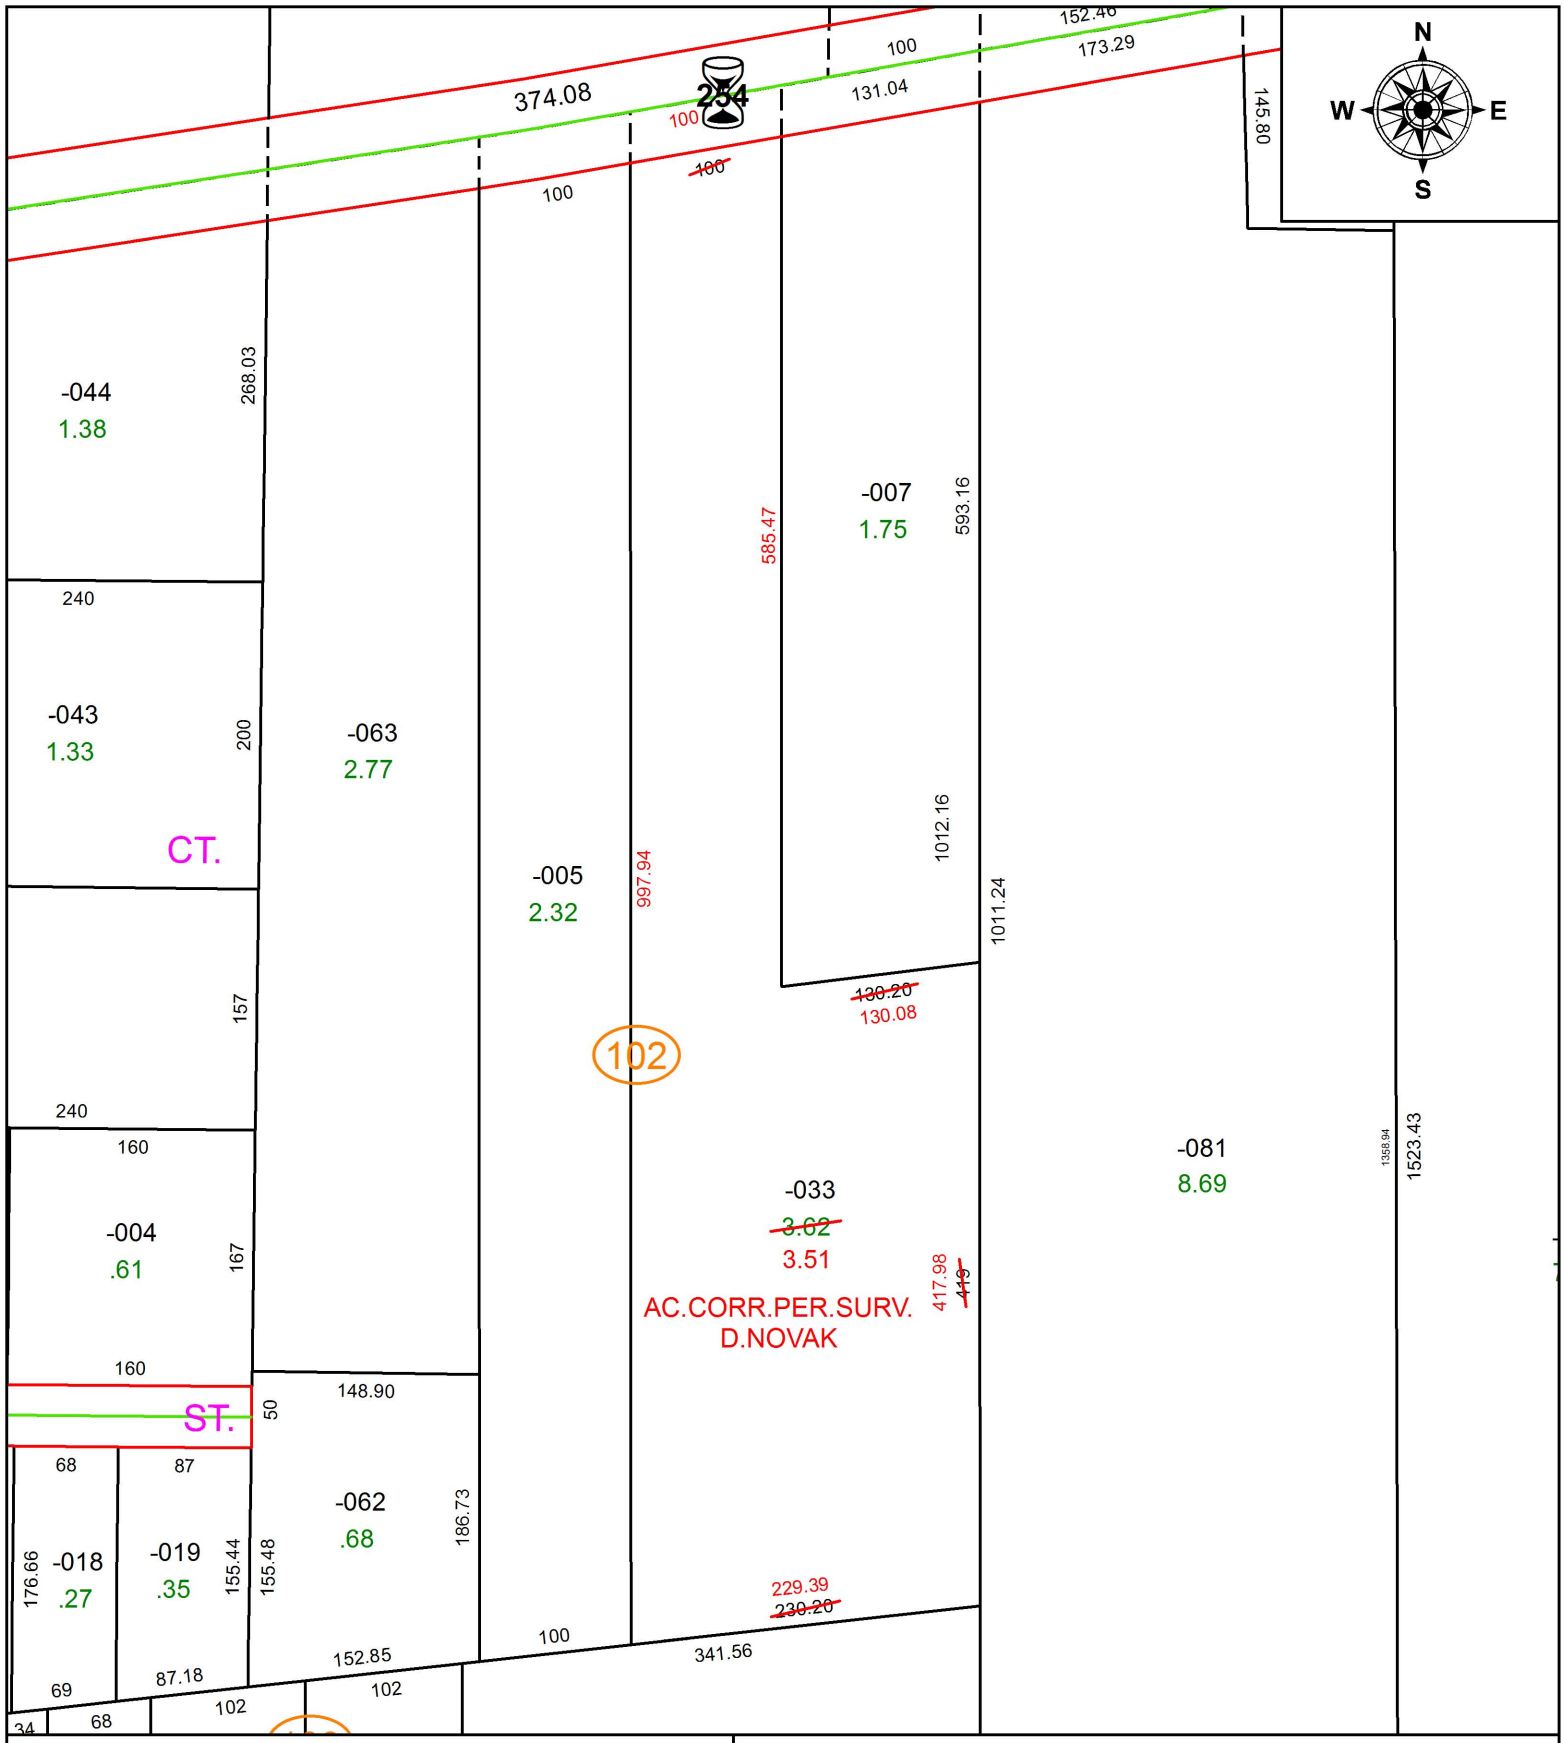

SPLITS/DEEDS PROCESSED

LORAIN COUNTY TAX MAP DEPARTMENT
226 MIDDLE AVE. ELYRIA, OH

SURVEYED BY: DAVID W. NOVAK
CLOSURE: 1: 313,725
MAP PAGE(S): 4-00-027
APPOVED BY: RRM **DATE:** 3-11-19
SCALE: 1" = 125 **PRIOR INSTRUMENT:** 20110363111