PARENT PARCEL: 01-00-062-000-062
CHILD PARCEL: 01-00-062-000-063, -064
STARTING POINT: INTERSECTION OF C/L OF BANK ST. AND SOUTH LINE OF O.L.62

19-04058

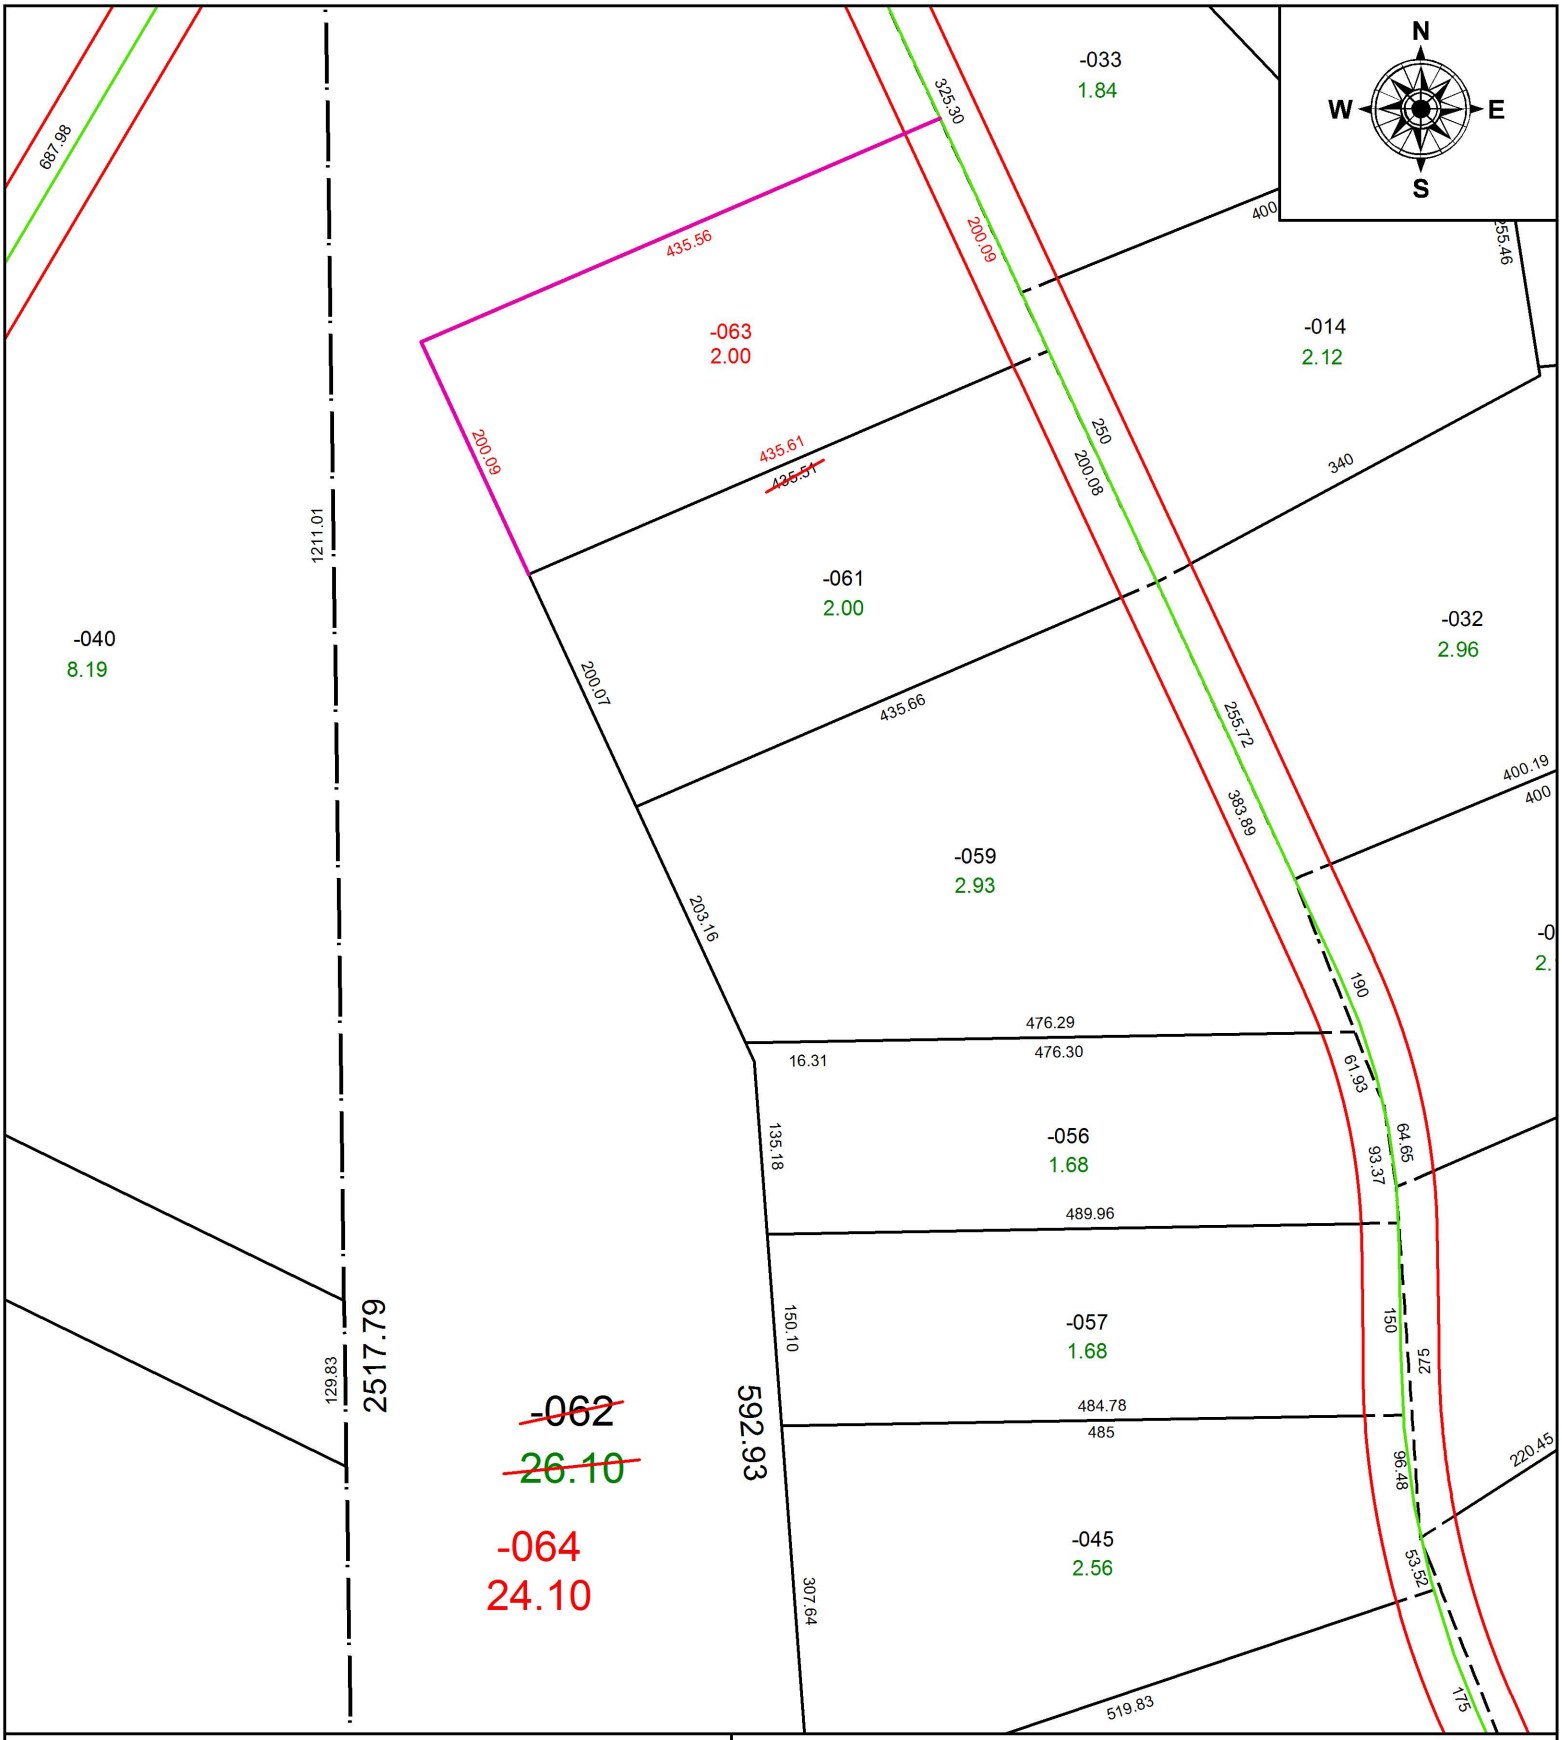

SPLITS/DEEDS PROCESSED

LORAIN COUNTY TAX MAP DEPARTMENT
226 MIDDLE AVE. ELYRIA, OH

SURVEYED BY: BRENT D. ANDERSON
CLOSURE: 1:630,360
MAP PAGE(S): 1-00-062
APPOVED BY: RRM **DATE:** 12-4-19
SCALE: 1" = 150 **PRIOR INSTRUMENT:** 20190721106