PARENT PARCEL: 08-00-086-000-002, -032

CHILD PARCEL: 08-00-086-000-051 THRU -056

STARTING POINT: INTERSECTION OF C/L OF GIFFORD RD. AND NORTH LINE OF O.L.86

19-04059

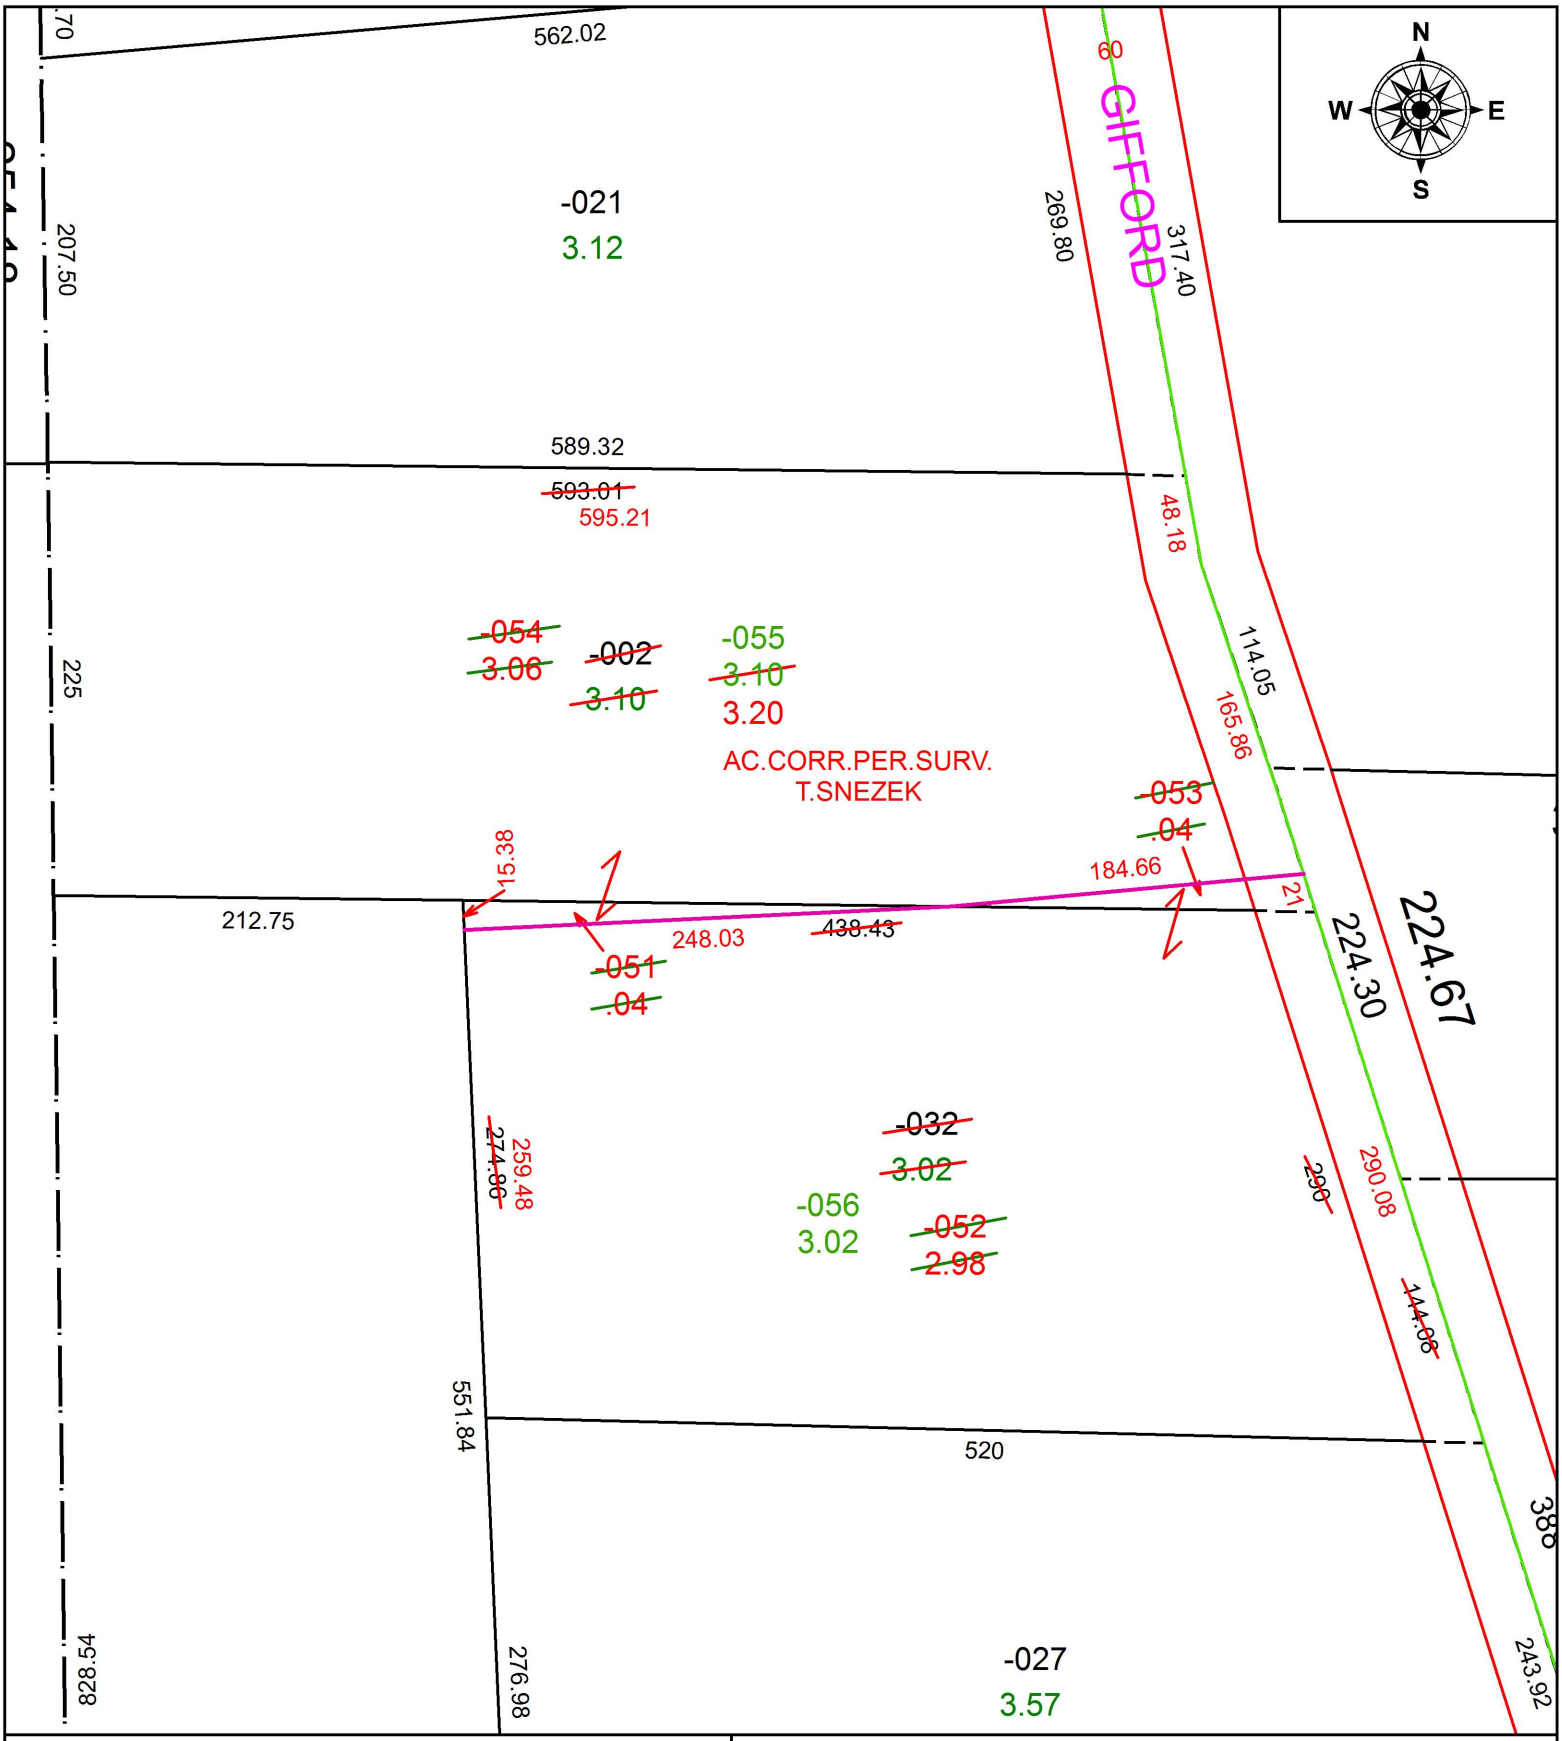

SPLITS/DEEDS PROCESSED

LORAIN COUNTY TAX MAP DEPARTMENT
226 MIDDLE AVE. ELYRIA, OH

SURVEYED BY: THOMAS M. SNEZEK
CLOSURE: 1:50,417
MAP PAGE(S): 8-00-086
APPOVED BY: RRM **DATE:** 12-6-19
SCALE: 1" = 100 **PRIOR INSTRUMENT:** 20070236323