PARENT PARCEL: 19-02-029-000-007, -040

CHILD PARCEL: 19-02-029-000-044 THRU -046

STARTING POINT: INTERSECTION OF C/L OF JONES RD. AND C/L OF SOOY RD.

19-04060

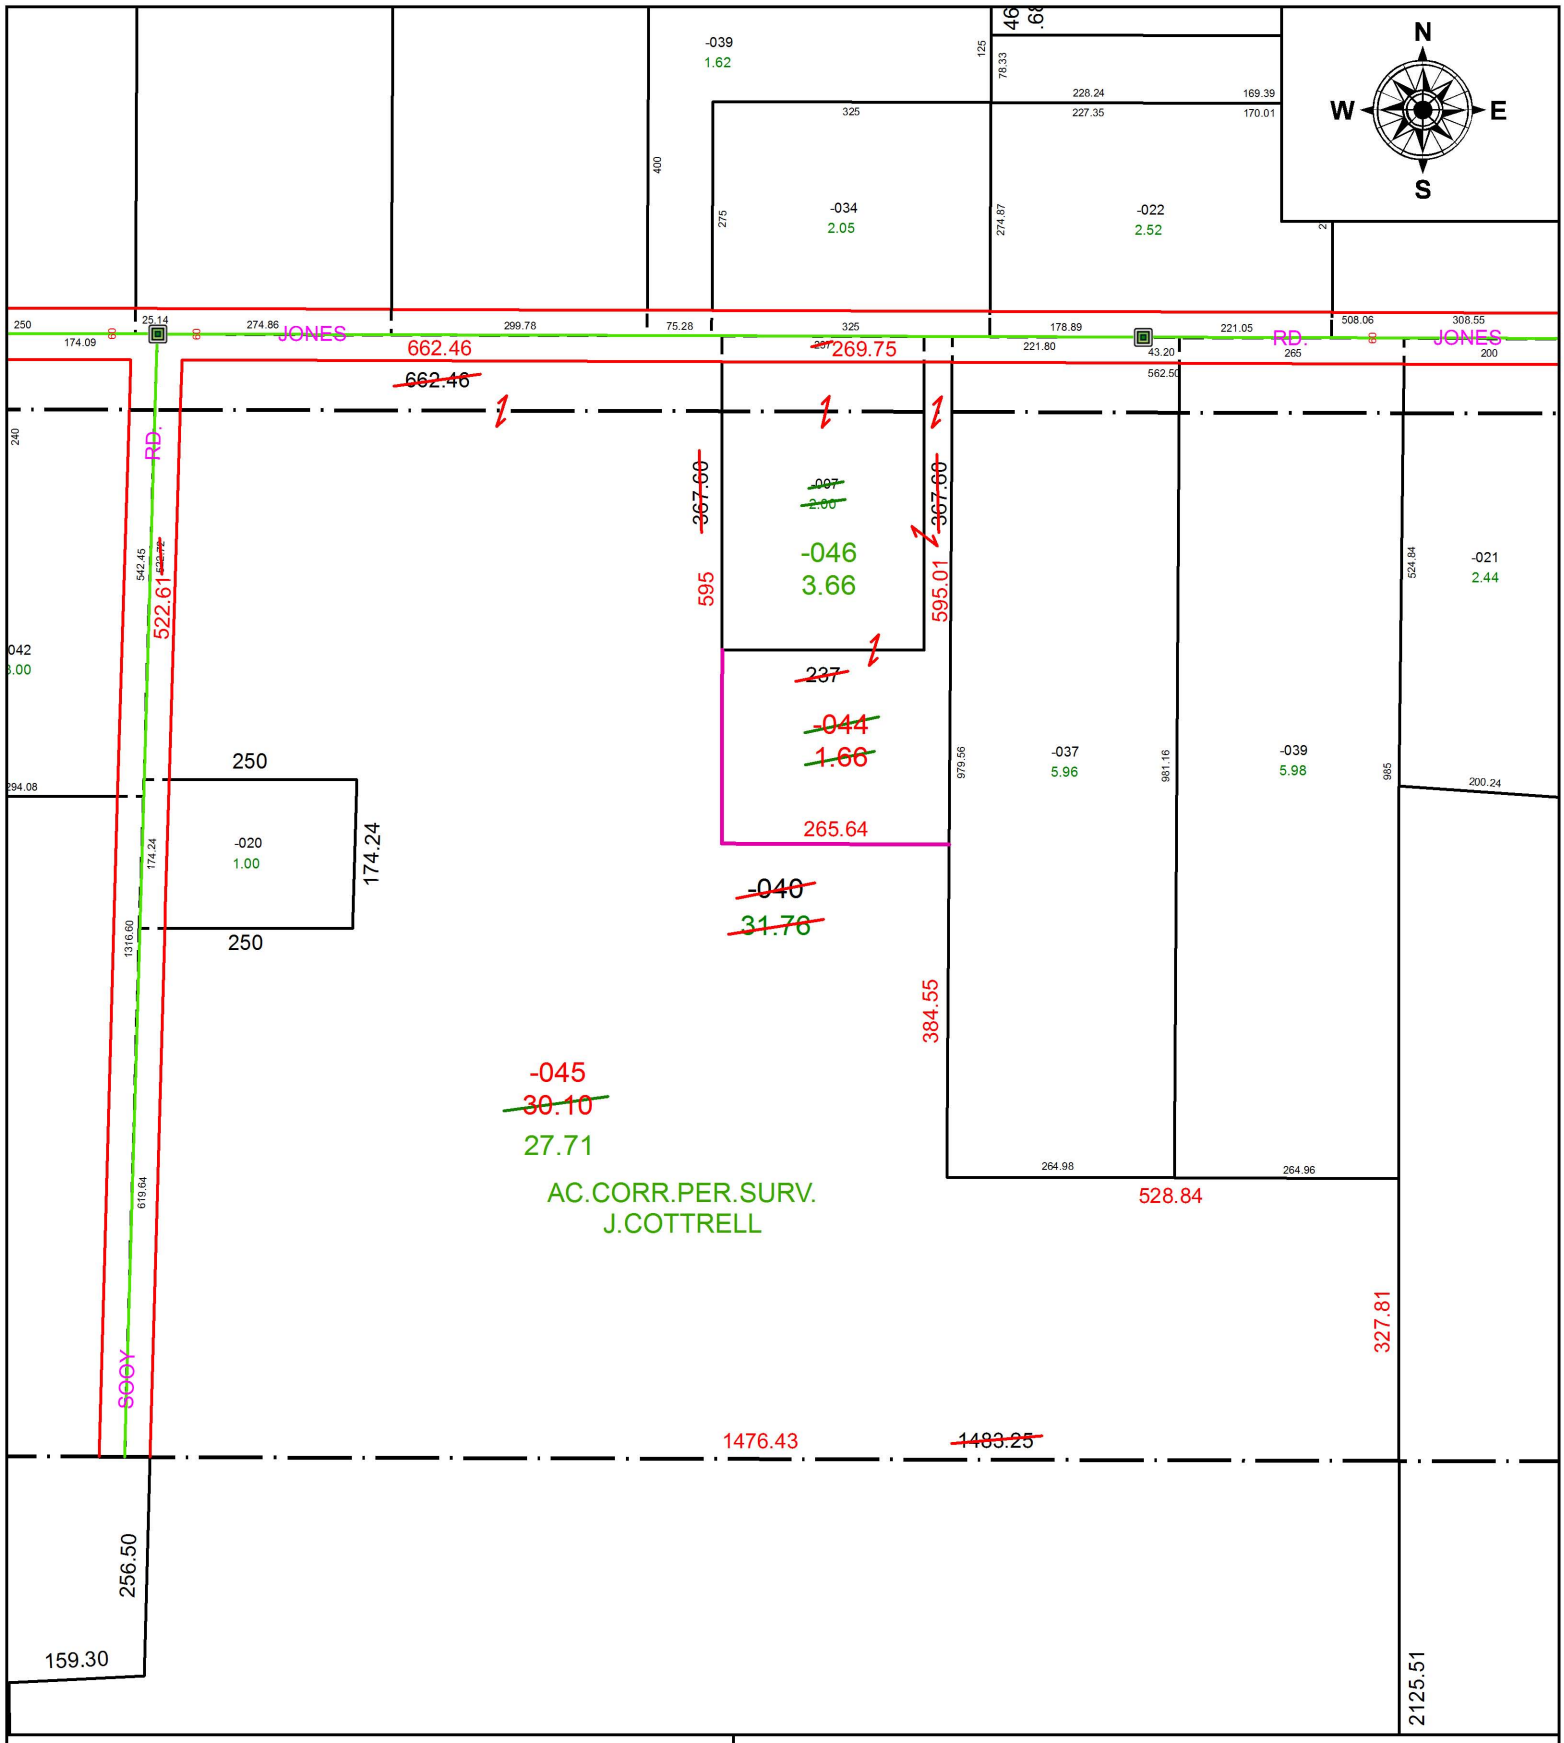

SPLITS/DEEDS PROCESSED

LORAIN COUNTY TAX MAP DEPARTMENT
226 MIDDLE AVE. ELYRIA, OH

SURVEYED BY: JAMES ALLEN COTTRELL
CLOSURE: 1:406,021
MAP PAGE(S): 19-02-029
APPOVED BY: RRM **DATE:** 12-6-19
SCALE: 1" = 225 **PRIOR INSTRUMENT:** 20000688554