PARENT PARCEL: 07-00-018-101-020, -280

CHILD PARCEL: 07-00-018-101-328, -329

STARTING POINT: INTERSECTION OF C/L OF MILLS RD. AND C/L OF MILLS INDUSTRIAL PKWY

19-04063

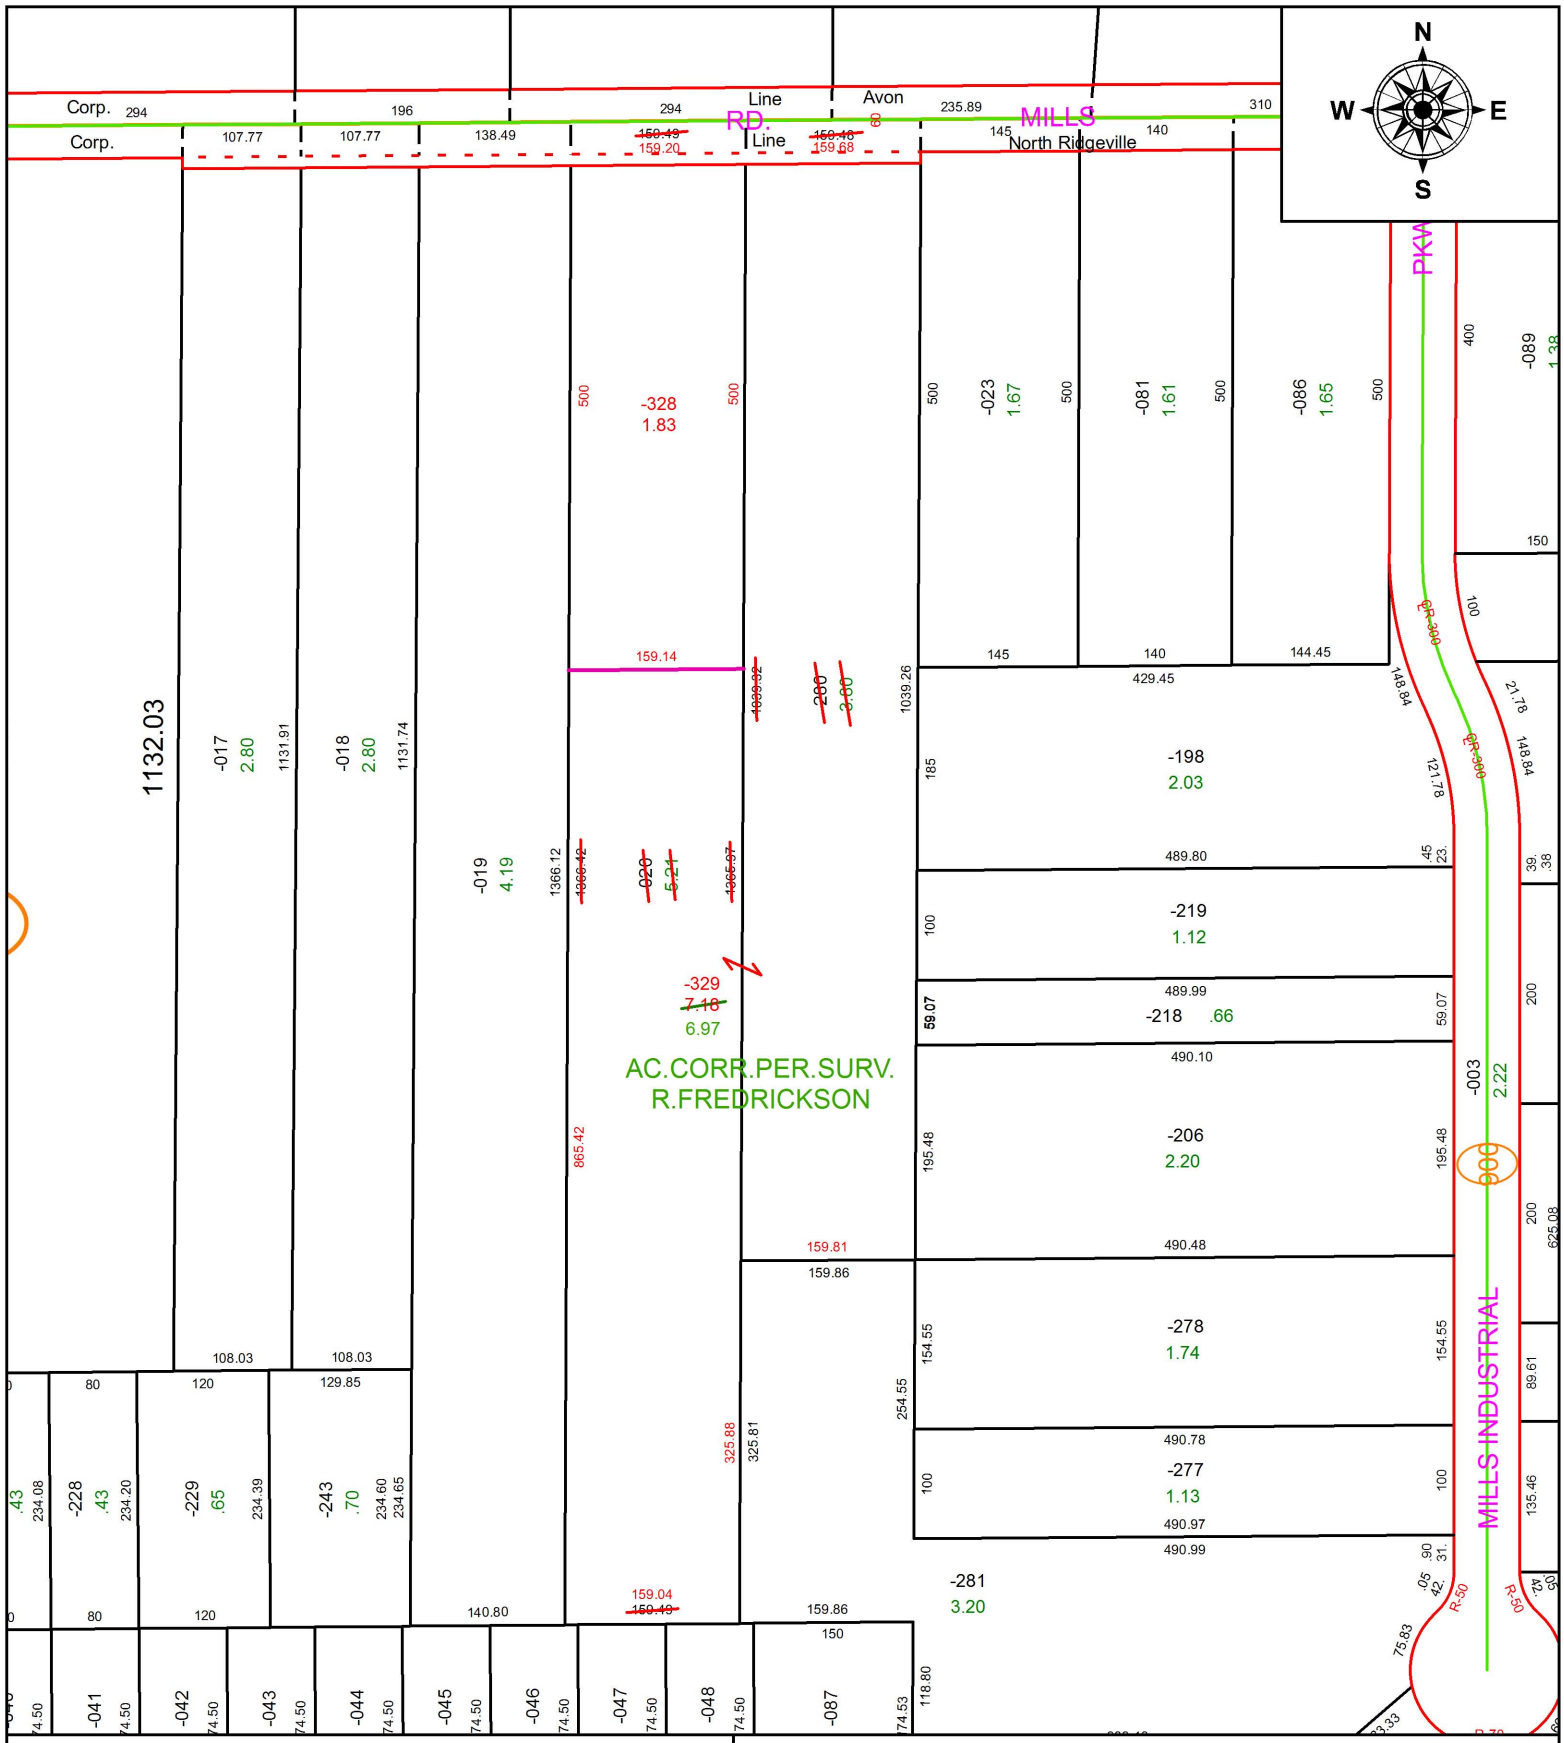

SPLITS/DEEDS PROCESSED

LORAIN COUNTY TAX MAP DEPARTMENT
226 MIDDLE AVE. ELYRIA, OH

SURVEYED BY: RICHARD A. FREDRICKSON
CLOSURE: 1:1,512,366
MAP PAGE(S): 7-00-018
APPOVED BY: RRM **DATE:** 12-10-19
SCALE: 1" = 175 **PRIOR INSTRUMENT:** 20170642669