PARENT PARCEL: 19-03-004-000-001, 19-03-005-000-002
CHILD PARCEL: 19-03-004-000-005, 19-03-005-000-005
STARTING POINT: SOUTHWEST CORNER OF O.L.7 TR. 4

19-04064

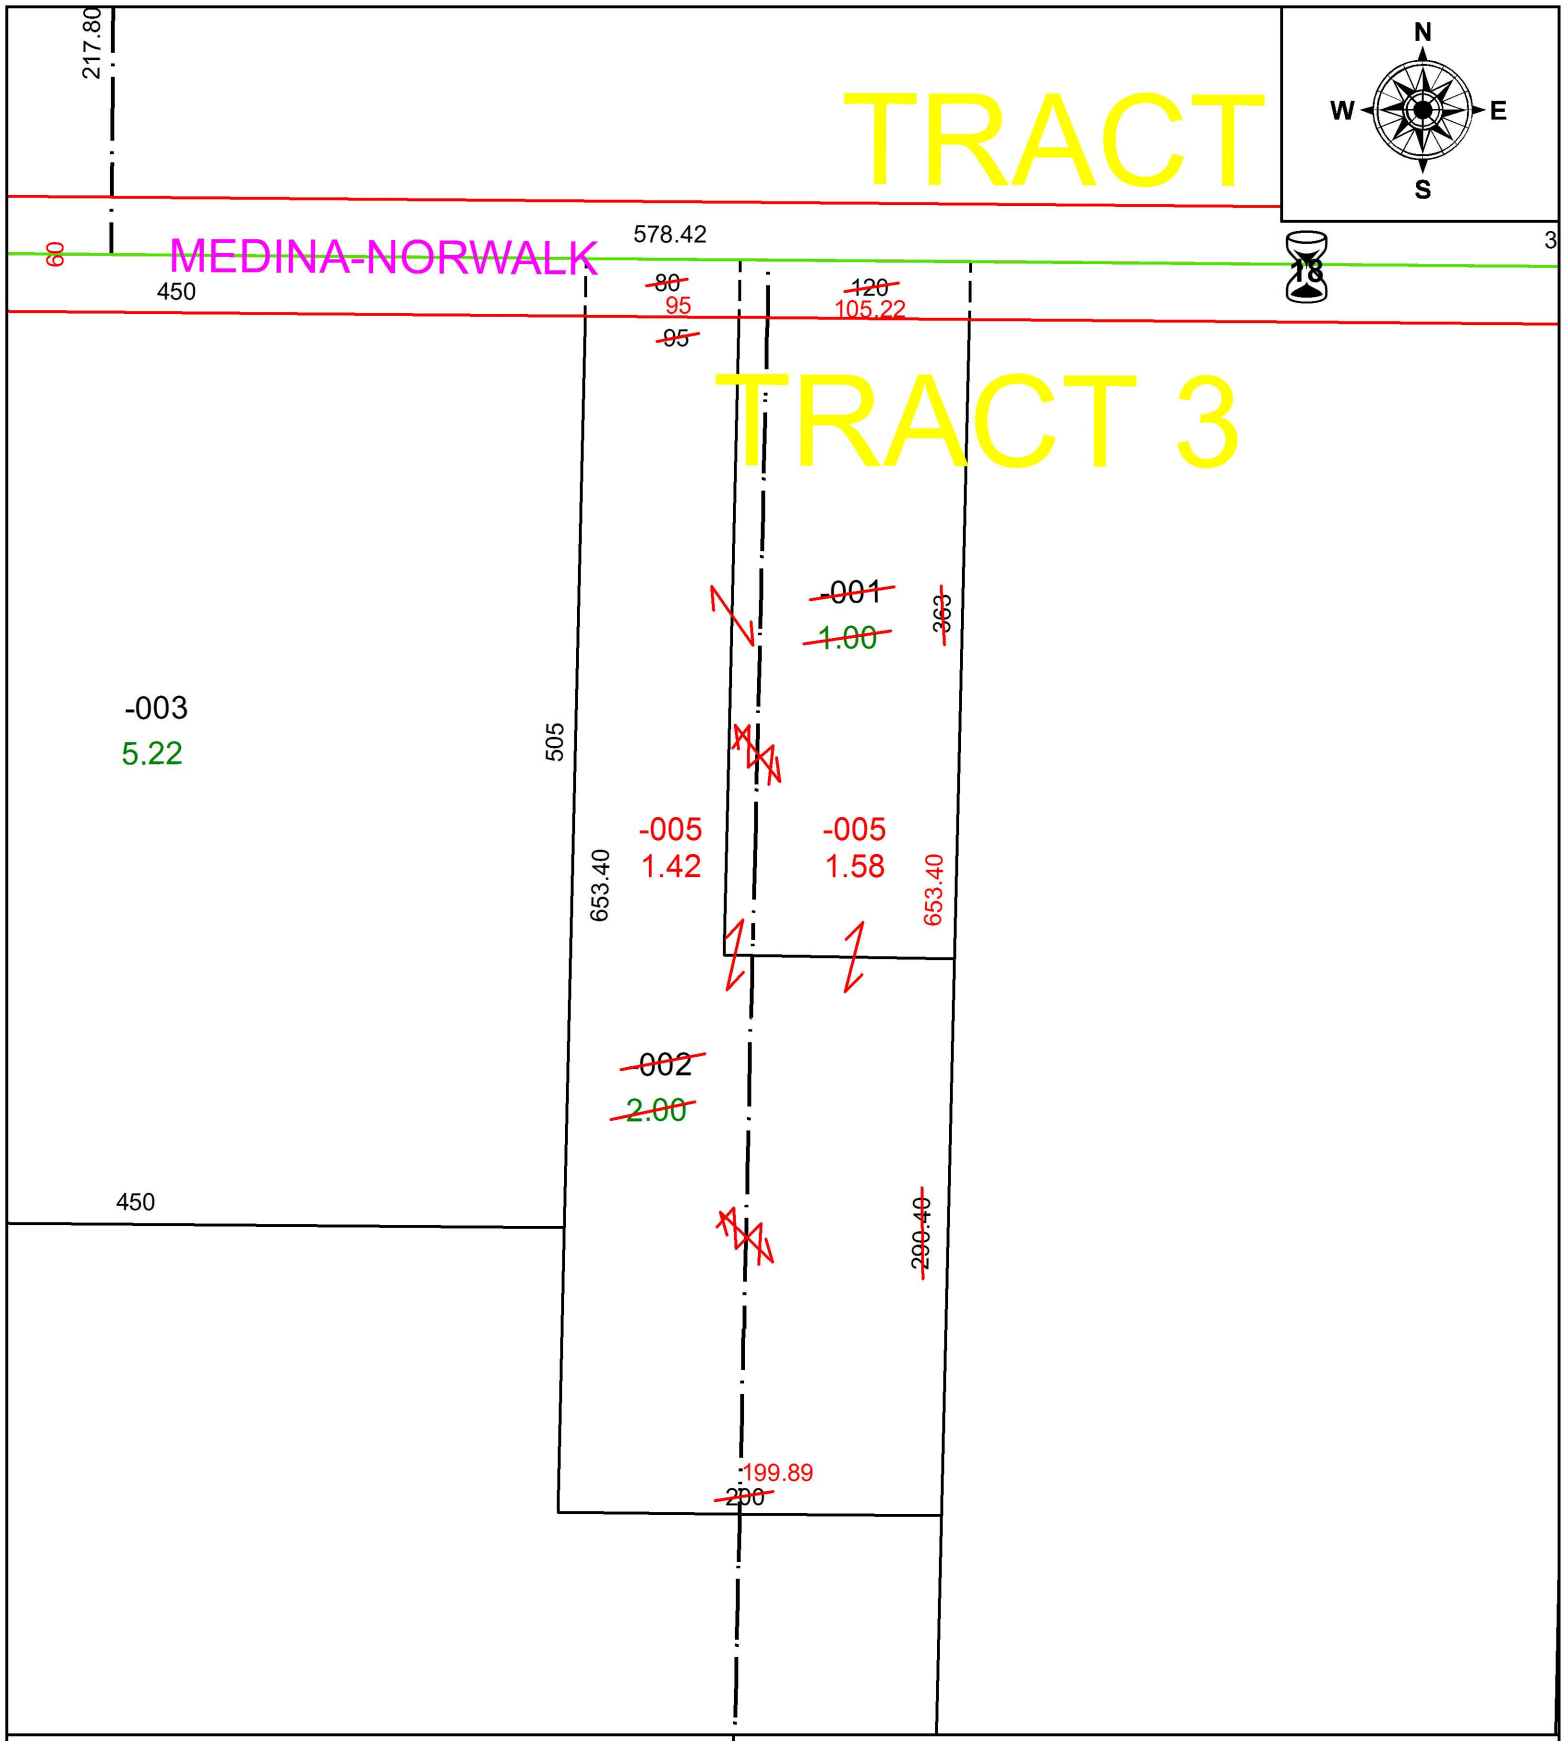

SPLITS/DEEDS PROCESSED
LORAIN COUNTY TAX MAP DEPARTMENT
226 MIDDLE AVE. ELYRIA, OH

SURVEYED BY: THOMAS A. SIMON
CLOSURE: 1:655,103
MAP PAGE(S): 19-03-004
APPOVED BY: RRM **DATE:** 12-11-19
SCALE: 1" = 100 **PRIOR INSTRUMENT:** 20180687553