PARENT PARCEL: 06-26-069-000-014

CHILD PARCEL:

STARTING POINT: INTERSECTION OF C/L OF WATER ST. AND C/L OF WEST BRIDGE ST.

19-04065-D

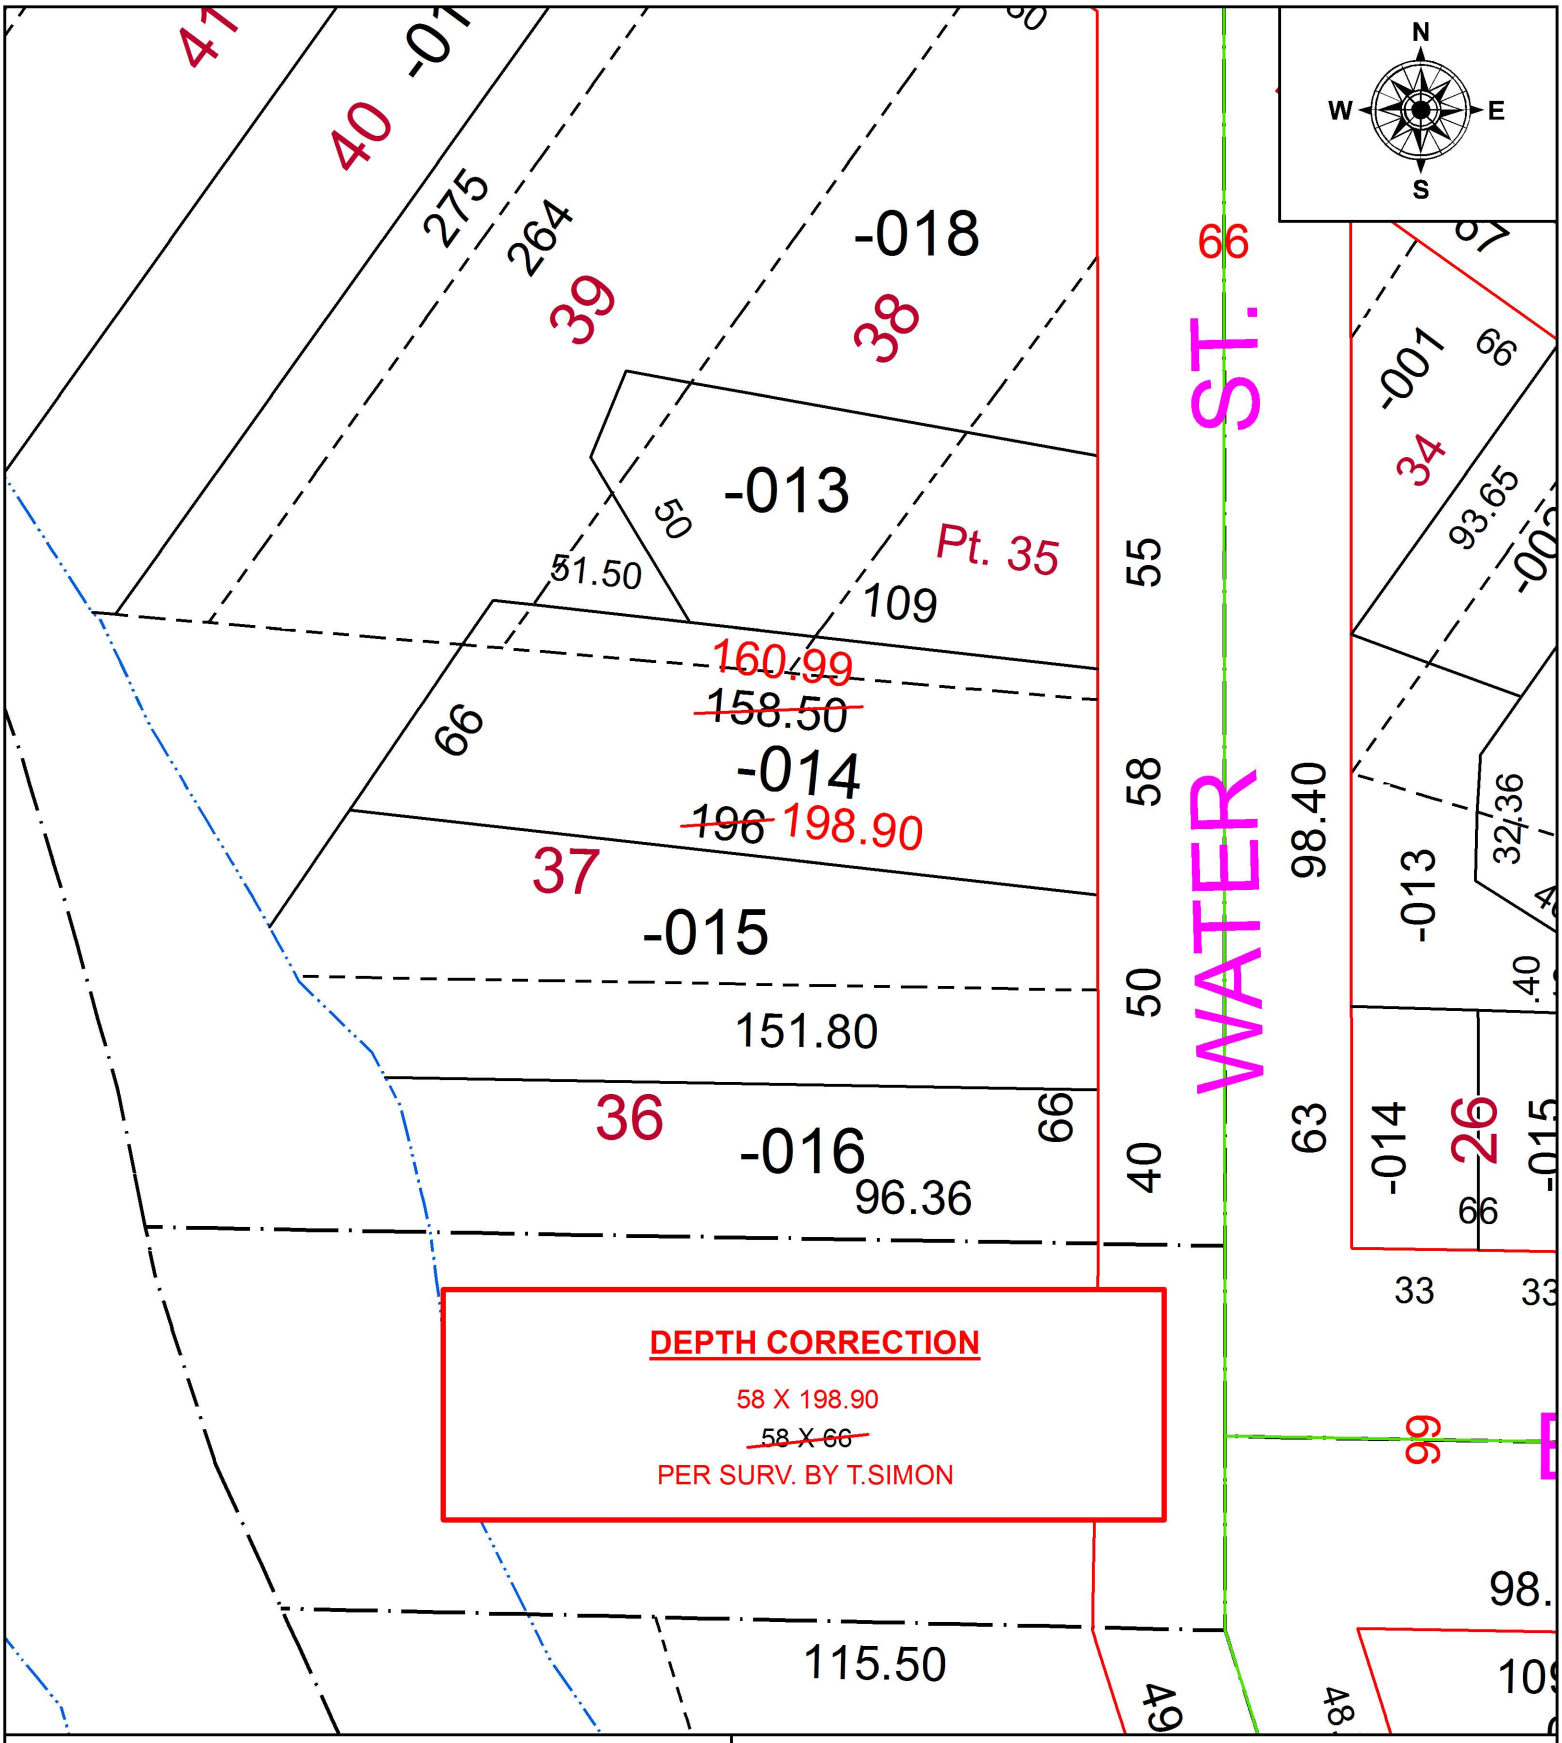

DEPTH CORRECTION

58 X 198.90

~~58 X 66~~

PER SURV. BY T.SIMON

SPLITS/DEEDS PROCESSED

LORAIN COUNTY TAX MAP DEPARTMENT
226 MIDDLE AVE. ELYRIA, OH

SURVEYED BY: THOMAS A. SIMON
CLOSURE: 1:221,957
MAP PAGE(S): 6-26-069
APPOVED BY: RRM **DATE:** 3-29-19
SCALE: 1" = 50 **PRIOR INSTRUMENT:** 20180669998