PARENT PARCEL: 03-00-058-102-025, -026, 03-00-059-000-035

CHILD PARCEL: 03-00-058-102-027 THRU -031, 03-00-059-000-037

STARTING POINT: INTERSECTION OF C/L OF ROOT RD. AND C/L OF COLORADO AVE.

19-04067

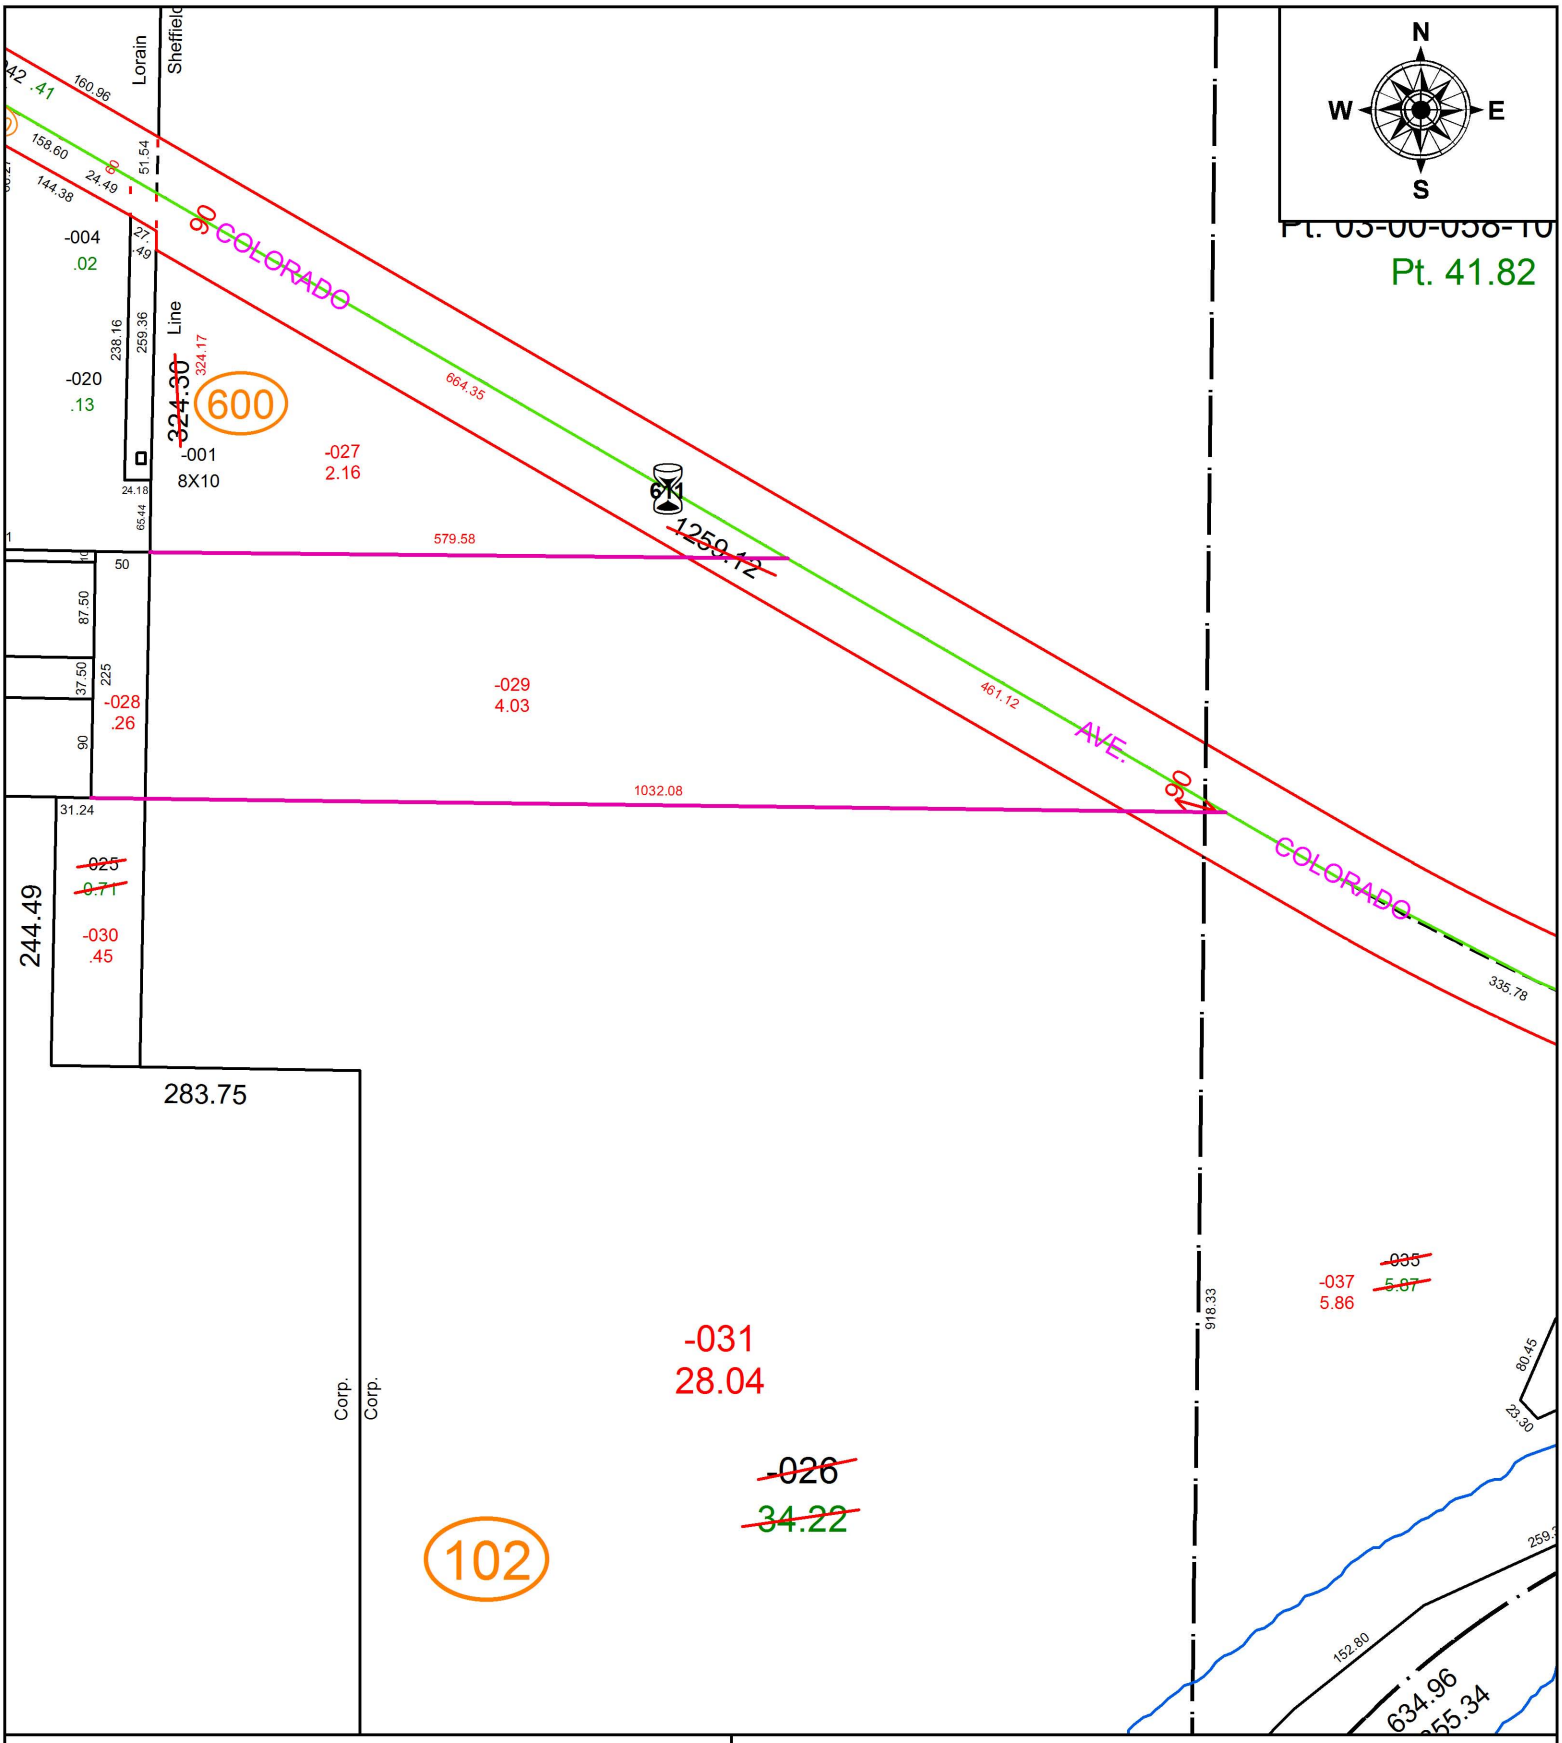

SPLITS/DEEDS PROCESSED

LORAIN COUNTY TAX MAP DEPARTMENT
226 MIDDLE AVE. ELYRIA, OH

SURVEYED BY: DOUGLAS A. HASEL
CLOSURE: 1:359,714
MAP PAGE(S): 3-00-058
APPOVED BY: RRM **DATE:** 12-16-19
SCALE: 1" = 175 **PRIOR INSTRUMENT:** 20190741297