PARENT PARCEL: 07-00-006-106-037, -039

CHILD PARCEL:

STARTING POINT: INTERSECTION OF C/L OF BARTON RD. AND C/L OF CENTER RIDGE RD.

19-04069-C

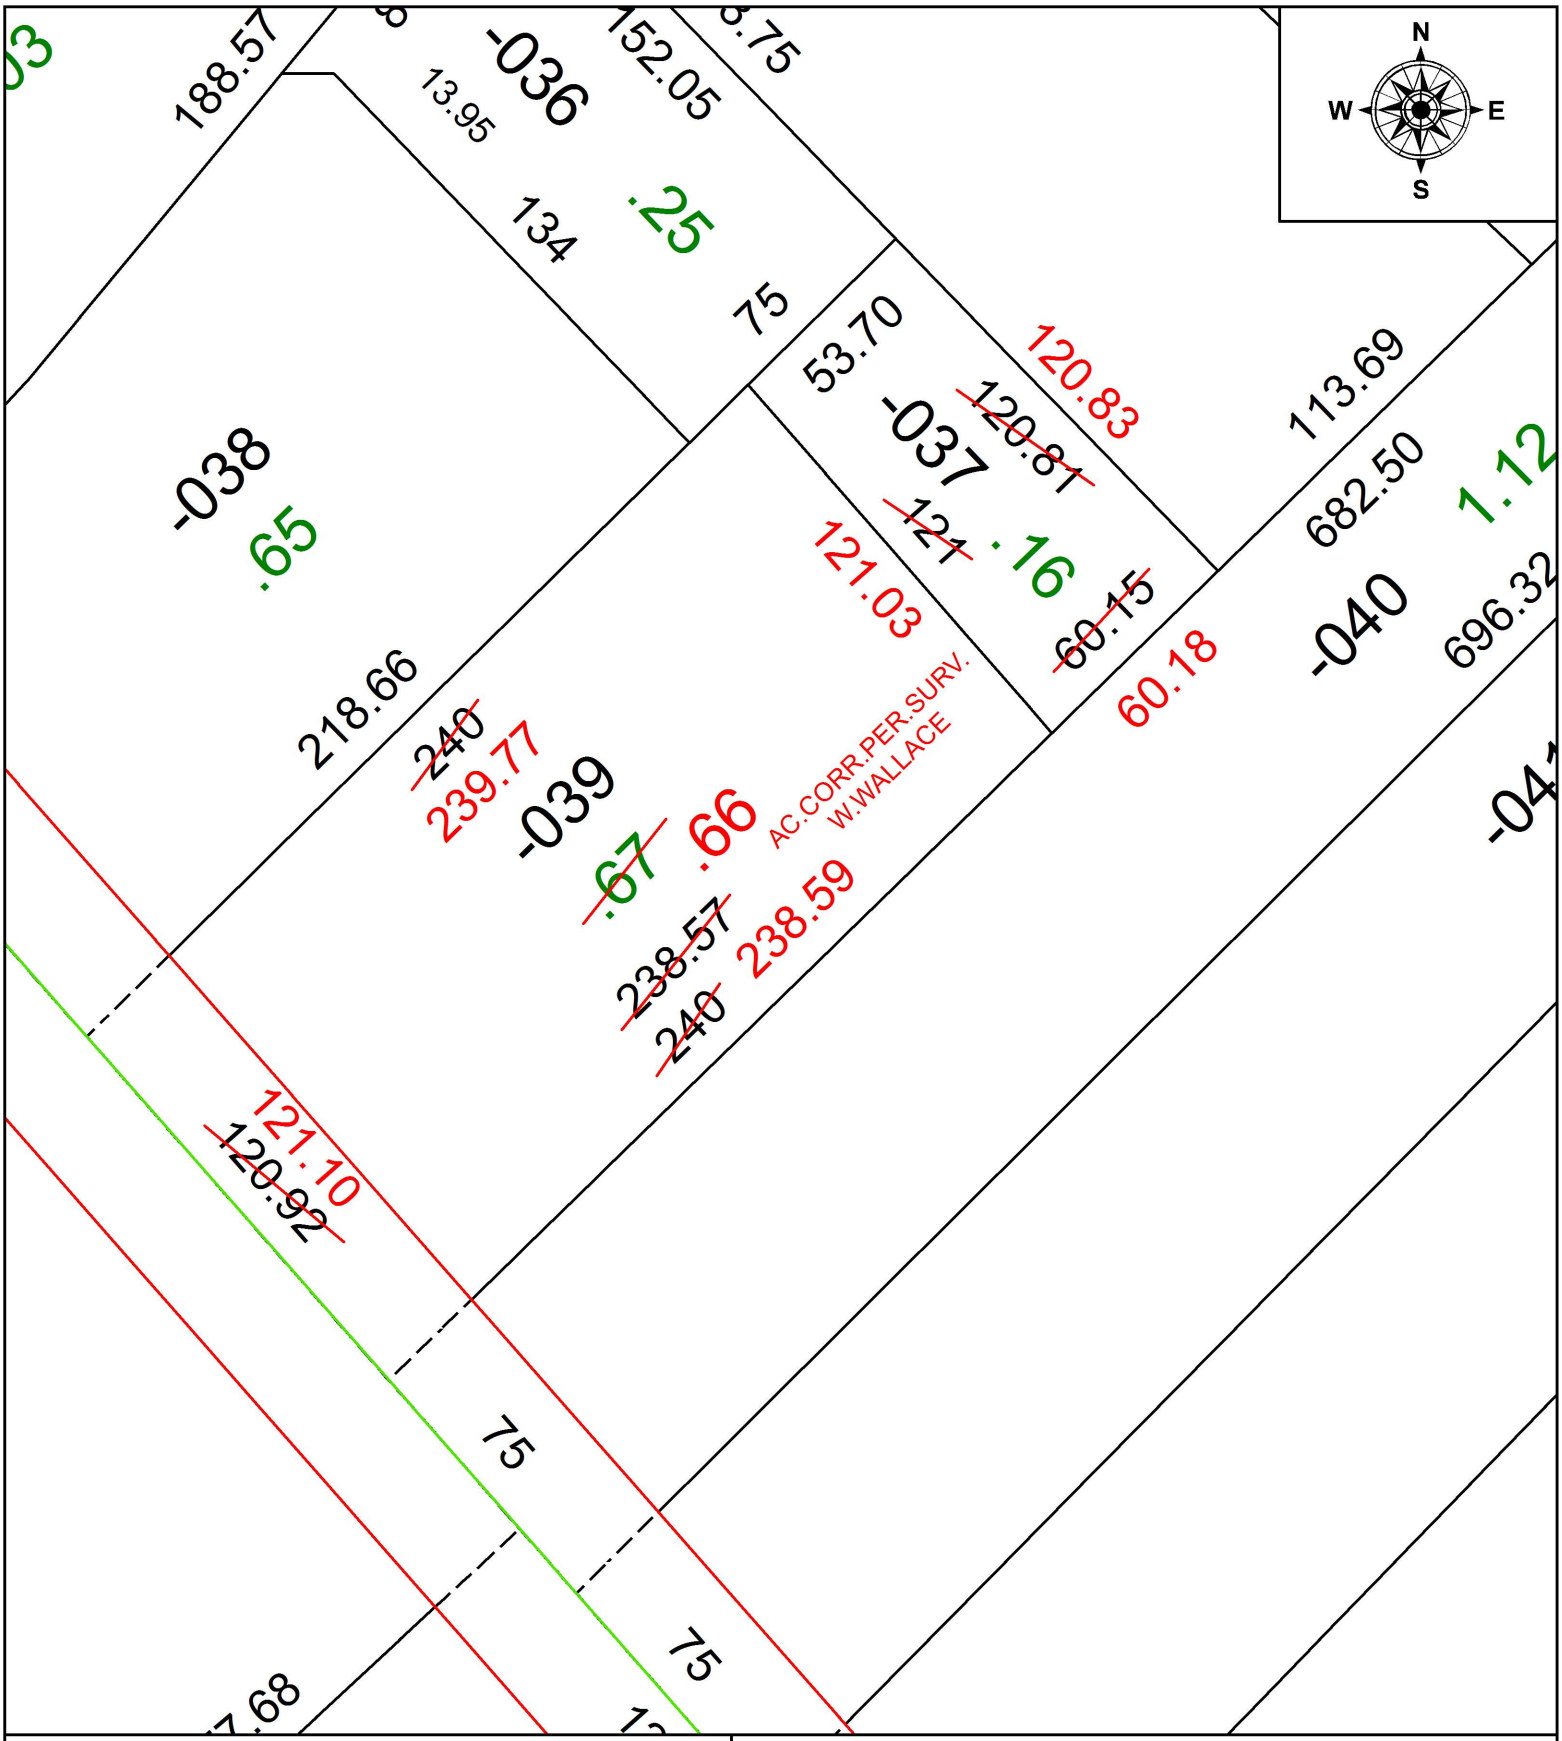

SPLITS/DEEDS PROCESSED

LORAIN COUNTY TAX MAP DEPARTMENT
226 MIDDLE AVE. ELYRIA, OH

SURVEYED BY: WILLIAM R. WALLACE
CLOSURE: 1: 23,423
MAP PAGE(S): 7-00-006
APPOVED BY: RRM **DATE:** 4-17-19
SCALE: 1" = 50 **PRIOR INSTRUMENT:** 20160611667