PARENT PARCEL: 04-00-012-101-011
CHILD PARCEL: ACREAGE CORRECTION
STARTING POINT: MAG. NAIL SET, CL OF STONEY RIDGE RD. & CL OF LONG RD.

19-04071-C

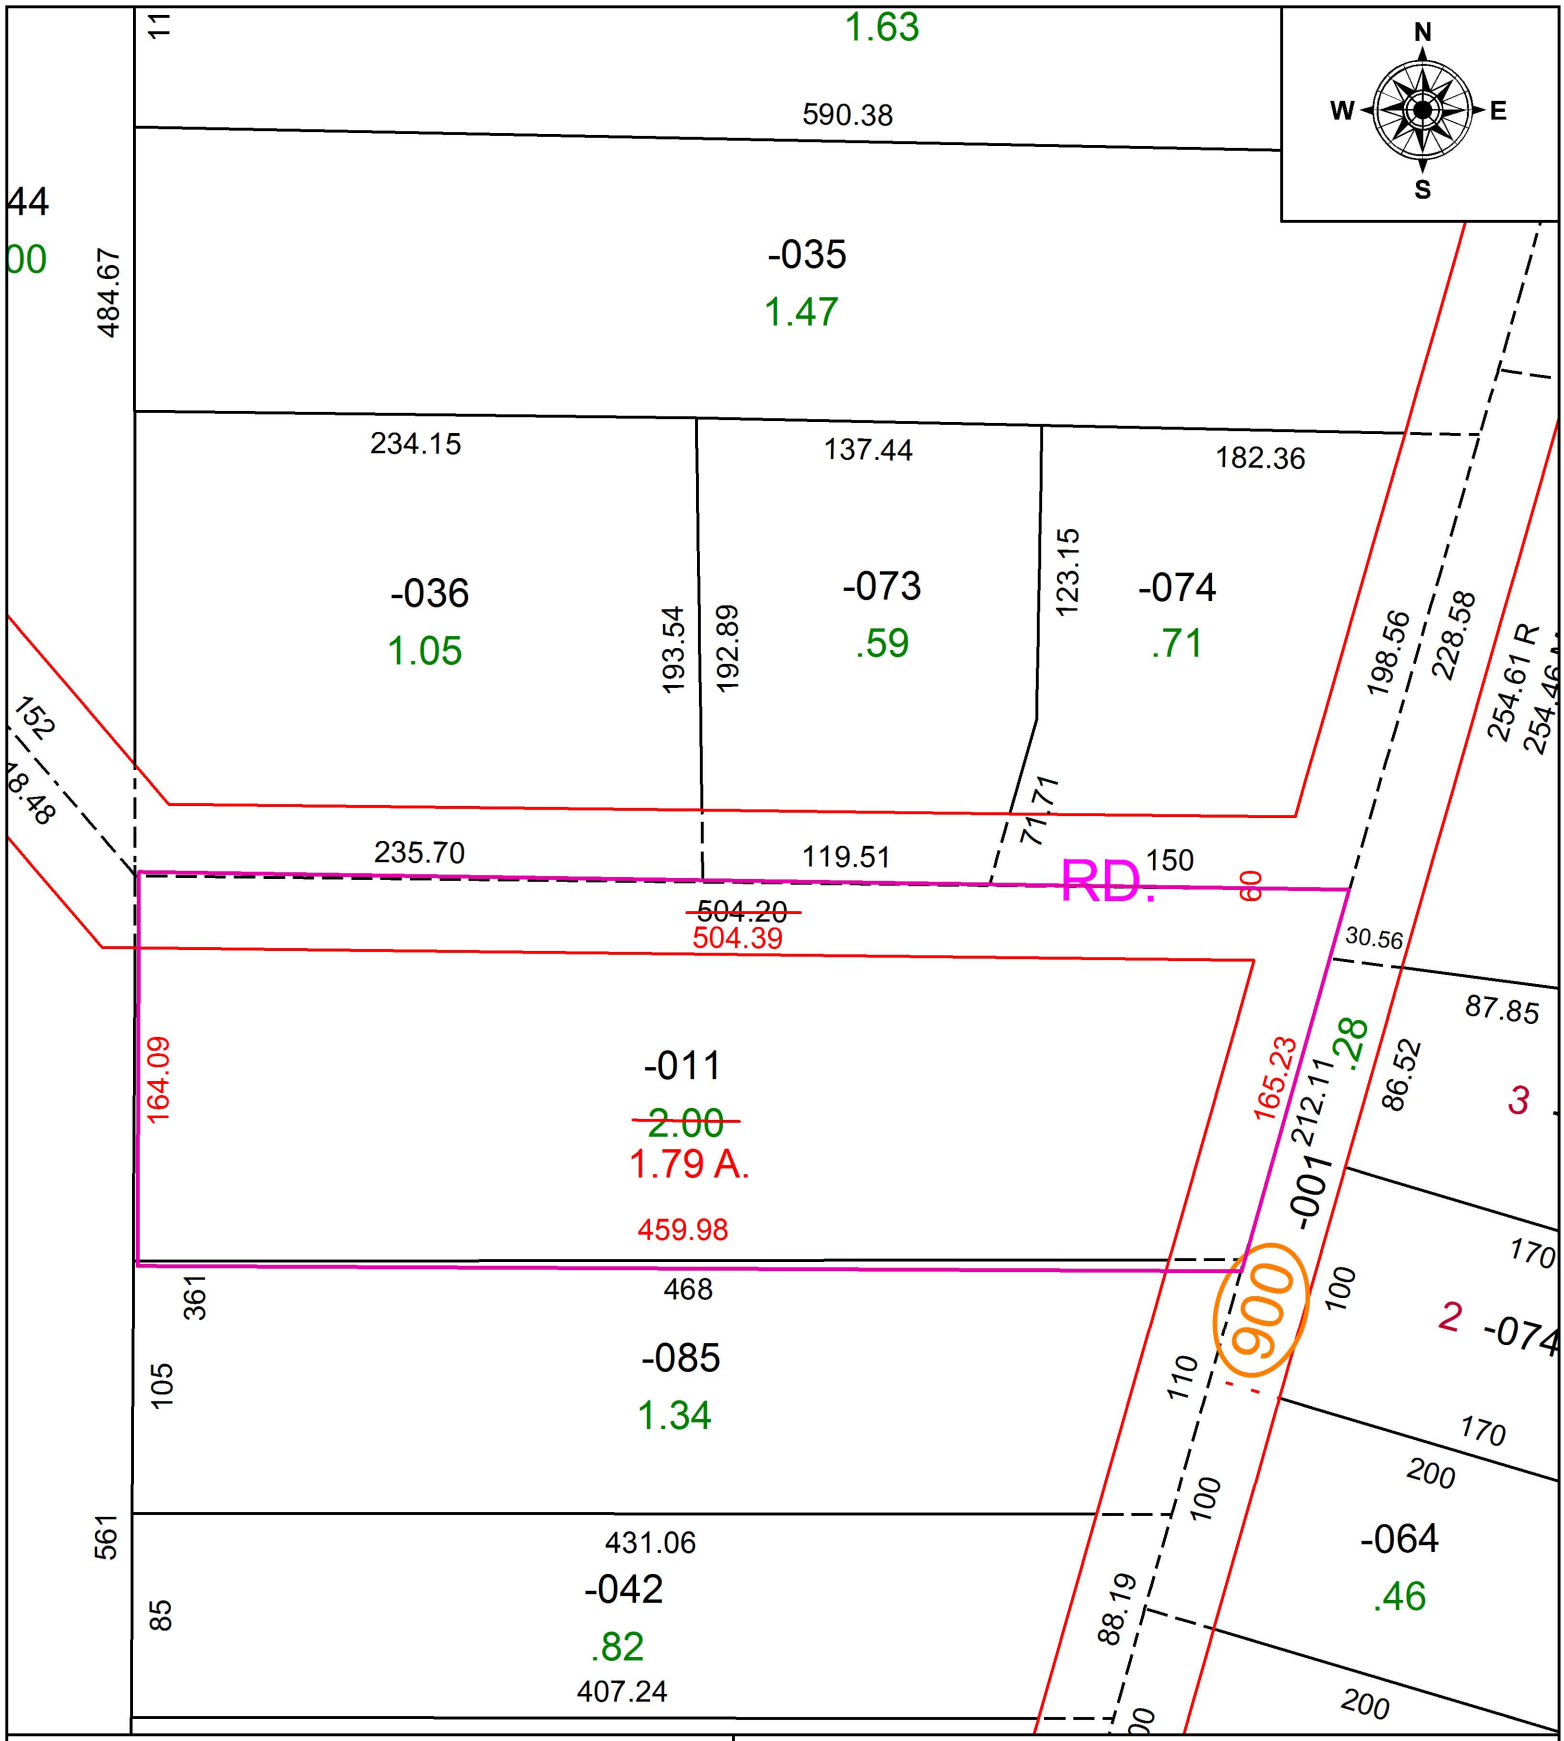

SPLITS/DEEDS PROCESSED
LORAIN COUNTY TAX MAP DEPARTMENT
226 MIDDLE AVE. ELYRIA, OH

SURVEYED BY: JAMES P. YURKSCHATT
CLOSURE: 1:177557
MAP PAGE(S): 04-00-012
APPOVED BY: TJS **DATE:** 4/12/19
SCALE: 1" = 80' **PRIOR INSTRUMENT:** DV. 1402 PG. 690