PARENT PARCEL: 04-00-028-102-067, -159

CHILD PARCEL:

STARTING POINT: INTERSECTION OF C/L OF AVON RD. AND C/L OF NAGEL RD.

19-04073-A

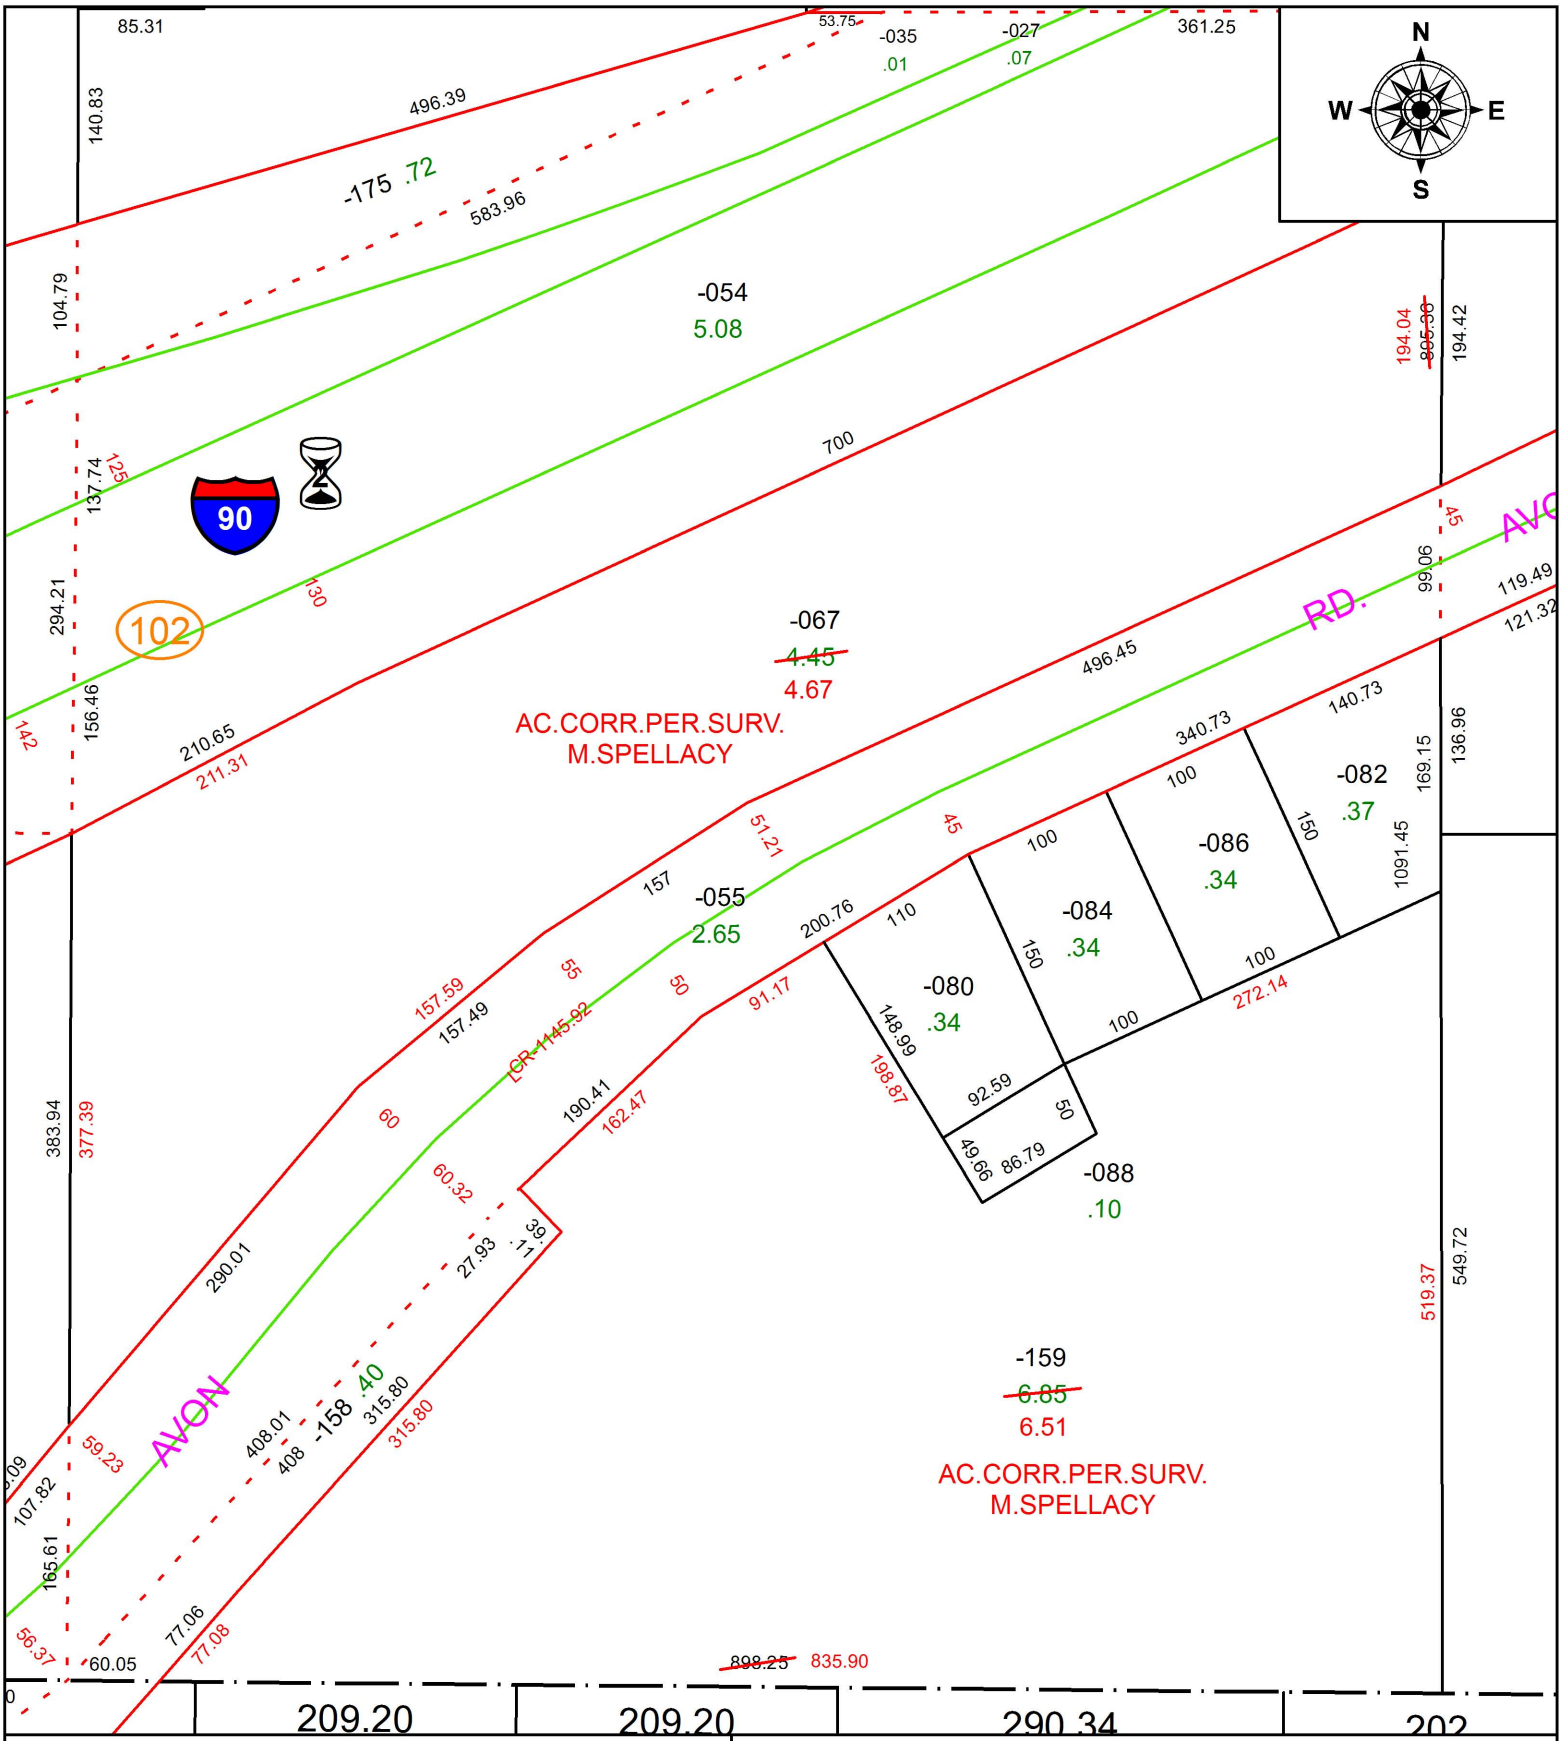

SPLITS/DEEDS PROCESSED

LORAIN COUNTY TAX MAP DEPARTMENT
226 MIDDLE AVE. ELYRIA, OH

SURVEYED BY: MICHAEL P. SPELLACY
CLOSURE: 1:463,405
MAP PAGE(S): 4-00-028
APPOVED BY: RRM **DATE:** 4-17-19
SCALE: 1" = 125 **PRIOR INSTRUMENT:** 20180657451